

APPLICATION

FOR PERCOLATION TESTING AND SITE EVALUATION

TEST DATE(S) _____ TEST TIME _____

AP 536651

AGENCY REVIEW: _____

DATE 11-29-11

DO NOT WRITE ABOVE THIS LINE

I HEREBY APPLY FOR THE NECESSARY TESTING/EVALUATION PRIOR TO ISSUANCE OF SEWAGE DISPOSAL SYSTEM PERMIT(S) TO:

CHECK AS NEEDED:

- ☐ CONSTRUCT NEW SEPTIC SYSTEM(S)
☒ REPAIR/ADD TO AN EXISTING SEPTIC SYSTEM
☐ REPLACE AN EXISTING SEPTIC SYSTEM

CHECK AS NEEDED:

- ☐ NEW STRUCTURE(S)
☐ ADDITION TO AN EXISTING STRUCTURE
☐ REPLACE AN EXISTING STRUCTURE

CHECK ONE:

- ☐ CREATE NEW LOT(S)
☐ BUILD ON AN EXISTING LOT IN A SUBDIVISION
☐ BUILD ON AN EXISTING PARCEL OF RECORD

IS THE PROPERTY WITHIN 2500' OF ANY RESERVOIR?

- ☐ YES
☐ NO

THE TYPE OF STRUCTURE IS

- ☒ RESIDENTIAL WITH 4 PROPOSED BEDROOMS IN THE COMPLETED STRUCTURE (NOTE UNKNOWN IF APPROPRIATE)
☐ COMMERCIAL (PROVIDE DETAIL OF NUMBERS AND TYPES OF EMPLOYEES/ CUSTOMERS ON ACCOMPANYING PLAN)
☐ INSTITUTIONAL/GOVERNMENT (PROVIDE DETAIL OF NUMBERS AND TYPES OF EMPLOYEES/USERS ON ACCOMPANYING PLAN)

PROPERTY OWNER(S) KEVIN + BARBARA HIGDEN

DAYTIME PHONE 301-461-7085 CELL 301-461-7085 FAX _____

MAILING ADDRESS 8494 Reservoir Rd Fulton MD 20759
STREET CITY/TOWN STATE ZIP

APPLICANT Kevin Higden

DAYTIME PHONE 301-461-7085 CELL _____ FAX _____

MAILING ADDRESS 8494 Reservoir Rd Fulton MD 20759
STREET CITY/TOWN STATE ZIP

APPLICANT'S ROLE: ☒ DEVELOPER ☐ BUILDER ☐ BUYER ☐ RELATIVE/FRIEND ☐ REALTOR ☐ CONSULTANT

PROPERTY LOCATION
SUBDIVISION/PROPERTY NAME Beaufort Park LOT NO. 4

PROPERTY ADDRESS Same
STREET TOWN/POST OFFICE


TAX MAP PAGE(S) _____ GRID _____ PARCEL(S) _____ PROPOSED LOT SIZE _____

AS APPLICANT, I UNDERSTAND THE FOLLOWING: THE SYSTEM INSTALLED SUBSEQUENT TO THIS APPLICATION IS ACCEPTABLE ONLY UNTIL PUBLIC SEWERAGE IS AVAILABLE. THIS APPLICATION IS COMPLETE WHEN ALL APPLICABLE FEES AND A SUITABLE SITE PLAN HAVE BEEN RECEIVED. I ACCEPT THE RESPONSIBILITY FOR COMPLIANCE WITH ALL M.O.S.H.A. AND "MISS UTILITY" REQUIREMENTS. APPROVAL IS BASED UPON SATISFACTORY REVIEW OF A PERC CERTIFICATION PLAN. TEST RESULTS WILL BE MAILED TO APPLICANT.

SIGNATURE OF APPLICANT

HOWARD COUNTY HEALTH DEPARTMENT, BUREAU OF ENVIRONMENTAL HEALTH, WELL AND SEPTIC PROGRAM
7178 COLUMBIA GATEWAY DRIVE COLUMBIA, MARYLAND 21046 (410) 313-2640 FAX (410) 313-2648
TDD (410) 313-2323 TOLL FREE 1-877-4MD-DHMH

(A)
6-8" om. silt
Br Heavy
CL.
slightly sticky
not very wet
2.5' Br./Rd. Loam,
Friable,
Somewhat Dry
L 10% sat
4-5' Wk silt
Wk 11/Gr. L.
Friable,
micaceous
5% silt
silt → wk platy
↓
10' Hd. Bottom from Res.

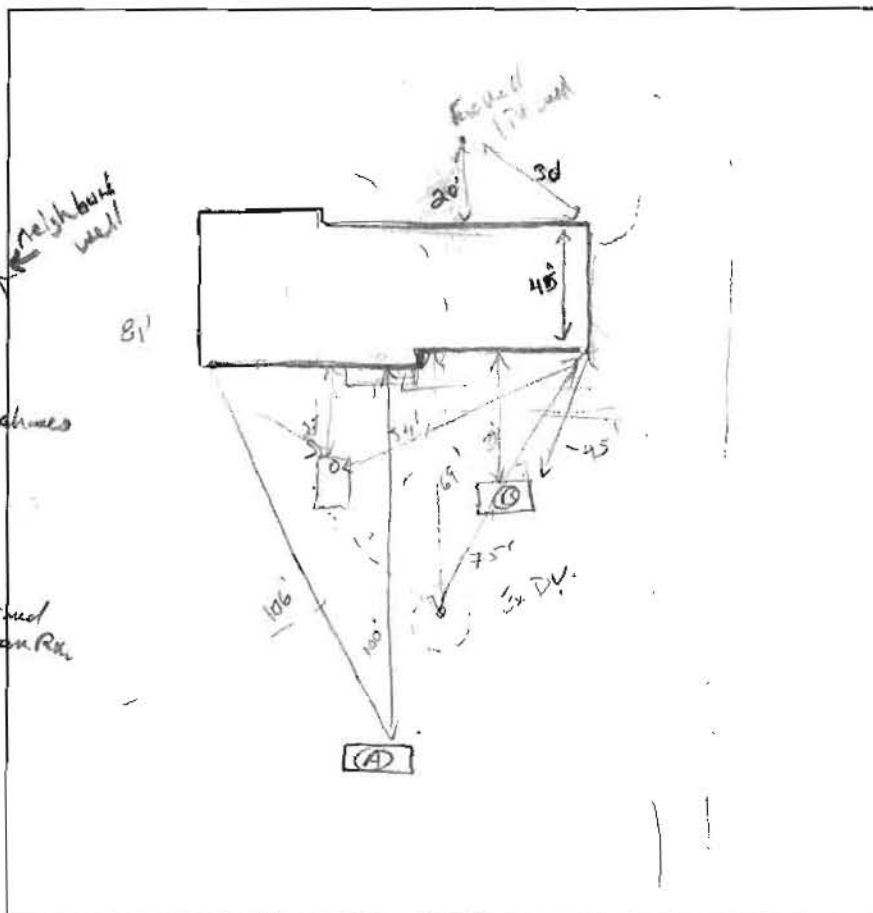

(B)
8" om. m silt
very sandy
Br/Rd CL-L.
20% clay,
Dry, wk plates
2.5' Rd/Br/Y L
m silt → wk platy
4' 10" % silt change
Br/Y L
Friable, Dry,
5% micaceous,
very wet.
10' 5-10% Sp.
L. - SL, low
Heavy micaceous
Dry. ↓
12'6"

DATE	TEST #	DEPTH	START	BREAK 1" DROP	STOP 2" DROP	TIME OF 2ND INCH	P/F/H
12/13/11	(A)	5'4" / 10'	10:58	11:01	11:05	4	P
		3'9"	11:14	11:24	11:43	19	P
	(B)	4'6" / 12'	11:28	11:34	11:48	14	P

REMARKS Restrette Perc @ bottom of yard - 10' → Rak In-cop. broke out of
or up hill.

SANITARIAN K. Wolf BACKHOE Jeff Allen OTHERS Helpin, owner

TEST HOLES USED IN SDA 2 AVG. PERC TIME 12 SQ. FT/BR 0.8

TRENCH WIDTH 2' INLET DEPTH MAX. BOT DEPTH EFFECTIVE S/W

$$4(150) = \frac{600}{0.8} = 750 \div 2 = 375 (.4) = 150 \text{ LF}$$

46, 50,
52

148 LF