

PUB. SEWER STATUS VERIFIED BY \_\_\_\_\_

ISSUE DATE: 3/10/08

APPROVAL DATE: 3/14/08

**PERMIT**

*Logged Into Permit Manager*  
TAX ID # 05-341507

**P 528537**

P ~~528529~~

A REPAIR

**ON-SITE SEWAGE DISPOSAL SYSTEM  
HOWARD COUNTY HEALTH DEPARTMENT  
BUREAU OF ENVIRONMENTAL HEALTH**

David E. Simonton

IS PERMITTED TO INSTALL ☐ ALTER ☒

ADDRESS: 8216 Reservoir Road, Fulton, MD 20759 PHONE NUMBER: 301-725-4436

SUBDIVISION: \_\_\_\_\_ LOT NUMBER: \_\_\_\_\_

ADDRESS: 8216 Reservoir Road PROPERTY OWNER: David Simonton

SEPTIC TANK CAPACITY (GALLONS): Existing Trenches 3' Wide  
PUMP CHAMBER CAPACITY (GALLONS): N/A Inlet 4.5'  
NUMBER OF BEDROOMS: 5 Bottom 6.5'  
SQUARE FEET PER BEDROOM: \_\_\_\_\_ 57' and 73' Trenches  
LINEAR FEET OF TRENCH REQUIRED: 130'

TRENCHES:	Trench to be _____ feet wide. Inlet _____ feet below original grade. Bottom maximum depth _____ feet below original grade. Effective area begins at _____ feet below original grade. _____ feet of stone below distribution pipe.
LOCATION:	
PURPOSE:	Existing septic system has failed. Call for inspection when ground is opened so sanitarian can recommend repair.

PLANS APPROVED: B. Baber

DATE: 3/13/08

NOTE: PERMIT VOID AFTER 2 YEARS

NOTE: CONTRACTOR RESPONSIBLE FOR SCHEDULING A PRE-CONSTRUCTION INSPECTION FOR ALL INSTALLATIONS


NOTE: WATERTIGHT SEPTIC TANKS REQUIRED

NOTE: ALL PARTS OF SEPTIC SYSTEM SHALL BE 100 FEET FROM ANY WATER WELL

NOTE: MANHOLE RISERS REQUIRED ON ALL SEPTIC TANKS AND PUMP CHAMBERS

**NEITHER THE HOWARD COUNTY COUNCIL OR THE HEALTH DEPARTMENT IS  
RESPONSIBLE FOR THE SUCCESSFUL OPERATION OF ANY SYSTEM  
PERMITTEE RESPONSIBLE FOR OBTAINING FINAL APPROVAL ON THIS PERMIT  
CALL 410-313-2640 FOR INSPECTION OF SEPTIC SYSTEM**

NOT TO SCALE

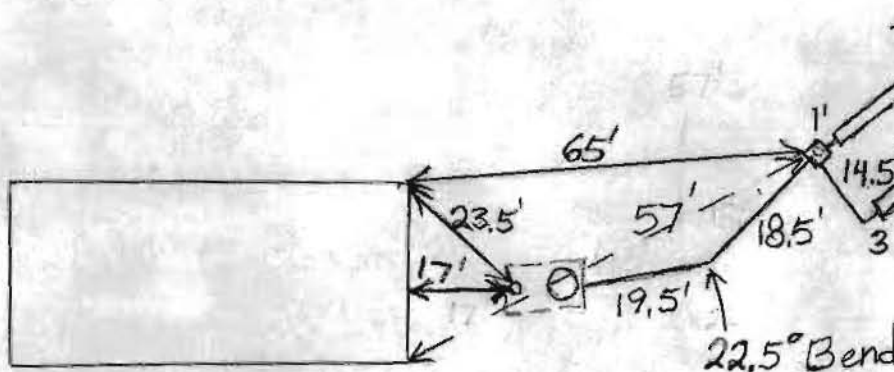

Reservoir

ROAD

TRENCH/DRAINFIELD DATA		
WIDTH	INLET	BOTTOM
3'	4.5'-5'	6.5'-7'
NUMBER OF TRENCHES		2
TOTAL LENGTH		130'
ABSORPTION AREA		390+Sidewall
DISTRIBUTION BOX LEVEL		Levelers
DISTRIBUTION BOX BAFFLE		Yes
DISTRIBUTION BOX PORT		Yes

SEPTIC TANK DATA	
SEPTIC TANK 1 LEVEL	Yes
CAPACITY	1250 or 1500
SEAM LOC	Midseam
TANK LID DEPTH	2'
BAFFLES	Yes
BAFFLE FILTER	No
MANHOLE LOC	Rear
6" PORT LOC	Front
WATERTIGHT TEST	No
SEPTIC TANK 2 LEVEL	N/A
CAPACITY	_____ GAL
SEAM LOC	_____
TANK LID DEPTH	_____
BAFFLES	_____
BAFFLE FILTER	_____
MANHOLE LOC	_____
6" PORT LOC	_____
WATERTIGHT TEST	_____

PRE-CONSTRUCTION 3/13/08 Pump out and fill in drywell.  
 INSTALLATION radius and towards the neighbor's property line. The upper trench should be about 57' in length and the lower trench should be about 73' in length. Keep the distribution box at least 100' from the well. (BB)  
 3/14/08 System installed. Drywell filled in. O.K. to backfill.

FINAL INSPECTOR B. Baker

DATE OF APPROVAL 3/14/08