

PERMIT

SEWAGE DISPOSAL SYSTEM

MARYLAND STATE DEPARTMENT OF HEALTH

HOWARD COUNTY
BUREAU OF ENVIRONMENTAL HEALTH
992-2330

INDEX

ELLICOTT CITY

DISTRICT

DATE 5/5/83

Bruce Grewell

IS PERMITTED TO INSTALL ☐ ALTER ☒

ADDRESS 8214 Reservoir Road, Fulton, MD 20759

PHONE 792-2757

SUBDIVISION ROAD 8214 Reservoir Rd

LOT

PROPERTY OWNER Bruce Grewell

ADDRESS Same as above

IF GARBAGE GRINDER IS USED INCREASE SEPTIC TANK CAPACITY BY 50% AND ABSORPTION AREA BY 22%.

GARBAGE GRINDER? YES ☐ NO ☐

SEPTIC TANK CAPACITY 1250 GALLONS

NUMBER OF BEDROOMS 4

REPAIR - CALL FOR INSPECTION WHEN GROUND IS OPENED UP SO SANITARIAN CAN RECOMMEND

REPAIR. 5/9/83 Discussed moving septic at least 10 ft from any part of bldg. ~~Tracing to see present disposal with~~
~~septic tank location~~. Will call for appointment later for installing trench & inspect new septic tank location.

5/10/83 New septic tank & trench system req'd to S.

5/17/83 Trench - 100' long, 12' deep, with 7' of stone -

PLANS APPROVED BY Palmer P. Wine DATE May 5, 1983

COVER NO WORK UNTIL INSPECTED AND APPROVED.

NEITHER THE HOWARD COUNTY COUNCIL NOR THE HEALTH DEPARTMENT IS RESPONSIBLE FOR THE SUCCESSFUL OPERATION OF ANY SYSTEM.

NOTE: IF TRENCH IS USED CALL FOR INSPECTION BEFORE AND AFTER PLACING GRAVEL IN TRENCH.

NOTE: NO DRY WELL SHALL EXCEED 15 FOOT IN DIAMETER. NO ABSORPTION TRENCH TO EXCEED 100 FEET IN LENGTH.

NOTE: ALL PIPE FROM HOUSE TO SEPTIC TANK MUST BE CAST IRON OR SCHEDULE 40 PVC OR ABS.

PERMIT VOID AFTER THREE YEARS.

NOTE: INSTALL STAND PIPE ON SEPTIC TANK AND DRY WELL. STAND PIPES MUST BE 6 INCHES IN DIAMETER. CAST IRON, CONCRETE OR TERRA COTTA, OR PVC OR ABS ACCEPTED. IF TOP OF SEPTIC TANK IS DEEPER THAN 3 FEET MANHOLE TO GRADE REQUIRED.


BLDG. PERMIT SIGNED
AND RETURNED 5/10/83

Serial # 53471 542

*INSTALLER IS RESPONSIBLE FOR OBTAINING FINAL APPROVAL ON THIS PERMIT

*CALL 992-2330 FOR INSPECTION OF SEPTIC SYSTEMS.

EH - 2-1082

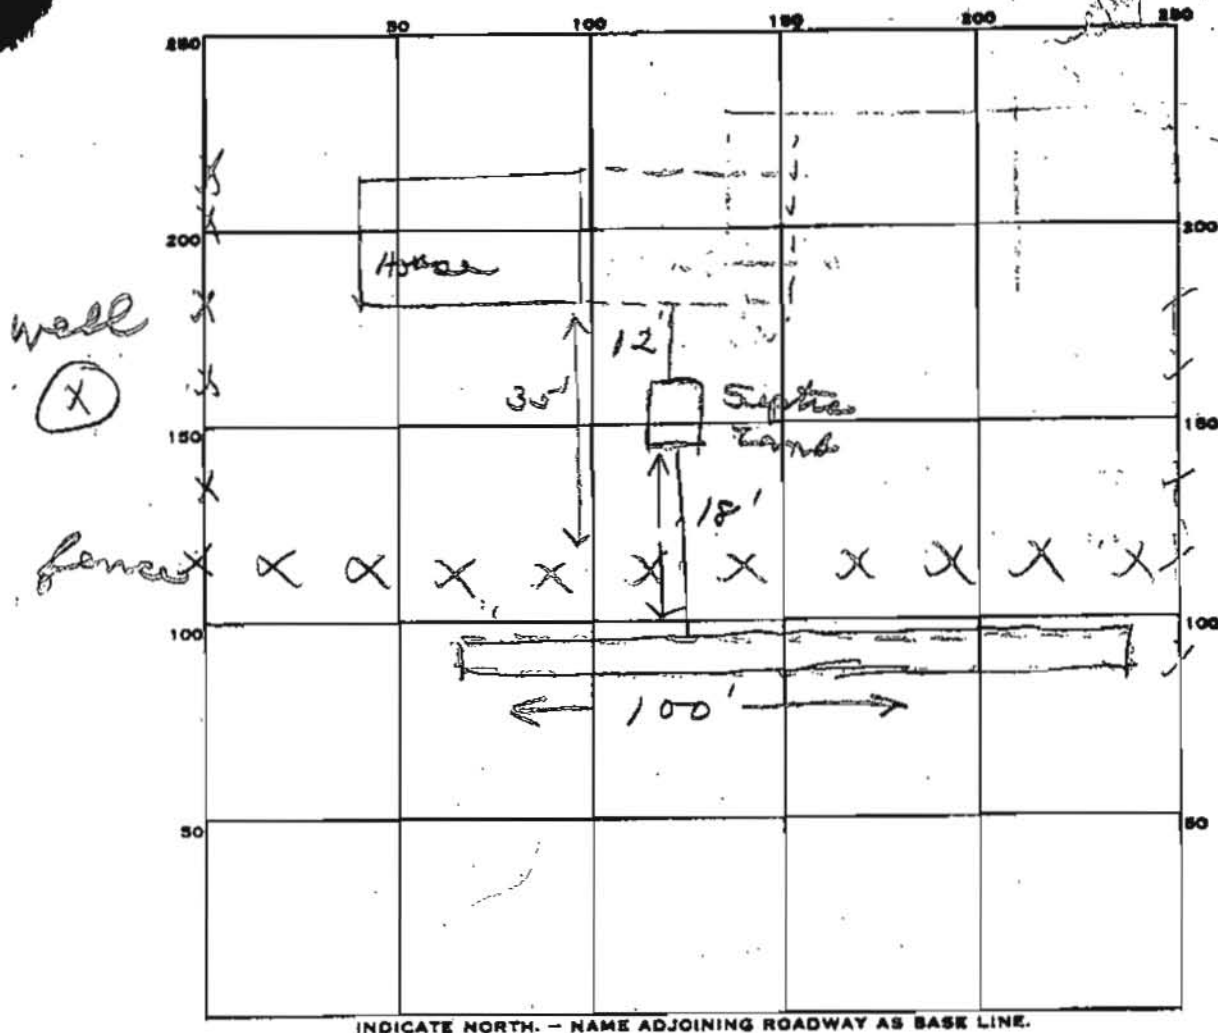

PERMIT CARD ✓

SEPTIC TANK, LEVEL ✓ 1500

CLEANOUTS ST. ✓

DISTRIBUTION BOX, LEVEL _____

TILE FIELD, DEPTH 10 FT. TRENCH WIDTH 2 FT.

GRAVEL DEPTH 7 IN. TOTAL LENGTH 100 FT.

NUMBER OF TRENCHES 1 TOTAL BOTTOM AREA 700

SEEPAGE PITS, INSIDE DIAMETER _____ FT. DEPTH BELOW INLET _____ FT.

ABSORBENT AREA 700 SQ. FT.


REMARKS 5/17/83 - 13 ft gravel dug - good soil, minor, and silt
6/16/83 OK to add stone in trench fs
6/16/83 OK to cover all work fs

DATE SYSTEM APPROVED 6/16/83

INSPECTOR Stoner

Approx 1/2 mile to main section
of Reservoir Rd
and Lime Kiln Rd

MAUCK PARK
ESTATES

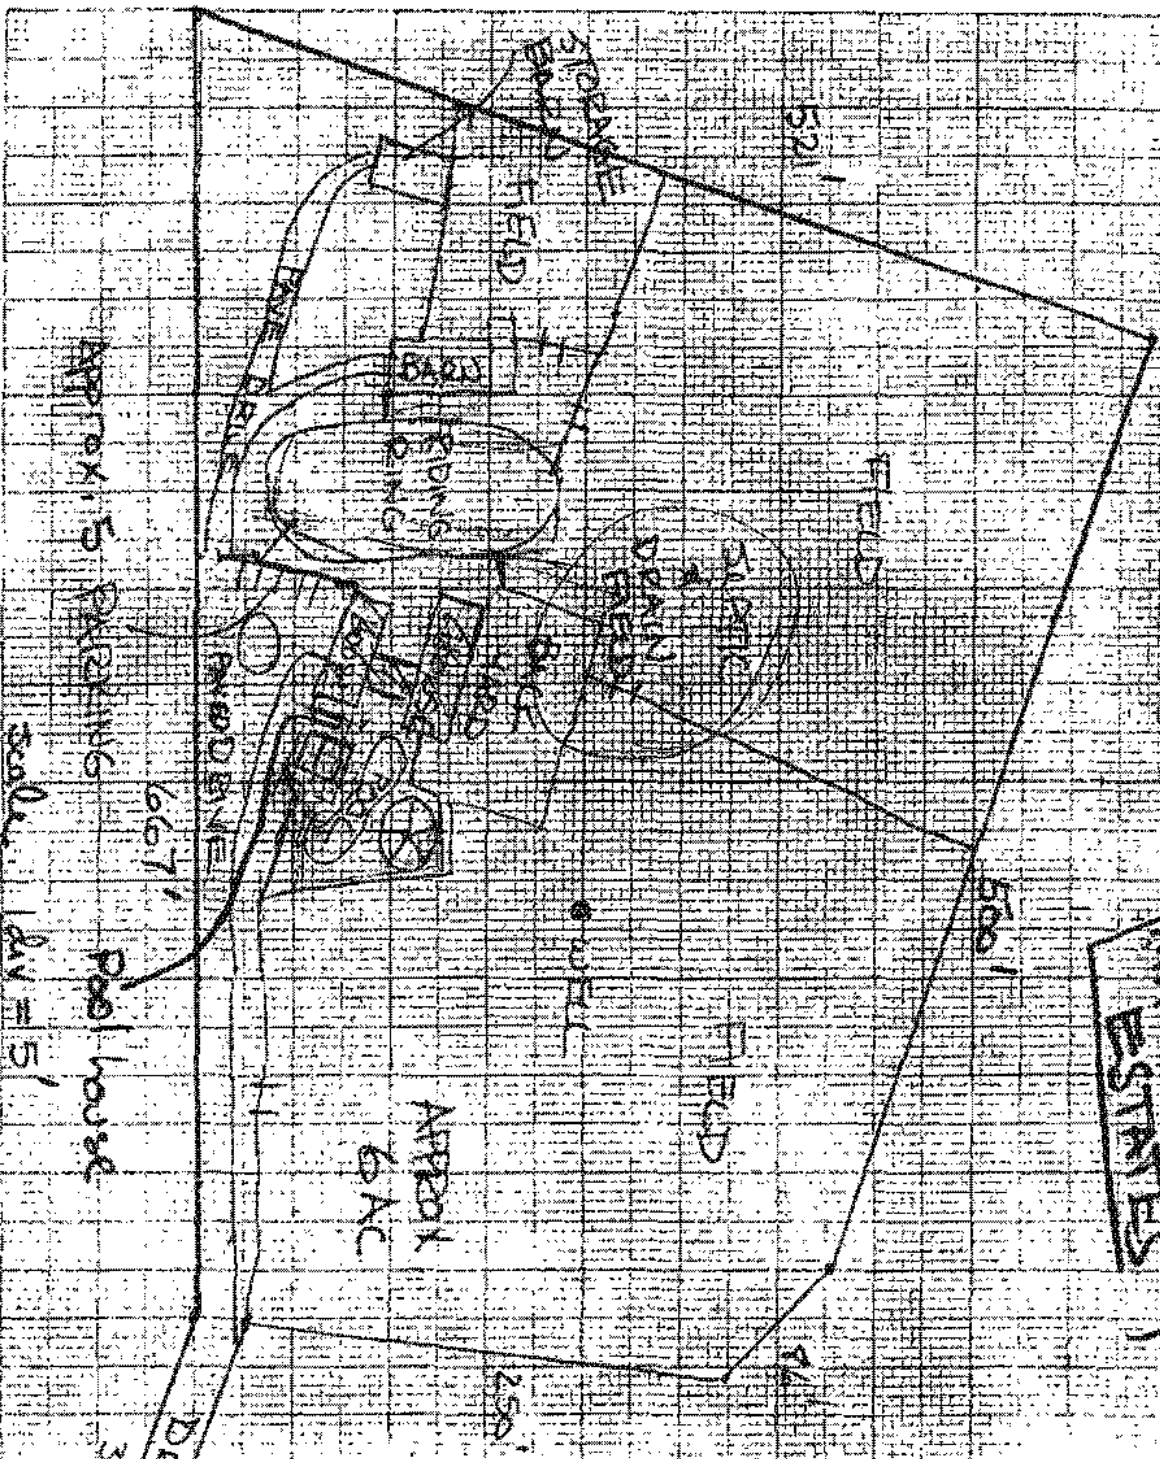

- 8214 Reservoir Rd
Fulton MO 20759

- MAP 45

- Grid 6

- Parcel 44

- Group 81

- ZONING RB

- All adjacent
property zoned
RP

- Plat Book 23

- S.O. 110 45

- Liber 3584

- S.O. 110 404

- Approx 330'

- to center line of
Reservoir Rd

DEWE 299'

325'

Common
drive

Approx. 5 buildings
Pool house

Scale 1 in = 5'

EH - 24

HOWARD COUNTY HEALTH DEPARTMENT

Bureau of Environmental Health

Ellicott City, Maryland 21043


Phone: 992-2330

5/5/83

To: MR. SKINNER

WE SPOKE LAST WEEK
REGARDING PERMIT # 53471.
I HAVE APPLIED FOR A
PERMIT TO ALTER THE SEPTIC
SYSTEM AT 8214 RESAOUR RD.
THE SYSTEM WILL BE UNCOVERED
FOR INSPECTION BY MONDAY.
IF IT IS CONVENIENT FOR
YOU, THE BUILDER, A BACKHOE
OPERATOR AND I WOULD LIKE
TO MEET YOU AT THE SITE ON

From: ED. STRETCH
Date: 5/9/83 @ 1 P.M. 539 3142

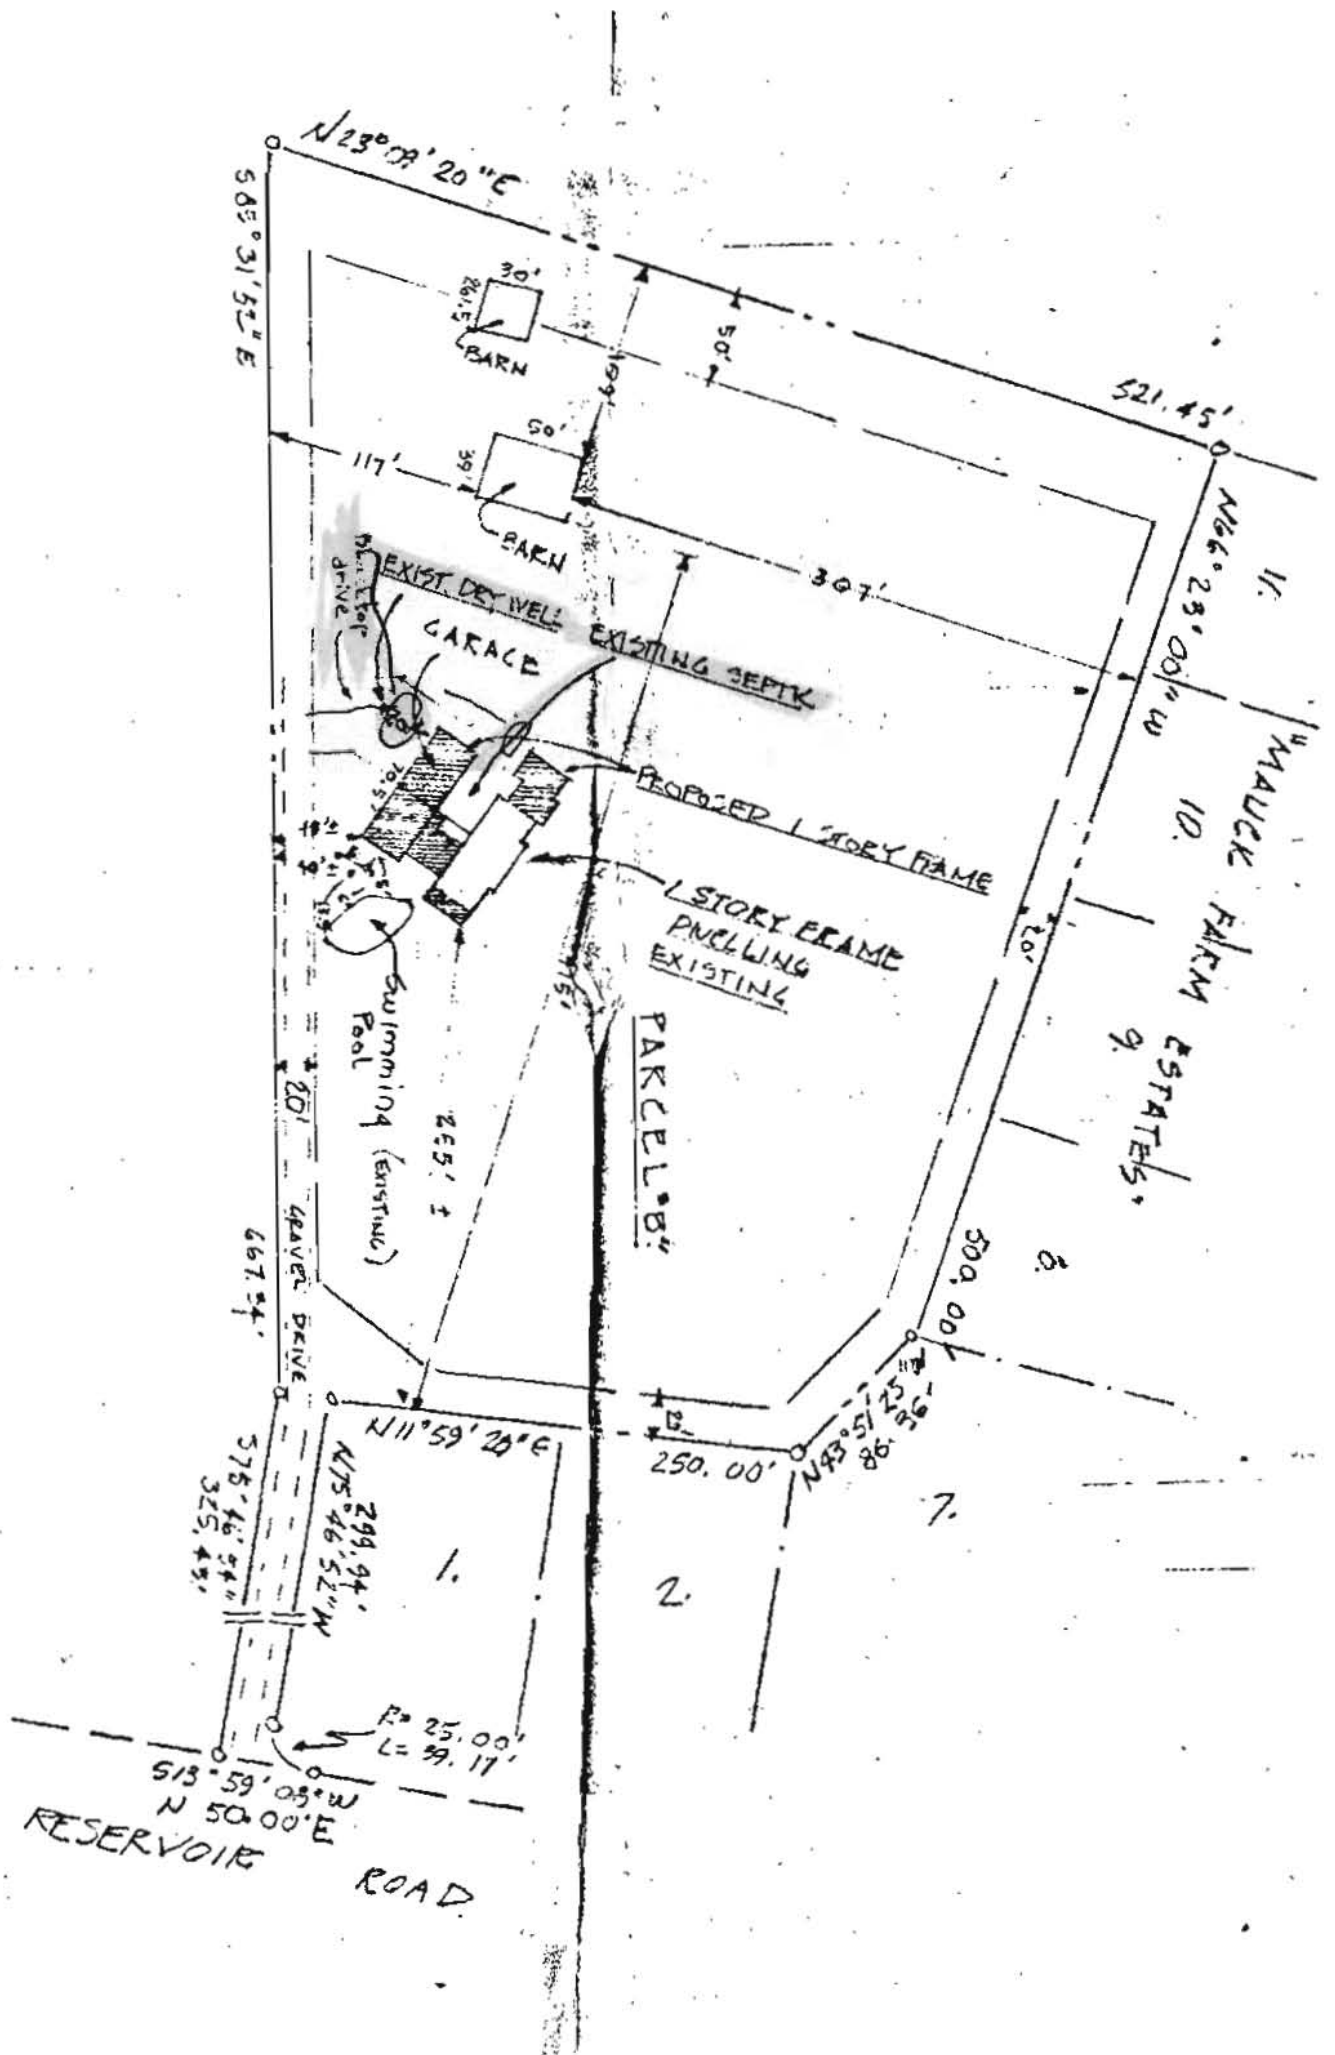

**Monument St. & Greenmount Ave.
Baltimore, Maryland 21202
727-0800**

ADDRESS

Permit # 32733

North F. Rose
795-4337
876-3446

SHIP TO

Bruce Grewell

8214 Reservoir Rd

DATE OF ORDER

DATE SHIPPED

TAX EXEMPT NO.

CREDIT
OK.D BY

OUR REF: #

CUSTOMER
ORDER NO.

JOB	NAME
-----	------

ORDER TAKEN BY	
-------------------	--

SALES OVERRIDE	
-------------------	--

[illegible]

ITEM NO.	QUANTITY ORDERED	QUAN. SHIP	ITEM DESCRIPTION	UNIT COST	UNIT SELL	SELL AMOUNT
5/10/83			Existing House			
5/10/83			Existing 1000 Gal Tank			
5/10/83			Proposed Man Hole 2'			
5/10/83			Existing 8" opening			
5/10/83			Proposed 3 Can Garage			
5/10/83			Replace Existing Fiber Pipe with Cast-Iron			
5/10/83			Replace Existing 4" C.P. with 6" Cast Iron w/ Brass Plug			
5/10/83			Existing Dry Well			

**MAYER BROS., INC.***Precast Concrete Products*

6264 Race Rd. Elkridge, MD 21075

Federal ID 52-0706744

Letter of Satisfaction
Hoot System InstallationAddress of Property: 8214 Reservoir Rd
Fulton MD 20759Date of Final Inspection: 8-7-09Installer: Garland BrionHoot Technician/Inspector: Ed McMillen

I hereby certify that the Hoot system installed at the property listed above has been installed according to proper Hoot installation practices. I also have verified the start up of the system and it is in proper working order.

Sincerely,


Name of Inspector
Mayer Bros., Inc.**BRIAN****HouCo HD****410-313-2648****Hopefully you get
it this time.****Thanks Ed**

PH: 410-796-1434

Fax: 410-796-1438

WBE

NPCA Certified

Grease Interceptors, Grease Solutions, ROOT Aerobic Treatment Units, Septic Tanks, E,
Manhole Vaults, Sectional Valve Vaults, Top Sinks, Catch Basins, Catch Bumpers, FernFest