

Building Permit Application
Howard County Maryland
Department of Inspections, Licenses and Permits
3430 Court House Drive
Permits: 410-313-2455
www.howardcountymd.cov

Permit No.: \_\_\_

<b>经国际人</b>								
Ruliding Address. 14	005	BI L BRAN	UCH TO	Property Owner's Name: 2	比许全包	0+115	A VALENT	7N6
				Address: 14005	1316-1	SEANIC	N OE.	1
Chy:	State	a: N D Zip Code: _	F1000	City: 1)	State:	_ Zip Cod	e: 2103/	*
Suite/Apt. #	SC	P/WP/BA#:		Phone: 3.1 23 22 65 8	1 5000	v•		
20 M Same				Email: RA VAL	ENDA	2010	IVALED.	601
Census Tract:				1 (				
Section:	Ar	ea:Lot:_	1	Applicant's Name & Mailing Applicant's Name:	Address, (If ot	hecthan state	d herein)	Large
Tay Man: 0027	7 Barnel	: 0141 Grid:	coals	Applicant's Name:	CON	BOTH	A Page Co	24.14
				Address: 19946	BYEF!	ರ್ಷ-೧೯೮	)	101
Zoning:	Map Coordin	ates: Lot S	ize:	City: HIGHLAND Phone: 240644	State:	Zip Co	de: 2. 072	
				Phone: 40644	42.78		132 4 100	
Existing Use: 5 #	~			Email: AAR-ON	SATA	3 KNE	TO CALLIER	14 -
Proposed Use: 5				Contractor Company: Dr	भारत ।	350010	LNBORN	ALI
Proposed Use:				Contact Person: AAQ	241 52	Constant	17. 3 (40.00)	6.5.
Estimated Construction (	Cost: \$	0,000		Address: 12946	13 7 50	137	572	
Description of Work:	Ban	1 DEMODE	51_					
Description of Work:	99° 1	1 1-16-2 12-1-4	- NAG	City: HIGH LANGE	te: Miss	_Zip Code:	2017	
				License No. : 11 14 (	4 15	476		
				Phone: 2466444	5 7 ax: _		-	
	821111	HED +LISA_	MAISTIN	PEmail: AARON	SATES	<b>医</b> 切配	( LOW AH	1600
Occupant/Tenant Name:	INC M	IKEN APIDE	A NICE STATE	٠				
Was tenant space previo	usiv occupied	d? □Yes	□No	Engineer/Architect Company			AT	
	50-100 <b>6</b> 10-714 151112 <b>6</b> 14100		- MAD		2:			
Contact Name:				Responsible Design Prof.;	_/_	_		
Address:		*		Address:	/			
			211		200			
city:		State: Zip Cod	a:	City:Sta	te:	∆ıp Code;		
Phone:		Fax:		Phone:	Fax:			
125 (5.00)				1				
Email:				Email:	-		- 66	
Commonded 2: Hall At	men mt s -2 -11	Double - Mai Do Ball	Champetowicking	(MD4)-		-	23 °C •	
Commercial Building Ch	aracteristics			<u>Utilities</u>	1			
Height:		SF Dwelling ☐ SF To			) No			
No. of stories:		Depth	Width	Gas: Silves C	] No	100 Yr 6	A	
Gross area, sq. ft./floor:		1" floor: LLO		Water Supply			***	
1		2 <sup>nd</sup> floor: 1 n	100	☐ Public			45 7636	
Area of construction (sq.	rt.):	Basement: (3.5	40	☑ Private	- +			
1		☐ Finished Basement				·, ·		
Use group:		☐ Unfinished Basemer		Sewdae Disposo	<u>u</u>			
		Crawl Space		☐ Public		-		
Construction type:		☐ Slab on Grade		⊠Private		×, ·		
Reinforced Concrete		No. of Bedrooms:		Heating System	i i	78.5	M <sub>E</sub>	
Structural Steel		Multi-family D	116.00	Selectric □ Oil				
Masonry		No. of efficiency units:					170	
☐ Wood Frame		No. of 1 BR units:			e Gas		- 3	
☐ State Certified Modular		No. of 2 BR units:		☐ Other:				
		No. of 3 BR units:		Sprinkler System	E	14.4	1 7. 1	
A 454		Other Structure:		☐ Yes ⊠No				
		Dimensions:		100		No. of the	, a c	
Roadside Tree Proje	ct Permit	Footings:		Conductor of	Number	- '		
□Yes	□No .	Roof:		Grading Permi	wanner:			
Roadside Tree Project Permit #		State Certified Mod	ular					
13976		☐ Manufactured Hom	e	Building Shell Perm	nit Number:	<u> </u>		
WITH ALL REGULATIONS OF HON	WARD COUNTY	WHICH ARE APPLICABLE THERET	O; (4) THAT HE/SHE W	MAKE THIS APPLICATION; (2) THAT THE INI JUL PERFORM NO WORK ON THE ABOVE !	EFERENCED PROP	ERTY NOT SPECIFIC	ALLY DESCRIBED IN	
THIS APPLICATION; (5) THAT HE!	SHEARANTS CO	UNTY OFFICIALS THE RIGHT TO EI	VIEW ONTO THIS PROP	ERTY FOR THE PURPOSE OF INSPECTING TH	A VIORE PERMITT	DAND YOSTING N	Unices.	
Applicant's Signature	isali		- p.	int Name	71 100 2	<i>u</i>		
	-			1.1.1.				
AARON B	的答	CIVED GMAI	L.com_	11/16/17				
Email Address		1	Dó	те ,				
<u> </u>			20					
Title/Company					54			
		Checks Payable	to: DIRECTOR OF F	NANCE OF HOWARD COUNTY				
			PLEASE WRITE NEA					
22			-FOR OFFICE		1400 Eq.	÷		
	T T		DD7 STTDACU	INFORMATION	Filing Fee	\$		
AGENCY	DATE S	IGNATURE OF APPROVAL	Fronts	III Spinstion	Permit Fee	\$		
State Highways			Rear	400	Tech fee	5		
Bullding Officials			Side:		Excise Tax	. 5		
	-		Side St.:		PSF5	\$		
PSZA (Zoning)				setbacks met?	Guaranty Fu	-		
-PSZA (Engineering)				ermit Required?   Yes   No	Add'I per Fee			
	1	ton a National	1 Make de Distrik		Total Fees	\$		
Health	1 11 111	IT HOSWA	47					

Distribution of Copies: White: Building Officials

Health

IS Sediment Control approval required for Issuance? 

Yes 
No
CONTINGENCY CONSTRUCTION START

Green: PSZA,Zoning

Yellow: PSZA,Engineering

Lot Coverage for New Yown Zone: SDP/Red-line approval date:


Check Pink: Health

Total Fees Sub- Total Paid


**Balance Due** 

\$

Gold: SHA

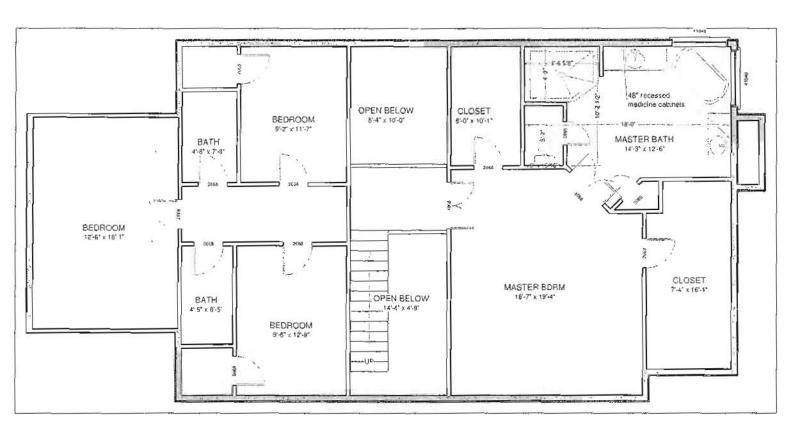

## SECOND FLOOR PLAN

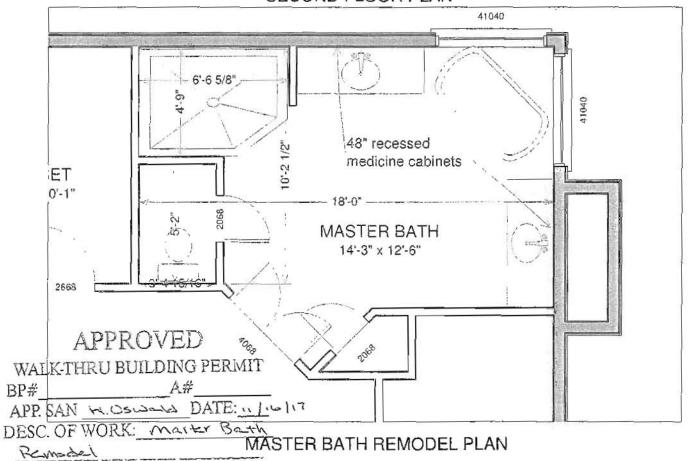

CONTRACTOR:

BATES REPAIR AND RENOVATION LLC
12946 BYEFIELD RD. HIGHLAND MD 20777 240 644 4548
DESIGNER CONTACT: BRUCE BATES 301 617 0164
brucebates6@gmail.com

VALENTINE
MASTER BATH REMODEL
14005 BIG BRANCH DR
DAYTON MD, 21036

SECOND FLOOR PLAN