

HOWARD COUNTY PERMIT APPLICATION

PERMIT NUMBER

1206000018

Building Address 8512 RESERVOIR RD.
FULTON, MD 20759
Suite/Apt. #: _____ SDPWP/Petition #: _____
Census Tract 6051.02 Subdivision BEAUFORT PARK
Section _____ Area _____ Lot 2
Tax Map 45 Parcel 46 Grid 12
Zoning RR-DEO Map Coordinates _____ Lot size _____

Property Owner's Name ROBERT J PATRICIA SHANKIN
Address 8512 RESERVOIR RD
City FULTON State MD Zip Code 20759
Home Phone _____ Work Phone _____
Applicant's Name & Mailing Address, (If other than stated hereon):
Phone 301 725-8018 Fax _____

Existing Use SINGLE FAMILY DWELLING
Proposed Use SPACED A ARCHITECTURAL UTILITIES
Estimated Construction Cost \$ 150,000.00
Description of Work 350' S.E. GROVE LUM, BAY
LANDSCAPE, EXTERIOR PATH, REPLANT LUMBER
CADUATS 7 TFS

Contractor Company T.W. BOYS CO. INC.
Contact Person MARY PIRUINI
Address 14777 ADDISON WAY
City WOODBINE State MD Zip Code 21797
License No. _____
Phone 410 982-6570 Fax 410 982-6571

Occupant or Tenant _____
Contact Name _____
Address _____
City _____ State _____ Zip Code _____
Phone _____ Fax _____

Engineer or Architect Company _____
Contact Person _____
Address _____
City _____ State _____ Zip Code _____
Phone _____ Fax _____

BUILDING DESCRIPTION - COMMERCIAL

BUILDING DESCRIPTION - RESIDENTIAL

Building Characteristics	Utilities
Height: _____	Water Supply: _____ Public _____ Private _____
No. of stories: <u>1</u>	Sewage Disposal: _____ Public _____ Private _____
Gross area, sq. ft. per floor: _____	Electric Yes ☐ No ☐ Gas Yes ☐ No ☐
Use group: _____	Heating System: _____ Electric ☐ Oil ☐ Natural Gas ☐ Propane Gas ☐
Construction type: _____ Reinforced Concrete _____ Structural Steel _____ Masonry _____ ☒ Wood Frame _____ State Certified Modular _____	Sprinkler system: <u>N/A</u> ☐ Full _____ Partial _____ Other Suppression _____ # of Heads _____

Building Characteristics	Utilities
SF Dwelling ☒ SF Townhouse ☐ Depth <u>19</u> Width <u>18</u> 1st floor: _____ 2nd floor: _____ Basement: _____ Finished Basement ☐ Unfinished Basement ☐ Crawl space ☒ Slab on Grade ☐ No. of Bedrooms: _____ Height: <u>17</u> Multi-family dwellings: _____ No. of efficiency units: _____ No. of 1 BR units: _____ No. of 2 BR units: _____ No. of 3 BR units: _____ Other Structure: _____ Dimensions: _____ Footings: _____ Roof Height: _____ State Certified Modular _____ Manufactured Home _____	Water Supply: _____ Public _____ Private ☒ Sewage Disposal: _____ Public _____ Private ☒ Electric Yes ☒ No ☐ Gas Yes ☐ No ☐ Heating System: _____ Electric ☐ Oil ☐ Natural Gas ☐ Propane Gas ☒ Sprinkler system: <u>N/A</u> ☒ NFPA #13D _____ NFPA #13R _____ Other: _____

THE UNDERSIGNED HEREBY CERTIFIES AND AGREES AS FOLLOWS: (1) THAT HE/SHE IS AUTHORIZED TO MAKE THIS APPLICATION; (2) THAT THE INFORMATION IS CORRECT; (3) THAT HE/SHE WILL COMPLY WITH ALL REGULATIONS OF HOWARD COUNTY WHICH ARE APPLICABLE THERE TO; (4) THAT HE/SHE WILL PERFORM NO WORK ON THE ABOVE REFERENCED PROPERTY NOT SPECIFICALLY DESCRIBED IN THIS APPLICATION; (5) THAT HE/SHE GRANTS COUNTY OFFICIALS THE RIGHT TO ENTER ON TO THIS PROPERTY FOR THE PURPOSE OF INSPECTING THE WORK PERMITTED AND POSTING NOTICES.

Applicant's Signature [Signature]
Title/Company PAIS / T.W. BOYS CO. INC.

Print Name MARY G. PIRUINI
Date 6/19/06

Checks payable to: **DIRECTOR OF FINANCE OF HOWARD COUNTY**
** PLEASE WRITE NEATLY AND LEGIBLY. **
- FOR OFFICE USE ONLY -


AGENCY	DATE	SIGNATURE APPROVAL	DPZ SETBACK INFORMATION	PROPERTY ID#
Land Development DPZ			Front: _____	Filing fee \$ _____
State Highways			Rear: _____	Permit fee \$ _____
Building Official			Side: _____	Excise tax \$ _____
Dev. Engineering DPZ			Side St.: _____	Add'l per. fee \$ _____
Health	<u>7/13/06</u>	<u>[Signature]</u>	All minimum setbacks met? YES ☐ NO ☐	TOTAL FEES \$ _____
Fire Protection			Is Entrance Permit required? YES ☐ NO ☐	Sub-total paid \$ _____
Is Sediment Control approval required prior to issuance?				Balance due \$ _____
YES ☐ NO ☐				Check # <u>13628</u>
CONTINGENCY CONSTRUCTION START: ☐			Historic District? YES ☐ NO ☐	Validation # _____
ONE STOP SHOP: ☐			Lot Coverage for NewTown Zone _____	
Distribution of Copies: _____	White: Building Official	Green: LDD, DPZ	SDP/Red-line approval date _____	Accepted by _____
T:\norma\PERMIT.FRM			Yellow: DED, DPZ	Pink: Health
				Gold: SHA

APPROVED

BUILDING PERMIT

BP# B06000078 A# 17210
 APP. SAN GAC DATE: 7/13/06
 DESC. OF WORK: 350 sqft great room
 Bay Window & Interior Work

Subject property is shown in Zone C
 on the National Flood Insurance Program
 Flood Insurance Rate Map of 40-0000
 County, Maryland. Panel# 1
 Community Panels 2436-1-1-1
 Effective Date: 07/01/97

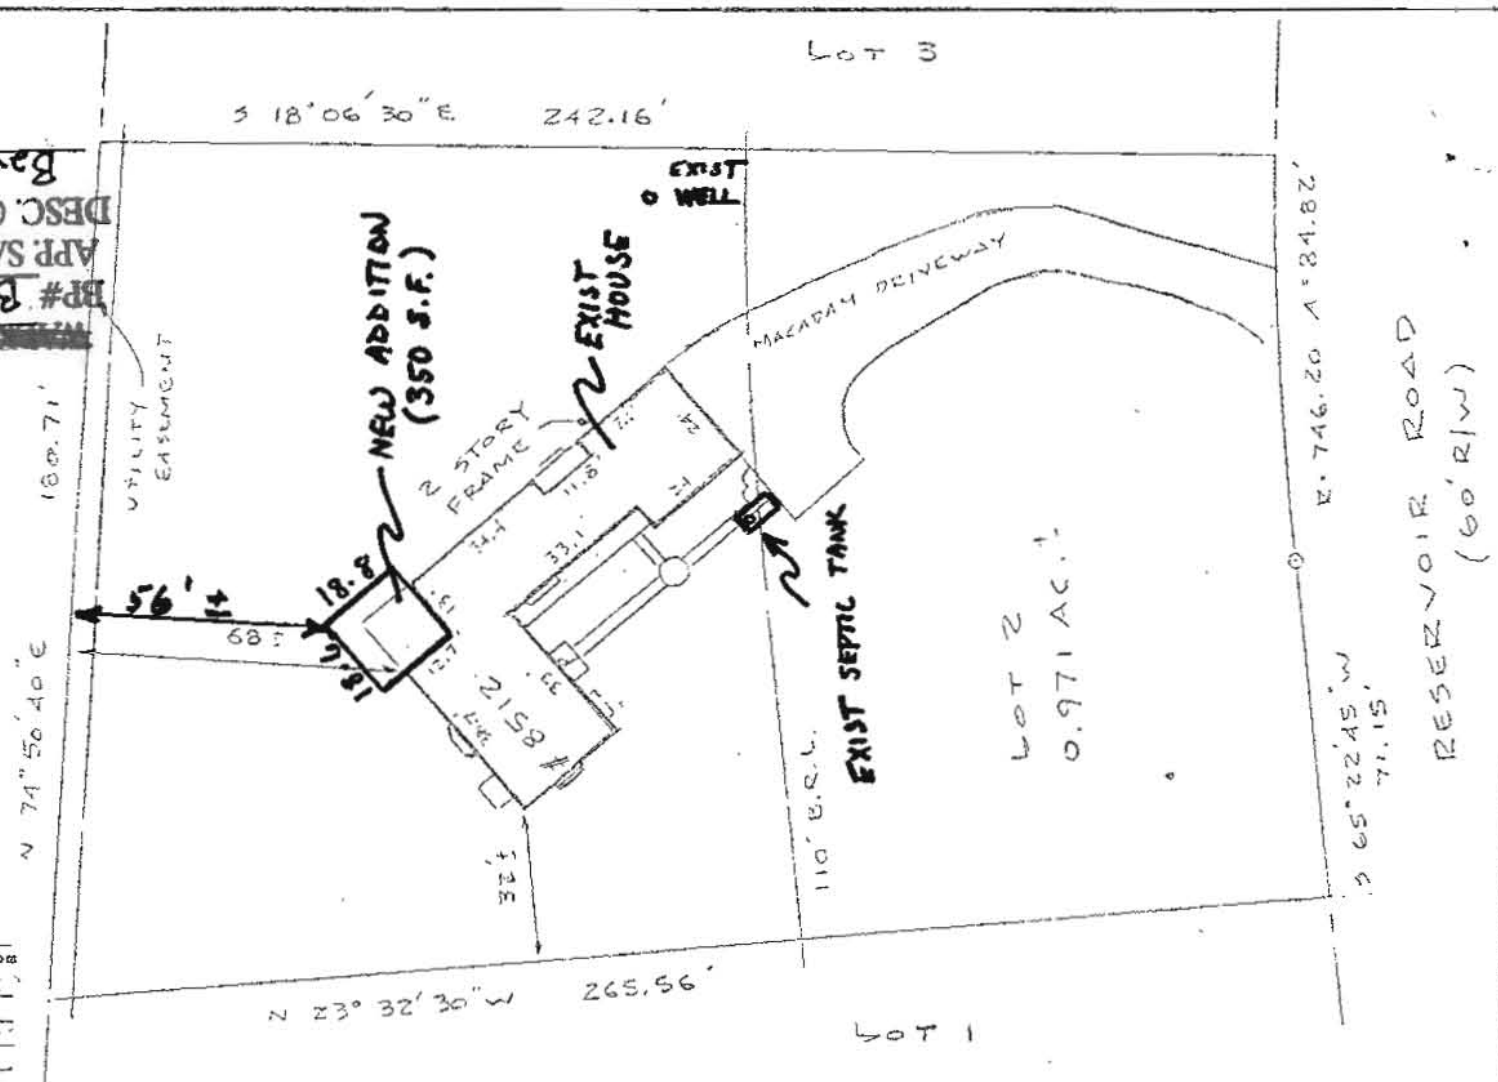

This is to certify that I have surveyed the property known as Lot 2

8512 RESERVOIR ROAD
 sheet of recorded PLAT BK 25 No. 85 among the
 Land Records of HOWARD County, Maryland for the
 purpose of locating the improvements thereon.

THIS PLAT SHOWS ONLY THAT THE IMPROVEMENTS ARE
 CONTAINED WITHIN THE OUTLINES OF THE LOT AND IS
 NOT TO BE USED TO ESTABLISH PROPERTY LINES.



J. Carr Hudgins PLS#96

LOCATION SURVEY
 8512 RESERVOIR ROAD
 BEAUFORT PARK
 5th ELECTION DISTRICT
 HOWARD COUNTY, MD.

NT ASSOCIATES, INC.
 15205 Old Frederick Road
 Mt. Airy, Maryland 21773
 Phone 442-2031

Scale 1" = 40'
 Date MARCH 28, 1994
 Field By lw
 Drawn By lw
 Drawing # N 15238