


Facing the lot  
from the road,  
proposed well site  
50' from rear right  
house corner and  
approximately 130'  
from left rear  
house corner  
John said he would  
allow a well 25' from  
house

LOT 1 SDA Δ TO STAY  
100' From well  
House locations placed  
GIS & wallchecks.



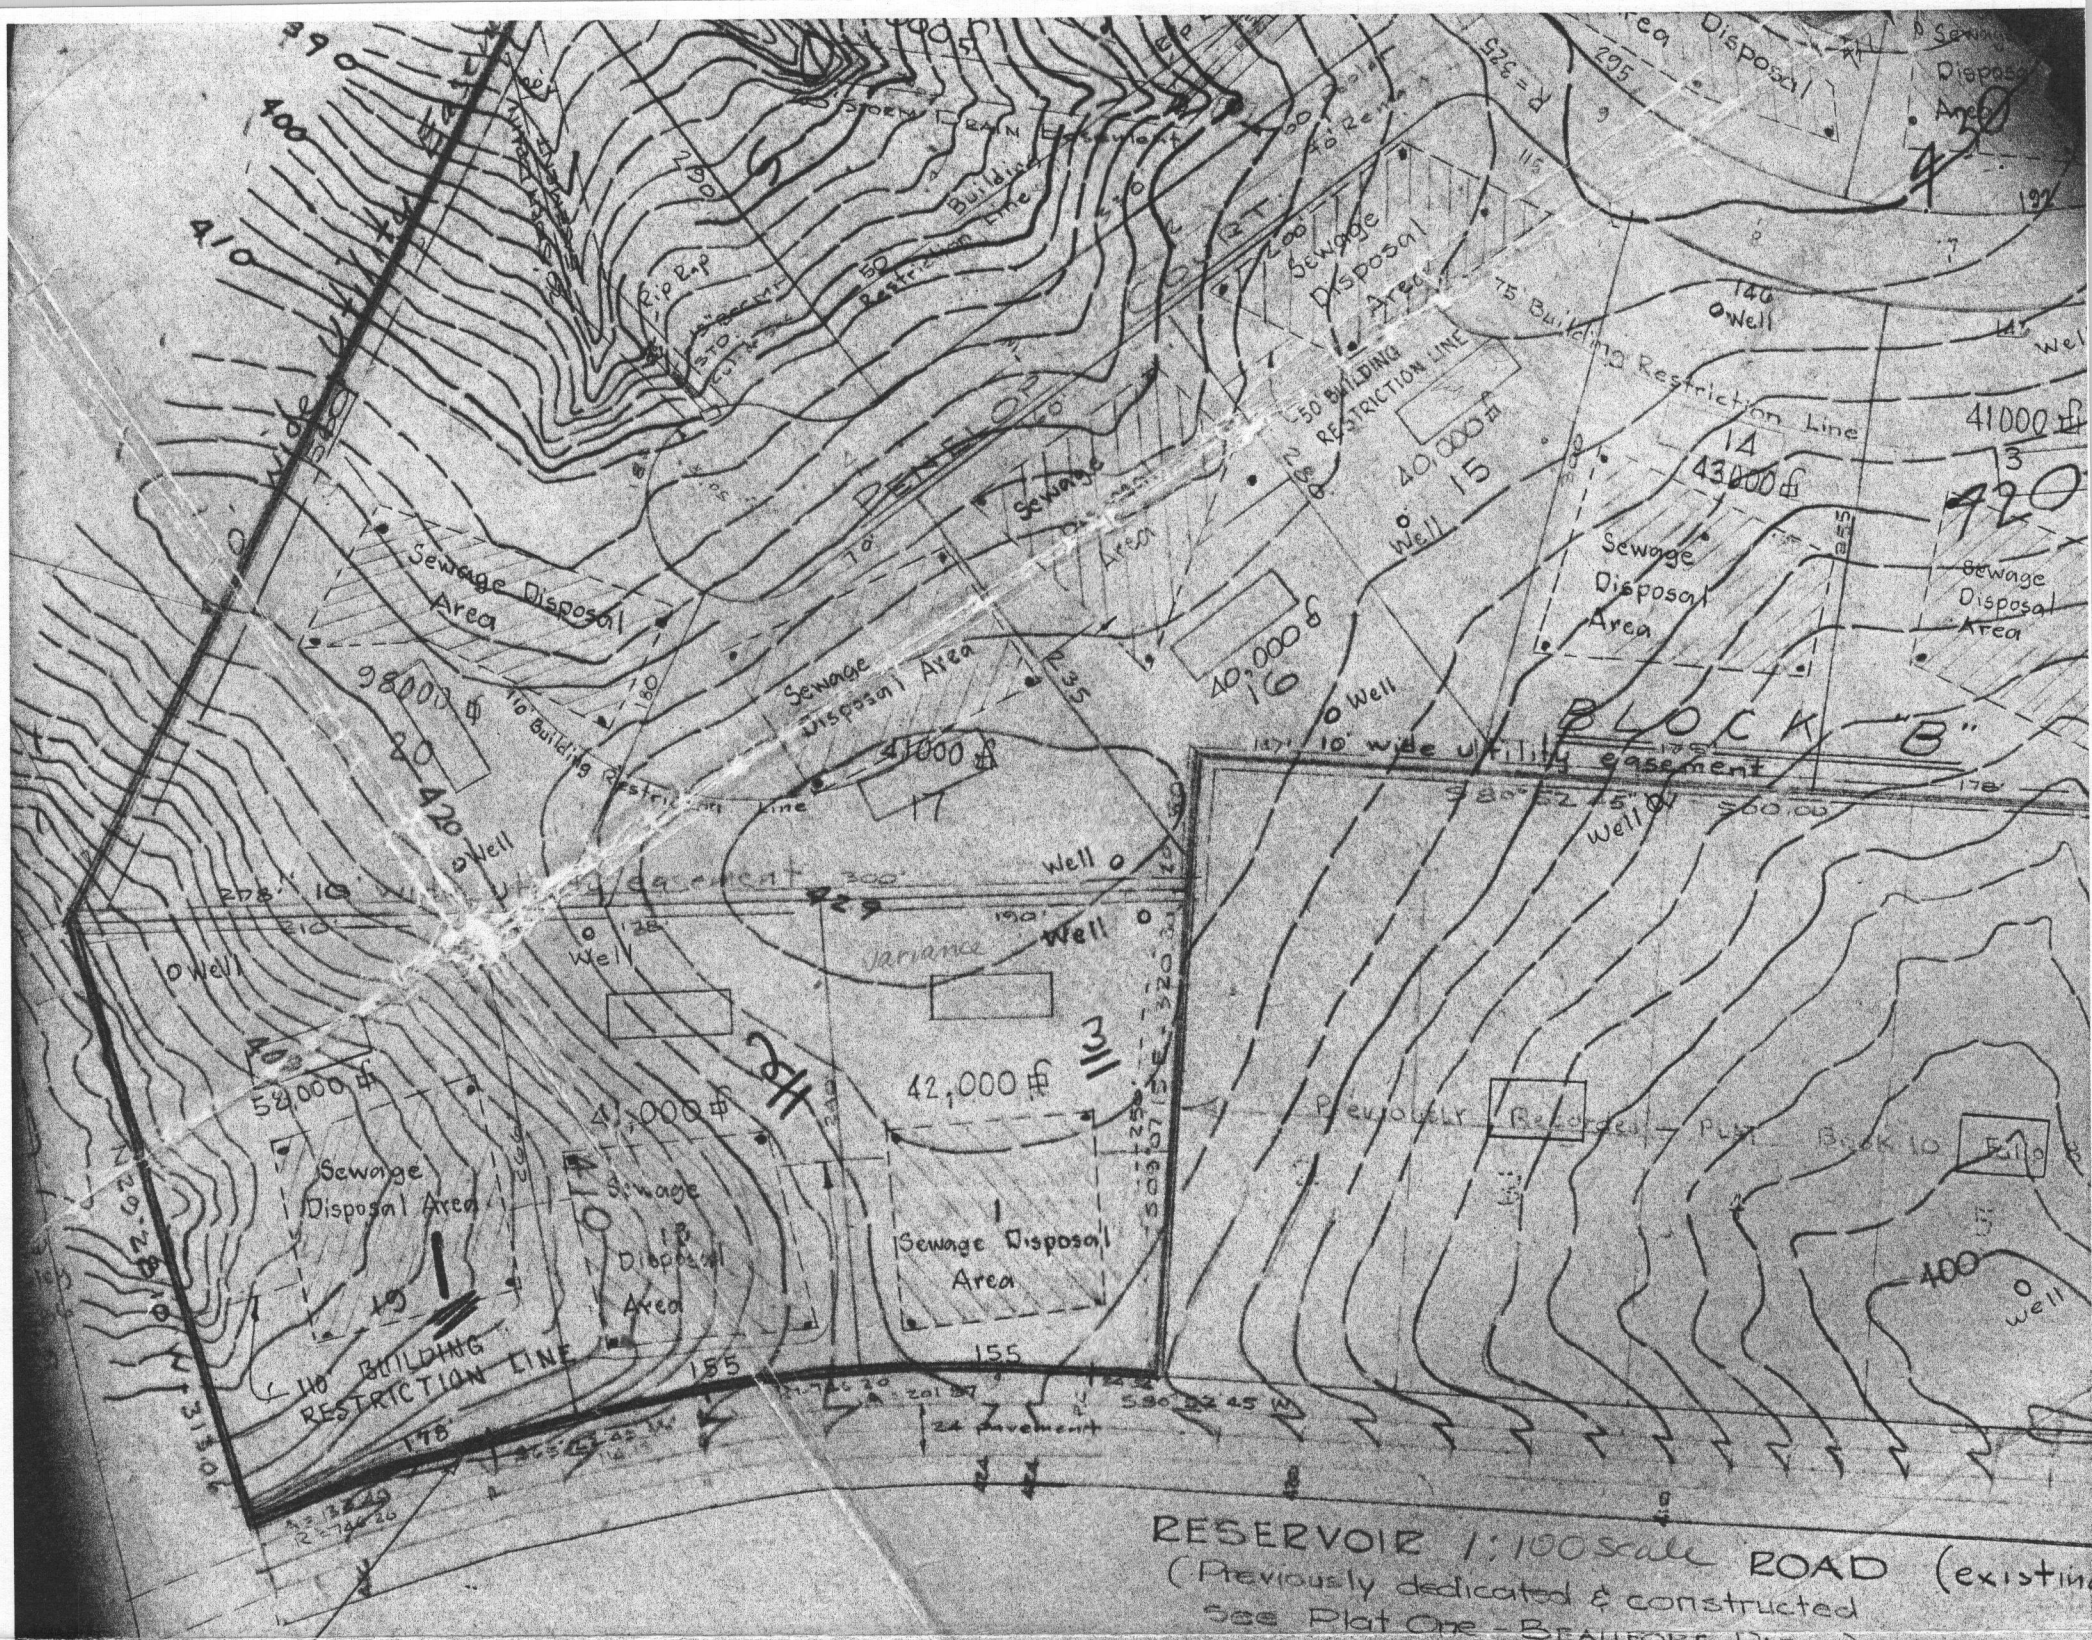

Final lot # in red  
 Old #6C New #7