

MARYLAND DEPARTMENT OF THE ENVIRONMENT, WATER MANAGEMENT ADMINISTRATION
1800 Washington Blvd., Baltimore, Maryland 21230 (410) 537-3784

WATER WELL ABANDONMENT-SEALING REPORT FORM

SUBMIT COPIES OF COMPLETED FORM TO:

- * COUNTY ENVIRONMENTAL AGENCY (contact MDE, WMA if address needed)
- * WELL OWNER
- * MDE, WATER MANAGEMENT ADMINISTRATION, WELL PROGRAM

DATE WELL ABANDONED: 2/16/2015 (month/day/year)

* PERMIT NUMBER OF ABANDONED WELL (if any)

* PERMIT NUMBER OF REPLACEMENT WELL:

* PERSON ABANDONING WELL: Richard Crummitt WELL DRILLER'S LICENSE NUMBER: WR0014

CIRCLE: MWD/MSD/MGD

* OWNER'S NAME: DONALD MUNRO

* WELL LOCATION:

COUNTY: Howard

NEAREST TOWN: FULTON

TAX MAP BLOCK PARCEL

SUBDIVISION:


SECTION: LOT:

STREET ADDRESS: 8601 Reservoir Rd

LATITUDE 39.134303

LONGITUDE 76.946802

SITE LOCATION MAP

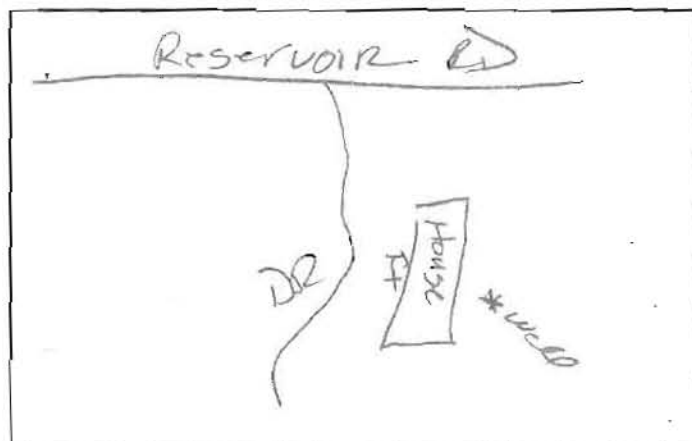

* TYPE OF WELL BEING ABANDONED:

☒ DRILLED ☐ JETTED
☐ BORED ☐ HAND DUG
☐ OTHER (specify)

* USE CODE:

☒ DOMESTIC ☐ MUNICIPAL/PUBLIC
☐ IRRIGATION ☐ INDUSTRIAL
☐ TEST/OBSERVATION ☐ GEOTHERMAL

* TYPE OF CASING:

☒ STEEL ☐ PLASTIC
☐ CONCRETE ☐ OTHER (specify)

SIZE OF CASING: 6 INCHES IN DIAMETER

DEPTH OF WELL: 52 FEET DEEP

WAS ANY CASING REMOVED? YES ☒ NO

If yes, length removed, in feet:

WAS CASING RIPPED OR PERFORATED? YES ☒ NO

LOG OF SEALING MATERIAL

MATERIAL	FEET	
	FROM	TO
Bentonite well pit	52 3	3 0

VOLUME OF MATERIAL USED

8 BAGS BENTONITE