

B 1	6273	SEQUENCE NO. (MDE USE ONLY)	STATE OF MARYLAND APPLICATION FOR PERMIT TO DRILL WELL	STATE PERMIT NUMBER HO-94-3619
12/4/2002		518015 please type		
Date Received (APA)				
OWNER INFORMATION				
<div style="display: flex; justify-content: space-between;"> <div> 8 MM DD YY 13 Timber Ridge Farm 15 Last Name Owner First Name 34 P.O. Box 293 36 Street or RFD 55 mt Airy Md 21771 57 Town 70 State 72 Zip 76 </div> <div> Donnie Clements </div> </div>				
<div style="display: flex; justify-content: space-between;"> <div> 8 Allen Compton Driller's Name 76 License No. 81 Fogle's Well Drilling Firm Name 580 Obrecht RD Address Allen Compton 12-4-02 Signature Date </div> <div> M SD 009 </div> </div>				
<div style="display: flex; justify-content: space-between;"> <div> B 2 WELL INFORMATION APPROX. PUMPING RATE (GAL. PER MIN.) 8 12 5 AVERAGE DAILY QUANTITY NEEDED (GAL. PER DAY) 14 20 500 </div> <div> B 3 LOCATION OF WELL 8 COUNTY 21 Howard 23 SUBDIVISION 42 SECTION 44 46 LOT 48 50 mt Airy 52 NEAREST TOWN 71 MILES FROM TOWN (enter 0 if in town) 3 M I 73 76 77 78 </div> </div>				
<div style="display: flex; justify-content: space-between;"> <div> B 4 DIRECTION OF WELL FROM TOWN (CIRCLE BOX) </div> <div> Ridge Rd (951) 11 NEAR WHAT ROAD 30 ON WHICH SIDE OF ROAD (CIRCLE APPROPRIATE BOX) NORTH N WEST W EAST E SOUTH S 34 550 37 DISTANCE FROM ROAD Ft ENTER FT OR MI 38 39 TAX MAP: 6 BLK: 2 PARCEL 106 </div> </div>				
<div style="display: flex; justify-content: space-between;"> <div> USE FOR WATER (CIRCLE APPROPRIATE BOX) <input type="checkbox"/> D DOMESTIC POTABLE SUPPLY & RESIDENTIAL IRRIGATION <input checked="" type="checkbox"/> F FARMING (LIVESTOCK WATERING & AGRICULTURAL IRRIGATION) <input type="checkbox"/> I INDUSTRIAL, COMMERCIAL, DEWATERING <input type="checkbox"/> P PUBLIC WATER SUPPLY WELL <input type="checkbox"/> T TEST, OBSERVATION, MONITORING <input type="checkbox"/> G GEO-THERMAL </div> <div> NOT TO BE FILLED IN BY DRILLER HEALTH DEPARTMENT APPROVAL Howard 73 COUNTY NAME COUNTY NO. STATE SIGNATURE INSERT S → DATE ISSUED 12/26/02 & Mellon 12/26/03 43 MM DD YY 48 CO SIGNATURE NORTH GRID 551 000 EAST GRID 751 000 50 55 57 63 </div> </div>				
APPROXIMATE DEPTH OF WELL 300 FEET 24 28				
APPROXIMATE DIAMETER OF WELL 6 INCH NEAREST INCH				
METHOD OF DRILLING (circle one) BORED (or Augered) JETTED Jetted & DRIVEN 30 AIR-ROTary AIR-PERCussion ROTARY (Hydraulic Rotary) 37 CABLE REVerse-ROTary DRive-POINT other				
REPLACEMENT OR DEEPEINED WELLS (CIRCLE APPROPRIATE BOX) <input checked="" type="checkbox"/> N THIS WELL WILL NOT REPLACE AN EXISTING WELL <input type="checkbox"/> Y THIS WELL WILL REPLACE A WELL THAT WILL BE ABANDONED AND SEALED 39 <input type="checkbox"/> S THIS WELL WILL REPLACE A WELL THAT WILL BE USED AS A STANDBY-CONTACT LOCAL APPROVING AUTHORITY FOR POLICY ON STANDBY WELLS <input type="checkbox"/> D THIS WELL WILL DEEPEIN AN EXISTING WELL PERMIT NUMBER OF WELL TO BE REPLACED OR DEEPEINED (IF AVAILABLE) 41 52				
Not to be filled in by driller (MDE OR COUNTY USE ONLY) APPROP. PERMIT NUMBER G PERMIT No. HO-94-3619 70 71 72 73 74 75 76 77 78 79				
SPECIAL CONDITIONS NOTE - APPROVING AUTHORITIES SHOULD USE SEPARATE SHEET IF NEEDED.				



Howard County
Health Department

3525 H Ellicott Mills Drive • Ellicott City, MD 21043
(410) 313-2640 Fax (410) 313-2648
TDD (410) 313-2323 Toll Free 1-866-313-6300
website: www.hchealth.org

Penny E. Borenstein, M.D., M.P.H., Health Officer

ATTENTION WELL DRILLERS!!!

When submitting a well application for a new or replacement well, please indicate one of the following:

- ☐ The well site has been staked by _____ on _____ and is ready for site inspection.
- ☐ _____ will call the Health Department for a time to meet in the field to verify a well location.
- ☒ Site plan for new well is attached to well permit application.

Please attach this sheet when submitting your green application. This should help improve communication allowing a more timely service for our citizens.

KN

12-23-02
Anytime

SITE INSPECTION SHEET

OWNER: Donnie Clements PHONE #: _____


ADDRESS: (R+27) 951 Ridge Rd CONTRACTOR: _____

(Near Montg. HoCo line) WELL TAG #: _____

SUBDIVISION: _____ LOT: _____ COUNTY #: _____

PROPOSAL: Verify Staked well isn't in conflict with
SDA Shown on plan.


LOCATION DIAGRAM

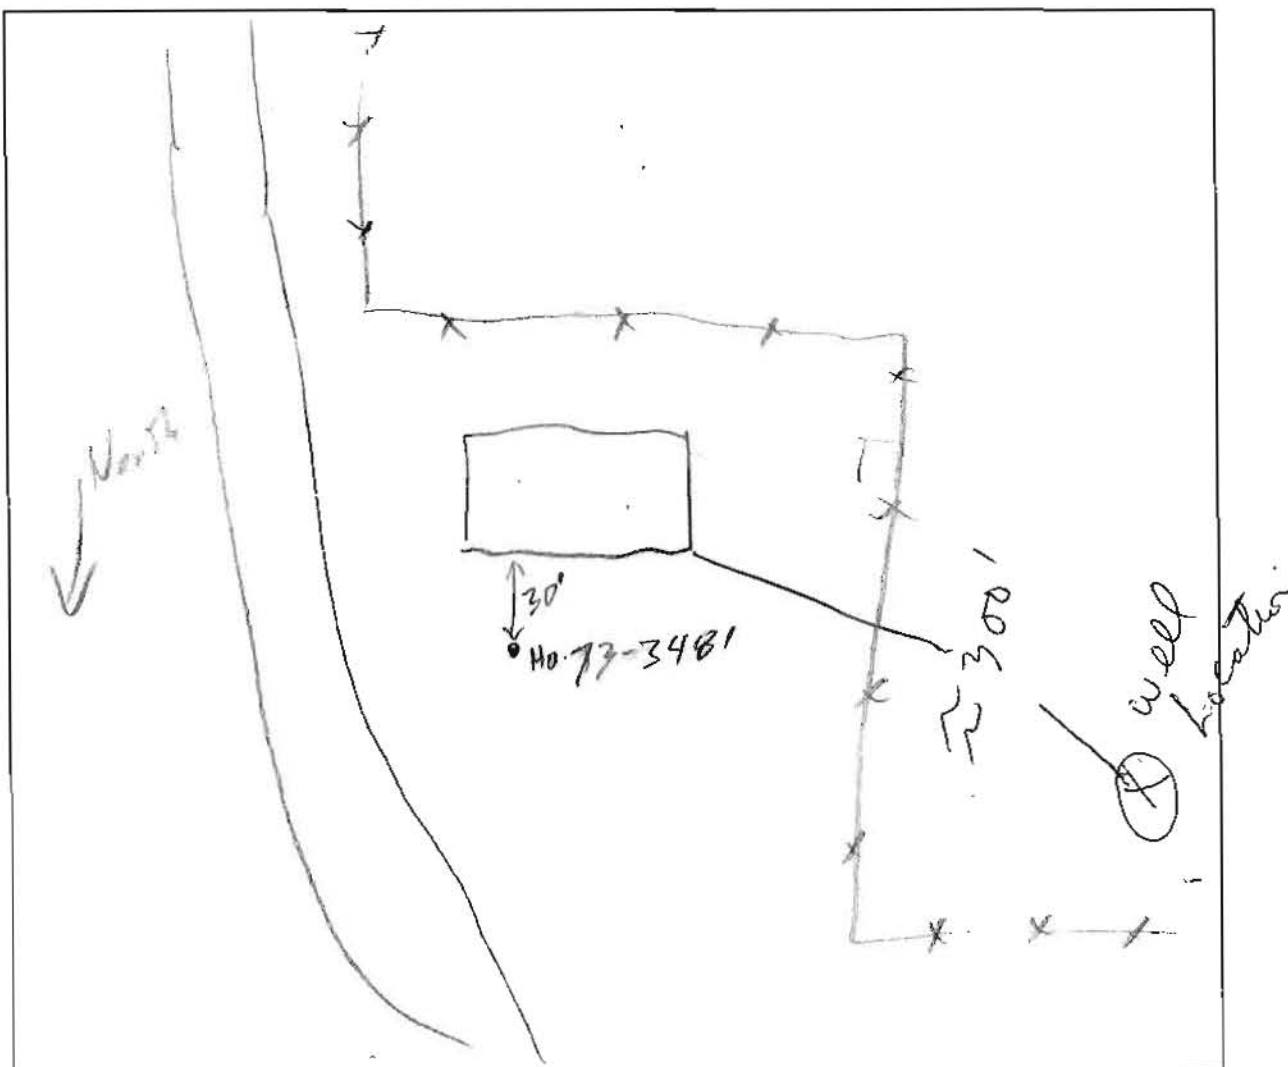

COMMENTS: 12/23/02 Could not find septic system (SD)

DATE: _____ INSPECTOR: _____

Awaiting well
completion
form

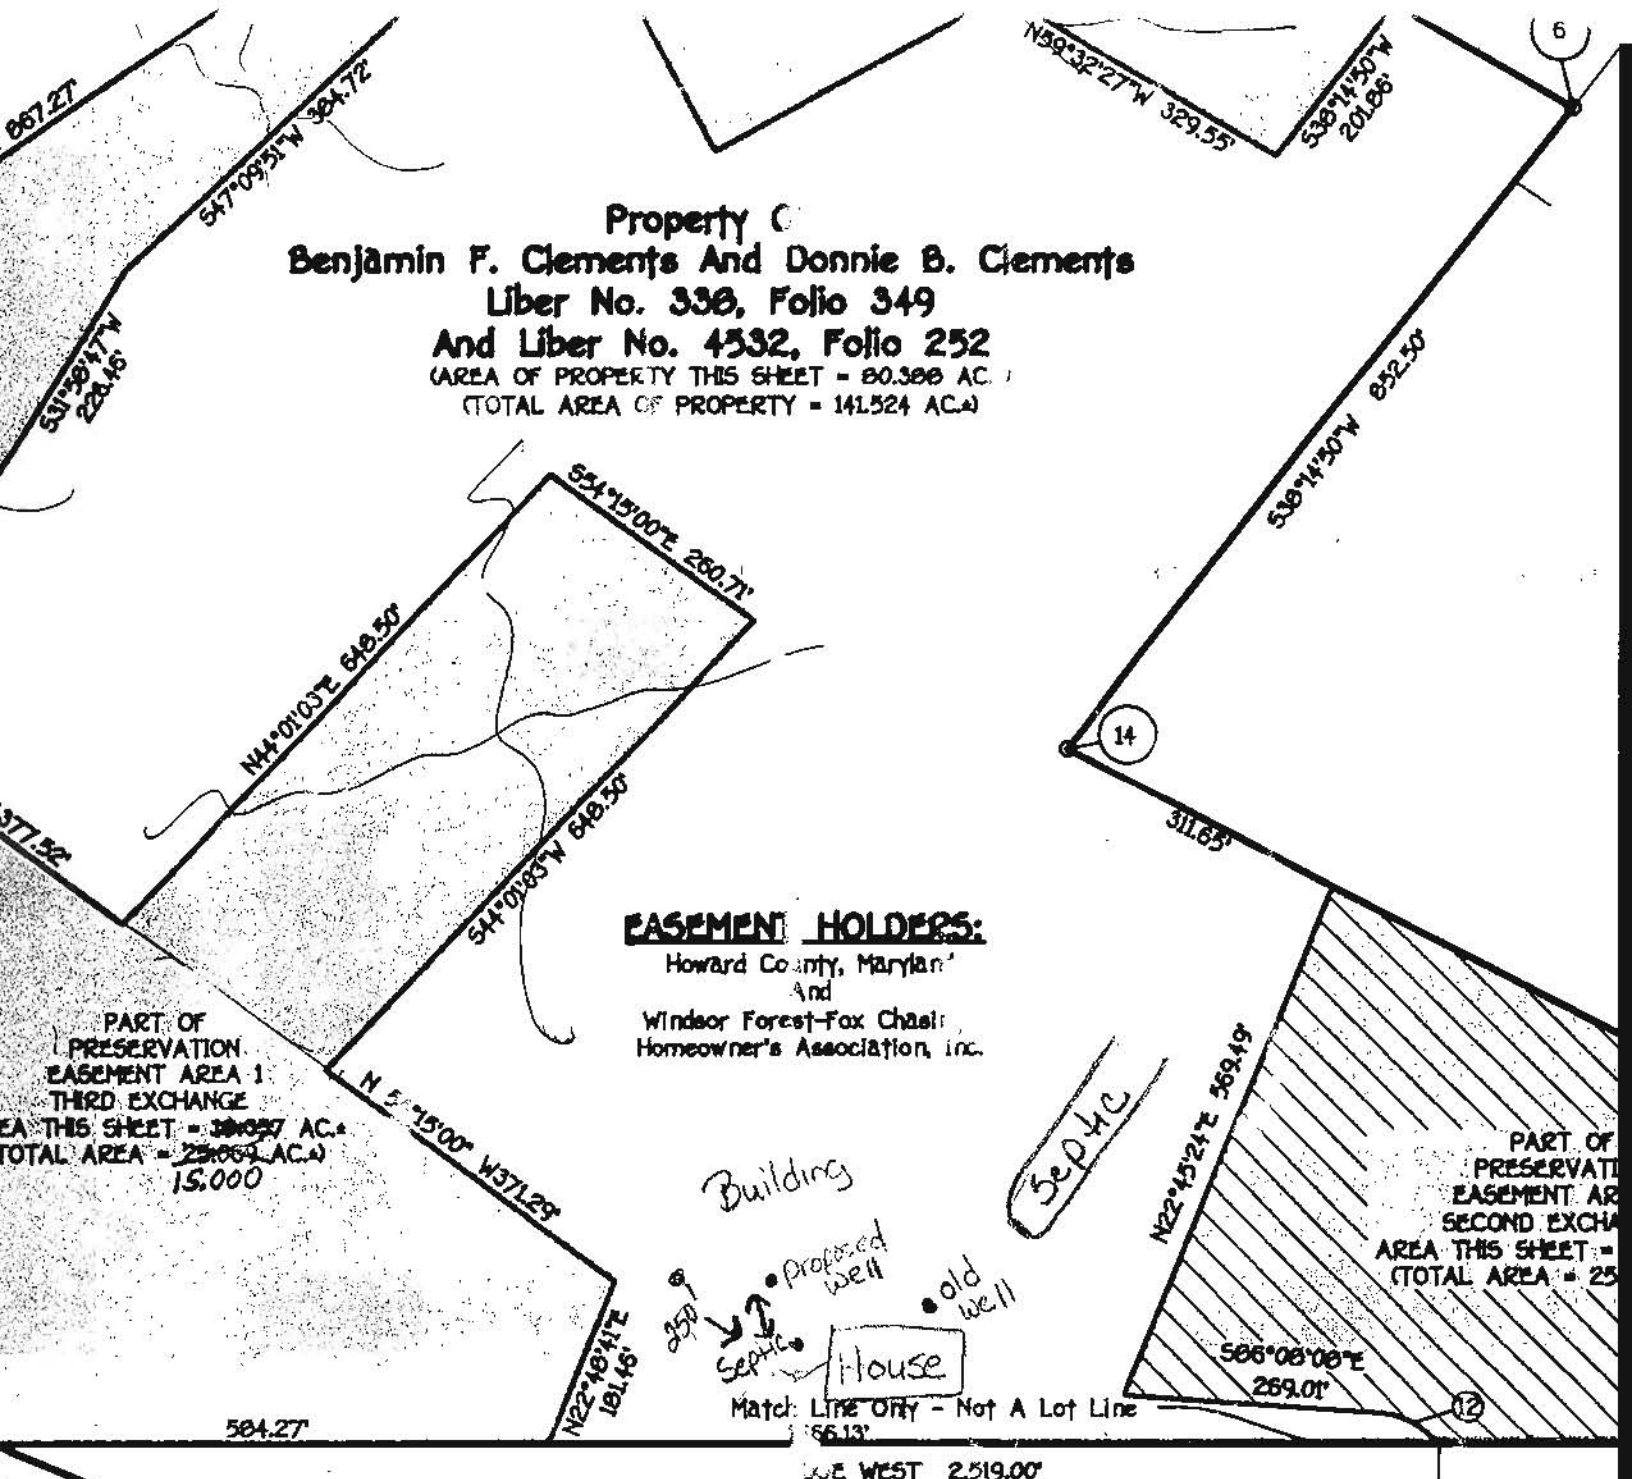

Property C
Benjamin F. Clements And Donnie B. Clements
Liber No. 338, Folio 349
And Liber No. 4332, Folio 252
 (AREA OF PROPERTY THIS SHEET = 80.388 AC.)
 (TOTAL AREA OF PROPERTY = 141.524 AC.)

EASEMENT HOLDERS:
 Howard County, Maryland
 And
 Windsor Forest-Fox Chase
 Homeowner's Association, Inc.

PART OF
 PRESERVATION
 EASEMENT AREA 1
 THIRD EXCHANGE
 AREA THIS SHEET = 38.057 AC.
 TOTAL AREA = 25.000 AC.
 15.000

PART OF
 PRESERVATION
 EASEMENT AREA
 SECOND EXCHANGE
 AREA THIS SHEET = 25
 (TOTAL AREA = 25)

Building
 Proposed well
 old well
 Septic
 House

Match Line Only - Not A Lot Line
 66.13'

LINE WEST 2,519.00'

Match Line Sec Sheet 2

E 385115.57/414.99
 (Metric)
 E 1263500

STATEMENT

Owners Of The Property Shown And Described Hereon, Hereby
 is Plat By The Department Of Planning And Zoning, Establish The
 Development Rights. Witness My Hand This 9th Day Of

SURVEY 2'S CERTIFICATE

I Herby Certify That The Final Plat Shown Hereon Is Intended
 Provide a Preservation Easement Over A Part Of That Parcel
 Conveyed By 1) Delma V. Watkins And Rudy E. Watkins, Her H
 Rudell E. Watkins And Norma L. Watkins, His Wife, And Betty
 Divorced And Not Remarried To Benjamin F. Clements And Do
 Clements, His Wife By Deed Dated August 24, 1959 And Recor