

Building Permit Application
Howard County Maryland
Department of Inspections, Licenses and Permits
3430 Court House Drive
Permits: 410-313-2455

www.howardcountymd.gov

Date Received:		
	200	

Permit No.:

Building Address: 4979 W. W.	Ilw ct	Property Owner's Name: Year Ma
그리 그 그 그 그리 그리 그리 그리 그리 그리 그리 그리고 그리고 그리		Address: SG WA
city: Ellicett City State:		City: E.C. State: MD Zip Code:
suite/Apt. #SDP/	/WP/BA#:	Phone:Fax:
census Tract:SDP/	Subdivision: Wolfaut Creek	Email:
Section: Area		Applicant's Name & Mailing Address, (If other than stated herein)
		Applicant's Name:
ax Map: Parcel:	Grid:	Address:
Zoning: Map Coordinat	es: Lot Size:	City: State: Zip Code: Phone: Fax:
Existing Use: SF-> -		Email:
Proposed Use; SFD.		Contractor Company: Willen Vine Decks
Estimated Construction Cost: \$ 2.45	Se c	Contact Person: John Minzren
		Address: 2 / 60 Jehnsen Mill yed
Description of Work: Dock & 14		City: First Hill State: MD Zip Code: 2100
Revision of existing per	rmit 1317003928	License No. : 82.887
/ *		Phone: 413-752-3455 Fax:
Occupant/Topant Nama:	-	Email:
Occupant/Tenant Name:	by See	
Was tenant space previously occupied?	? ☐Yes ☐No	Engineer/Architect Company:
Contact Name:	/	Responsible Design Prof.:
Address:/		Address:
/	State:Zip Code:	City: State: Zip Code:
Phone:	_Fax:	Phone: Fax:
Email:		Email:
	T-2-1-1-1-1-1-1-1-1-1-1-1-1-1-1-1-1-1-1-	
Commercial Building Characteristics	Residential Building Characteristics	<u>Utilities</u>
Height: No. of stories:	☐ SF Dwelling ☐ SF Townhouse Depth Width	Electric: 🗆 Yes 🗀 No
Gross area, sq. ft./floor:	1 st floor:	Gas: Yes No
0.000 0.007 0.000	2 nd floor:	- Water Supply
Area of construction (sq. ft.):	Basement:	□ Public · ·
	☐ Finished Basement	☑ Private
Use group:	☐ Unfinished Basement	Sewage Disposal
	☐ Crawl Space	☐ Public .
Construction type:	☐ Slab on Grade	√Q Private
☐ Reinforced Concrete ☐ Structural Steel	No. of Bedrooms:	Heating System
☐ Masonry	Multi-family Dwelling No. of efficiency units:	□ Electric □ Oil
☐ Wood Frame	No. of 1 BR units:	☐ Natural Gas ☐ Propane Gas
☐ State Certified Modular	No. of 2 BR units:	Other:
	No. of 3 BR units:	Sprinkler System:
	Other Structure:	☐ Yes ☐ No
	Dimensions:	
Roadside Tree Project Permit	Footings:	Grading Permit Number:
□Yes □No	Roof:	and an
Roadside Tree Project Permit #	☐ State Certified Modular ☐ Manufactured Home	Building Chall Daymis Number
	inantiactured nome	Building Shell Permit Number:
WITH ALL REGULATIONS OF HOWARD COUNTY THIS APPLICATION; (5) THAT HE/SHE GRANTS CO Application Signature	WHICH ARE APPLICABLE THERETO; (4) THAT HE/SE DUNTY OFFICIALS THE RIGHT TO ENTER ONTO THIS P	TO MAKE THIS APPLICATION; (2) THAT THE INFORMATION IS CORRECT; (3) THAT HE/SHE WILL COM TO WILL PERFORM NO WORK ON THE ABOVE REFERENCED PROPERTY NOT SPECIFICALLY DESCRIBE ROPERTY FOR THE PURPOSE OF INSPECTING THE WORK PERMITTED AND POSTING NOTICES. Print Name
Email Address	nehoned ocksicion	Date #2-14-17
ر مهامده ا		50.70.75 845
		9•8
Title/Company		


SIGNATURE OF APPROVAL AGENCY State Highways **Building Officials** PSZA (Zoning). PSZA (Engineering) 12/14/12 // n Health

J. 1. 1. 1. 1. 1. 1. 1. 1. 1. 1. 1. 1. 1.	94 111	_//	Dar.	11-0	1
Is Sediment Control as	provatrequire	d for issua	nce?	Yes 🗹	No
□ CONTINGENCY-CON					

Pront:		
Rear:		
Side:	-10	
Side St.:		- 1
All minimum setbacks met?	☐ Yes	DNo
Is Entrance Permit Required?	☐ Yes	□No
Historic District?	☐ Yes	ONo
Lot Coverage for New Town Z	one:	
SDP/Red-fine approval date:	- 1	3

DPZ SETBACK INFORMATION

Filing Fee	\$		
Permit Fee	\$		- 1253400
Tech Fee	\$		
Excise Tax	\$	- Alk	
PSF5	\$	7	
Guaranty Fund	\$		
Add'l per Fee	\$		
Total Fees	\$		
Sub- Total Paid	\$	7	
Balance Due	\$		7
Check	Ħ		

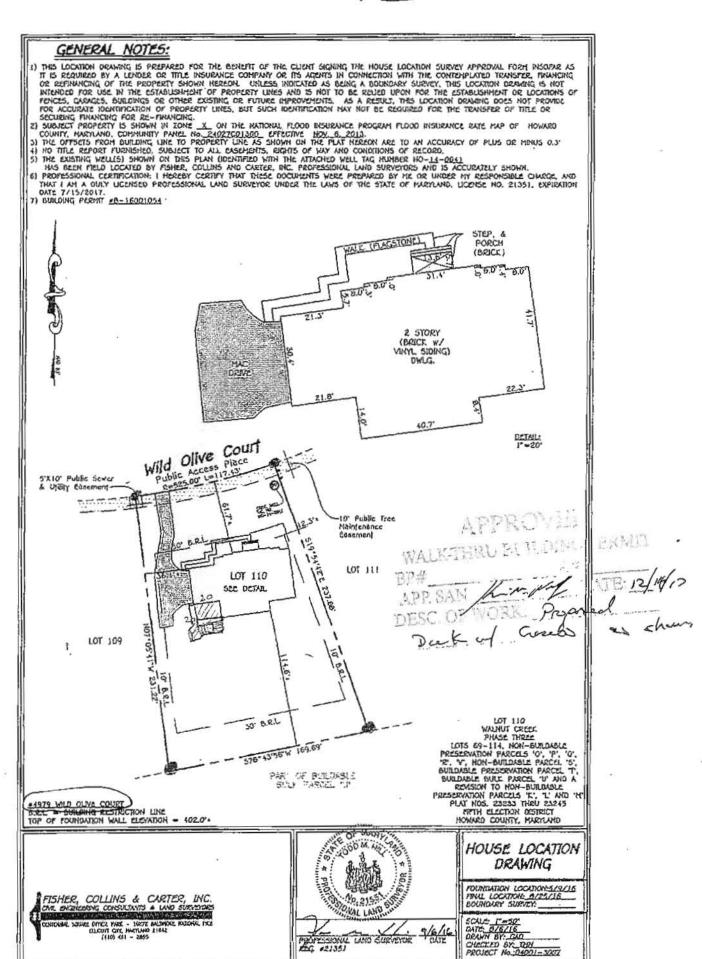

20 lights. 4979 WILD OLIVE OPER Art Wester Al rail
Pergoda
Wrop ordor