


SITE INSPECTION SHEET

OWNER: _____ PHONE #: _____
ADDRESS: 8396 Park Dr CONTRACTOR: _____
SUBDIVISION: _____ LOT: _____ WELL TAG #: _____
PROPOSAL: _____ COUNTY #: _____

LOCATION DIAGRAM

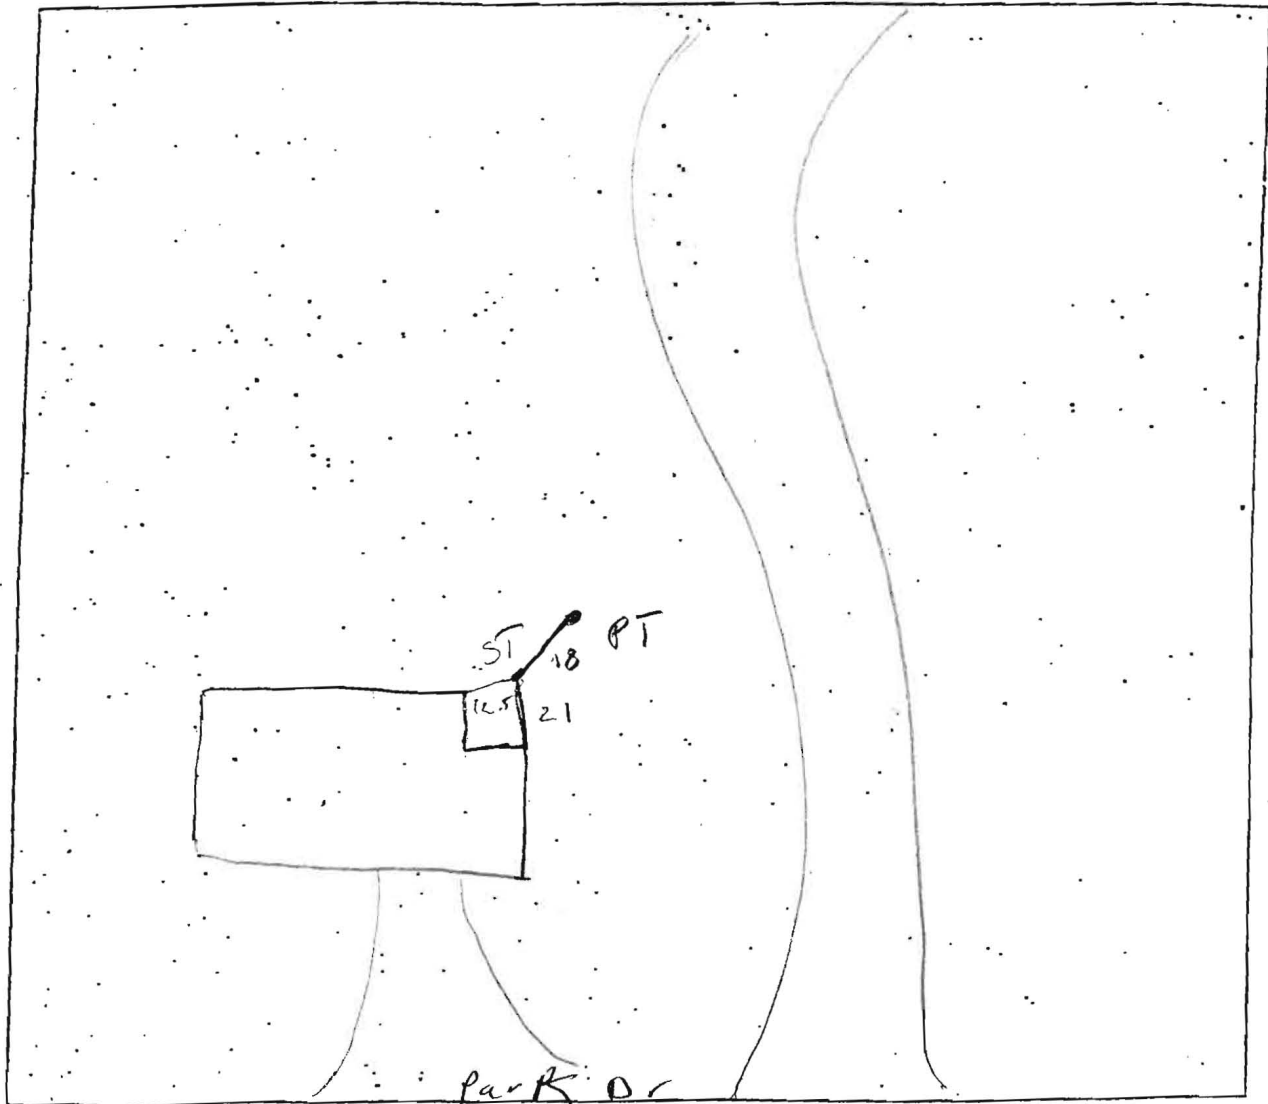

COMMENTS: _____

