

RECORD PLAT 4646
ZONING: R

REVISED

Date: 8/23/77

Comments: Revised to show 30' set back

Comments: Revised to show 30' set back

Original elev. at time of perk test 534.0

Exist. elev. 534.0


Distribution box inlet elev. 531.0

Invert elev. out of septic tank 531.2

Exist. elev. at septic tank 534.5

Invert elev. into septic tank 531.7

Invert elev. out of house 532.9

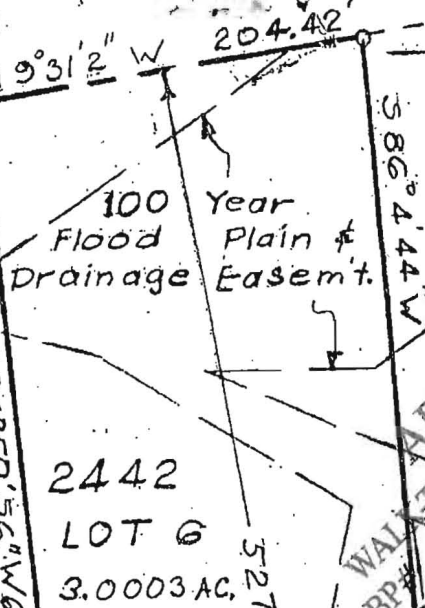

APPROVED
WALK-THRU BUILDING PERMIT
BP# 8/20/77
A# 1214
DATE: 8/11/2017
DESC. OF WORK: on gravel pad 12' x 20' shed 10' or more Sewage Disposal Easement

Approved Septic System Plan
Howard County Health Department
Signature: [Signature]
Date: 9/7/84
Stair & Stoop 1st Fl. Elev. 542.17
Basement Elev. 534.0

LOT 8

LOT 9

LOT 10

LOT 11

LOT 12

Water Well
Exist Elev. 545'

Sewage Disposal Easement

Sewage Disposal Easement

(Rad. 250.00
Arc. 152.35)

7/26/84
Sketch O.K.
W. Klotzli

PREPARED FOR:

INTERSTATE BUILDING CONTRACTORS, INC.

THEODORE F. STROMBERG, PRES. TEL. (301) 465-5500

9267 BALTIMORE NATIONAL PIKE, ELLICOTT CITY, MD. 21043

I certify the above measurements & elevs. are actual & correct for this prop.

Werner Klotzli, Jr. P.E. REG. NO. 7934

SITE PLAN

2442 WOOD STREAM CT.

LOT 6, SANDY HILL ESTATES, 3RD ELECT. DIST., HOWARD CO., MD.

WERNER KLOETZLI, JR., P.E.

SITE PLANNER & CIVIL ENGINEER

4006 CHATHAM RD., ELLICOTT CITY, MD. 21043

TEL. (301) 465-3912

SCALE
1"=100'

DATE
7/24/84

JOB NO.
84-11

Hurman, Laura

From: Hurman, Laura
Sent: Tuesday, September 05, 2017 3:16 PM
To: Bricker, Robert
Cc: Hill, Amanda; Powell, Markus P.; Whalen, Debbie
Subject: RE: B17003114_revised Plot Plan
Attachments: REV PLOT PLAN 8.23.17.pdf

Apparently, the applicant only provided a revised plot plan to DED/DPZ, we never got a copy. I got a copy from DPZ and scanned and attached it. It is also attached to this e-mail, and I am sending a copy over to you.

Thanks,

Laura Hurman
Howard County Government
Dept. of Inspections, Licenses & Permits
3430 Court House Drive
Ellicott City, MD 21043
(410) 313-2455
LHurman@HowardCountyMD.gov

****WHEN RESPONDING TO THIS E-MAIL PLEASE "REPLY ALL"****

From: Bricker, Robert
Sent: Tuesday, September 05, 2017 1:53 PM
To: Hurman, Laura <LHurman@howardcountymd.gov>
Subject: B17003114_revised Plot Plan

Good afternoon Laura. I need to see a revised Plot Plan that was submitted to DILP on or about August 23. There is a reference in Acella by Zoning, a request for a Plot Plan revision. Supposedly the revision was submitted and it was approved by Zoning, however there is not a revised Plot Plan for this proposal in Acella for others to view. The proposal is B17003114, for a 12' X 20' shed at 2442 Woodstram Court.

ROBERT BRICKER, REHS/R.S., L.E.H.S.
ENVIRONMENTAL SANITARIAN II
BUREAU OF ENVIRONMENTAL HEALTH, WELL AND SEPTIC PROGRAM
8930 STANFORD BLVD., COLUMBIA, MD 21045

Phone: Desk, 410-313-2691; Program, 410-313-1771; Bureau, 410-313-1774
Fax: 410-313-2648

E-mail: rbricker@howardcountymd.gov