

APPLICATION

FOR PERCOLATION TESTING AND SITE EVALUATION

TEST DATE(S) _____ TEST TIME _____

AP 520108-Y

AGENCY REVIEW: _____

DATE 4/9/04

DO NOT WRITE ABOVE THIS LINE

I HEREBY APPLY FOR THE NECESSARY TESTING/EVALUATION PRIOR TO ISSUANCE OF SEWAGE DISPOSAL SYSTEM PERMIT(S) TO:

CHECK AS NEEDED:

- ☒ CONSTRUCT NEW SEPTIC SYSTEM(S)
☐ REPAIR/ADD TO AN EXISTING SEPTIC SYSTEM
☐ REPLACE AN EXISTING SEPTIC SYSTEM

CHECK AS NEEDED:

- ☒ NEW STRUCTURE(S)
☐ ADDITION TO AN EXISTING STRUCTURE
☐ REPLACE AN EXISTING STRUCTURE

CHECK ONE:

- ☒ CREATE NEW LOT(S)
☐ BUILD ON AN EXISTING LOT IN A SUBDIVISION
☐ BUILD ON AN EXISTING PARCEL OF RECORD

IS THE PROPERTY WITHIN 2500' OF ANY RESERVOIR?

- ☐ YES
☒ NO

THE TYPE OF STRUCTURE IS:

- ☒ RESIDENTIAL WITH UNKNOWN PROPOSED BEDROOMS IN THE COMPLETED STRUCTURE (NOTE UNKNOWN IF APPROPRIATE)
☐ COMMERCIAL (PROVIDE DETAIL OF NUMBERS AND TYPES OF EMPLOYEES/ CUSTOMERS ON ACCOMPANYING PLAN)
☐ INSTITUTIONAL/GOVERNMENT (PROVIDE DETAIL OF NUMBERS AND TYPES OF EMPLOYEES/USERS ON ACCOMPANYING PLAN)

PROPERTY OWNER(S) LDG Inc. Lee Plaza

DAYTIME PHONE 301-585-7000 CELL _____ FAX _____

MAILING ADDRESS 8601 Georgia Ave. Silver Spring MD 20910
STREET CITY/TOWN STATE ZIP

APPLICANT VanMar Associates Inc.

DAYTIME PHONE 301-829-2890 CELL _____ FAX _____

MAILING ADDRESS 310 South Main St. Mount Airy MD 21771
STREET CITY/TOWN STATE ZIP

APPLICANT'S ROLE: DEVELOPER BUILDER BUYER RELATIVE/FRIEND REALTOR CONSULTANT

PROPERTY LOCATION

SUBDIVISION/PROPERTY NAME Schwabe Farms LOT NO. 256

PROPERTY ADDRESS MD Route 32 West Friendship 21794
STREET TOWN/POST OFFICE

TAX MAP PAGE(S) 15 GRID 5 PARCEL(S) 12 PROPOSED LOT SIZE 1AC±

AS APPLICANT, I UNDERSTAND THE FOLLOWING: THE SYSTEM INSTALLED SUBSEQUENT TO THIS APPLICATION IS ACCEPTABLE ONLY UNTIL PUBLIC SEWERAGE IS AVAILABLE. THIS APPLICATION IS COMPLETE WHEN ALL APPLICABLE FEES AND A SUITABLE SITE PLAN HAVE BEEN RECEIVED. I ACCEPT THE RESPONSIBILITY FOR COMPLIANCE WITH ALL M.O.S.H.A. AND "MISS UTILITY" REQUIREMENTS. APPROVAL IS BASED UPON SATISFACTORY REVIEW OF A PERC CERTIFICATION PLAN.

TEST RESULTS WILL BE MAILED TO APPLICANT.

Danielle Stout
SIGNATURE OF APPLICANT

HOWARD COUNTY HEALTH DEPARTMENT, BUREAU OF ENVIRONMENTAL HEALTH, WELL AND SEPTIC PROGRAM
3525-H ELLICOTT MILLS DRIVE, ELLICOTT CITY, MARYLAND 21043-4544 (410) 313-1771 FAX (410) 313-2648
TDD (410) 313-2323 TOLL FREE 1-877-4MD-DHMH

636

Brown L

Orange/red
Brown
micaceous
See

Brass / Yellow
micaus
61

Yellow/Box
= Trace Rock

625

Brown L

Orange/Brown
tight
compact
S!

Yellow/Orange
Brown
micaceous
Si

orange/red
S. n/1590

623


Browns

Orange/red
Brown rice

Yellow / Brown
mica

Brown/yellow
orange

Time Roll

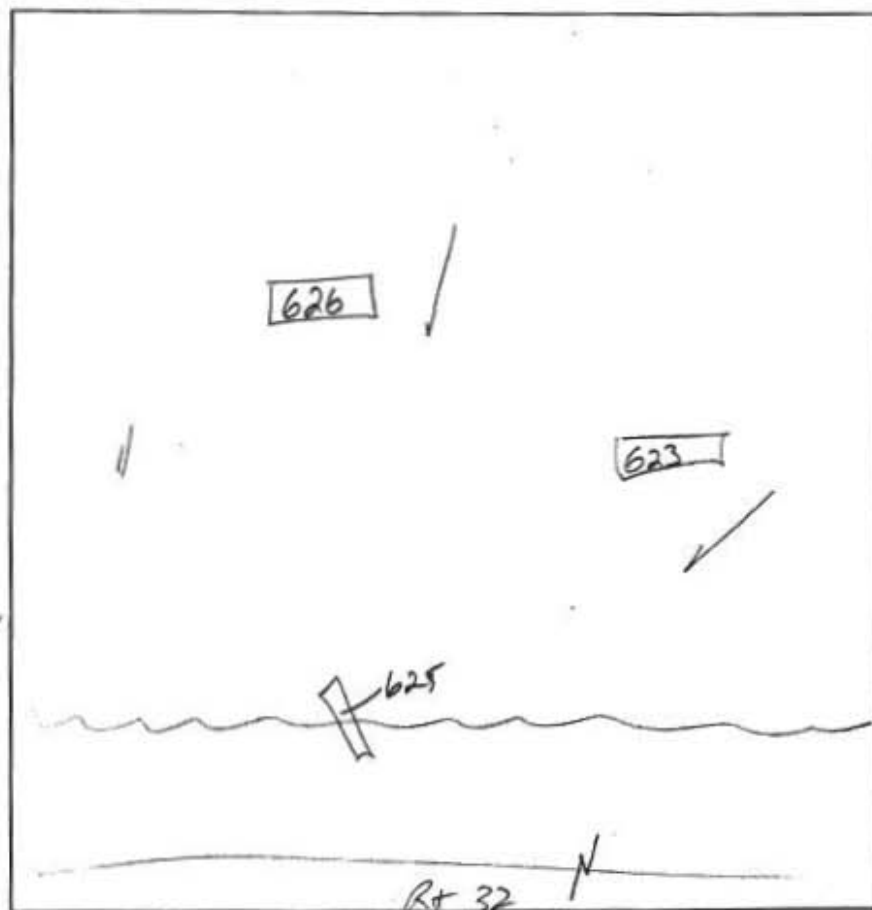[illegible]

REMARKS all holes dug per paw

SANITARIAN K30

BACKHOE Justin

OTHERS Zach

TEST HOLES USED IN SDA

AVG. PERC TIME

SQ. FT./BR.

TRENCH WIDTH

INLET DEPTH

MAX. BOT DEPTH


EFFECTIVE SAW

AP

618
 Brns L w/
 clayey sil
 1 1/2'
 Brns/orange
 micaceous
 sil
 4 1/2'
 Red/orange
 yellow micaceous
 sil w/
 10% clayey sil
 7'
 Yellow/Brns
 3
 trace Rck
 11'

619
 Brns L
 orange/Brns
 micaceous
 sil
 Brns/Rck
 micaceous sil
 Yellow/Brns
 micaceous sil
 w/ 10%
 mica
 sand
 10'

624
 Brns L
 1'
 Brns/micaceous
 sil
 4'
 Brns/sil
 w/ trace
 Rck
 8'
 Yellow/Brns
 5
 trace
 Rck
 10'

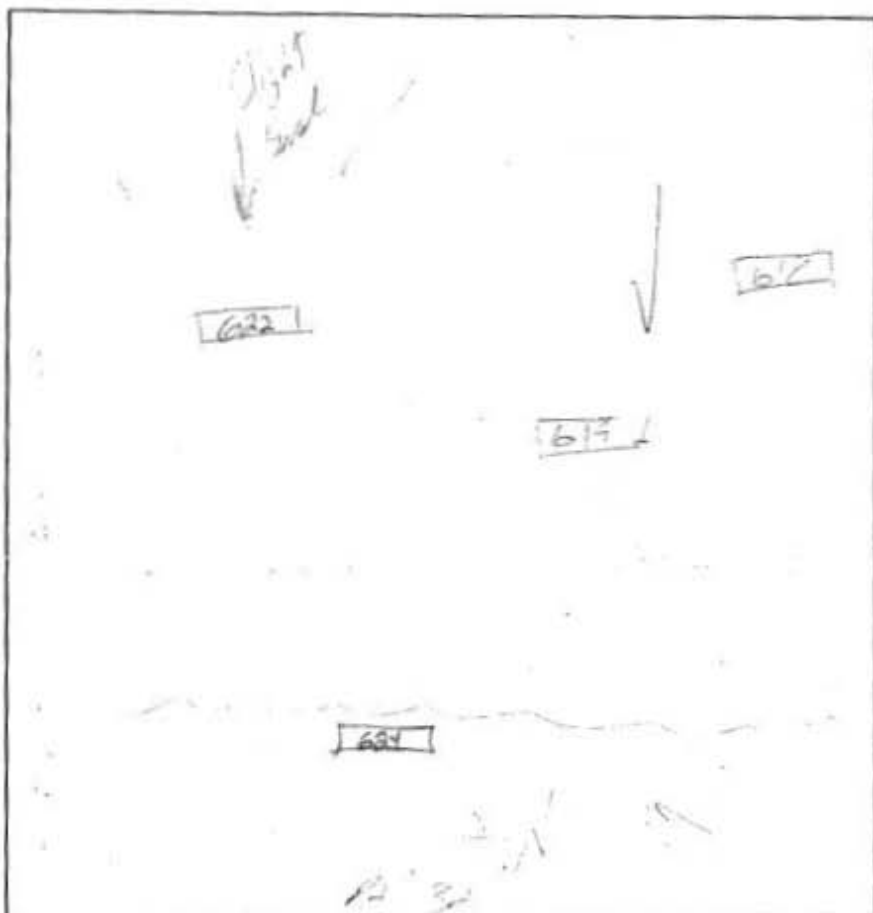

622
 Brns L
 Red/orange
 micaceous
 sil
 4'
 Yellow/Brns
 micaceous
 sil
 9 1/2' - 10'
 Yellow/Brns
 5
 - trace
 Rck -
 11'


DATE	TEST #	DEPTH	START	BREAK 1" DROP	STOP 2" DROP	TIME OF 2ND INCH	P/F/H
7/16/04	618	5 1/2' 11'	1:40	1:51	2:12	22 min	P
	619	10' - 11' visual					OK
	624	4 1/2' 10'	1:45	1:49	1:56	7 min	P
	622	4' 11'	2:02	2:05	2:09	4 min	P

REMARKS all notes dug per plan

SANITARIAN KJR BACKHOE Justin OTHERS Ed

TEST HOLES USED IN SDA _____ AVG. PERC TIME _____ SQ. FT/BR _____

TRENCH WIDTH _____ INLET DEPTH _____ MAX. BOT DEPTH _____ EFFECTIVE S/W _____

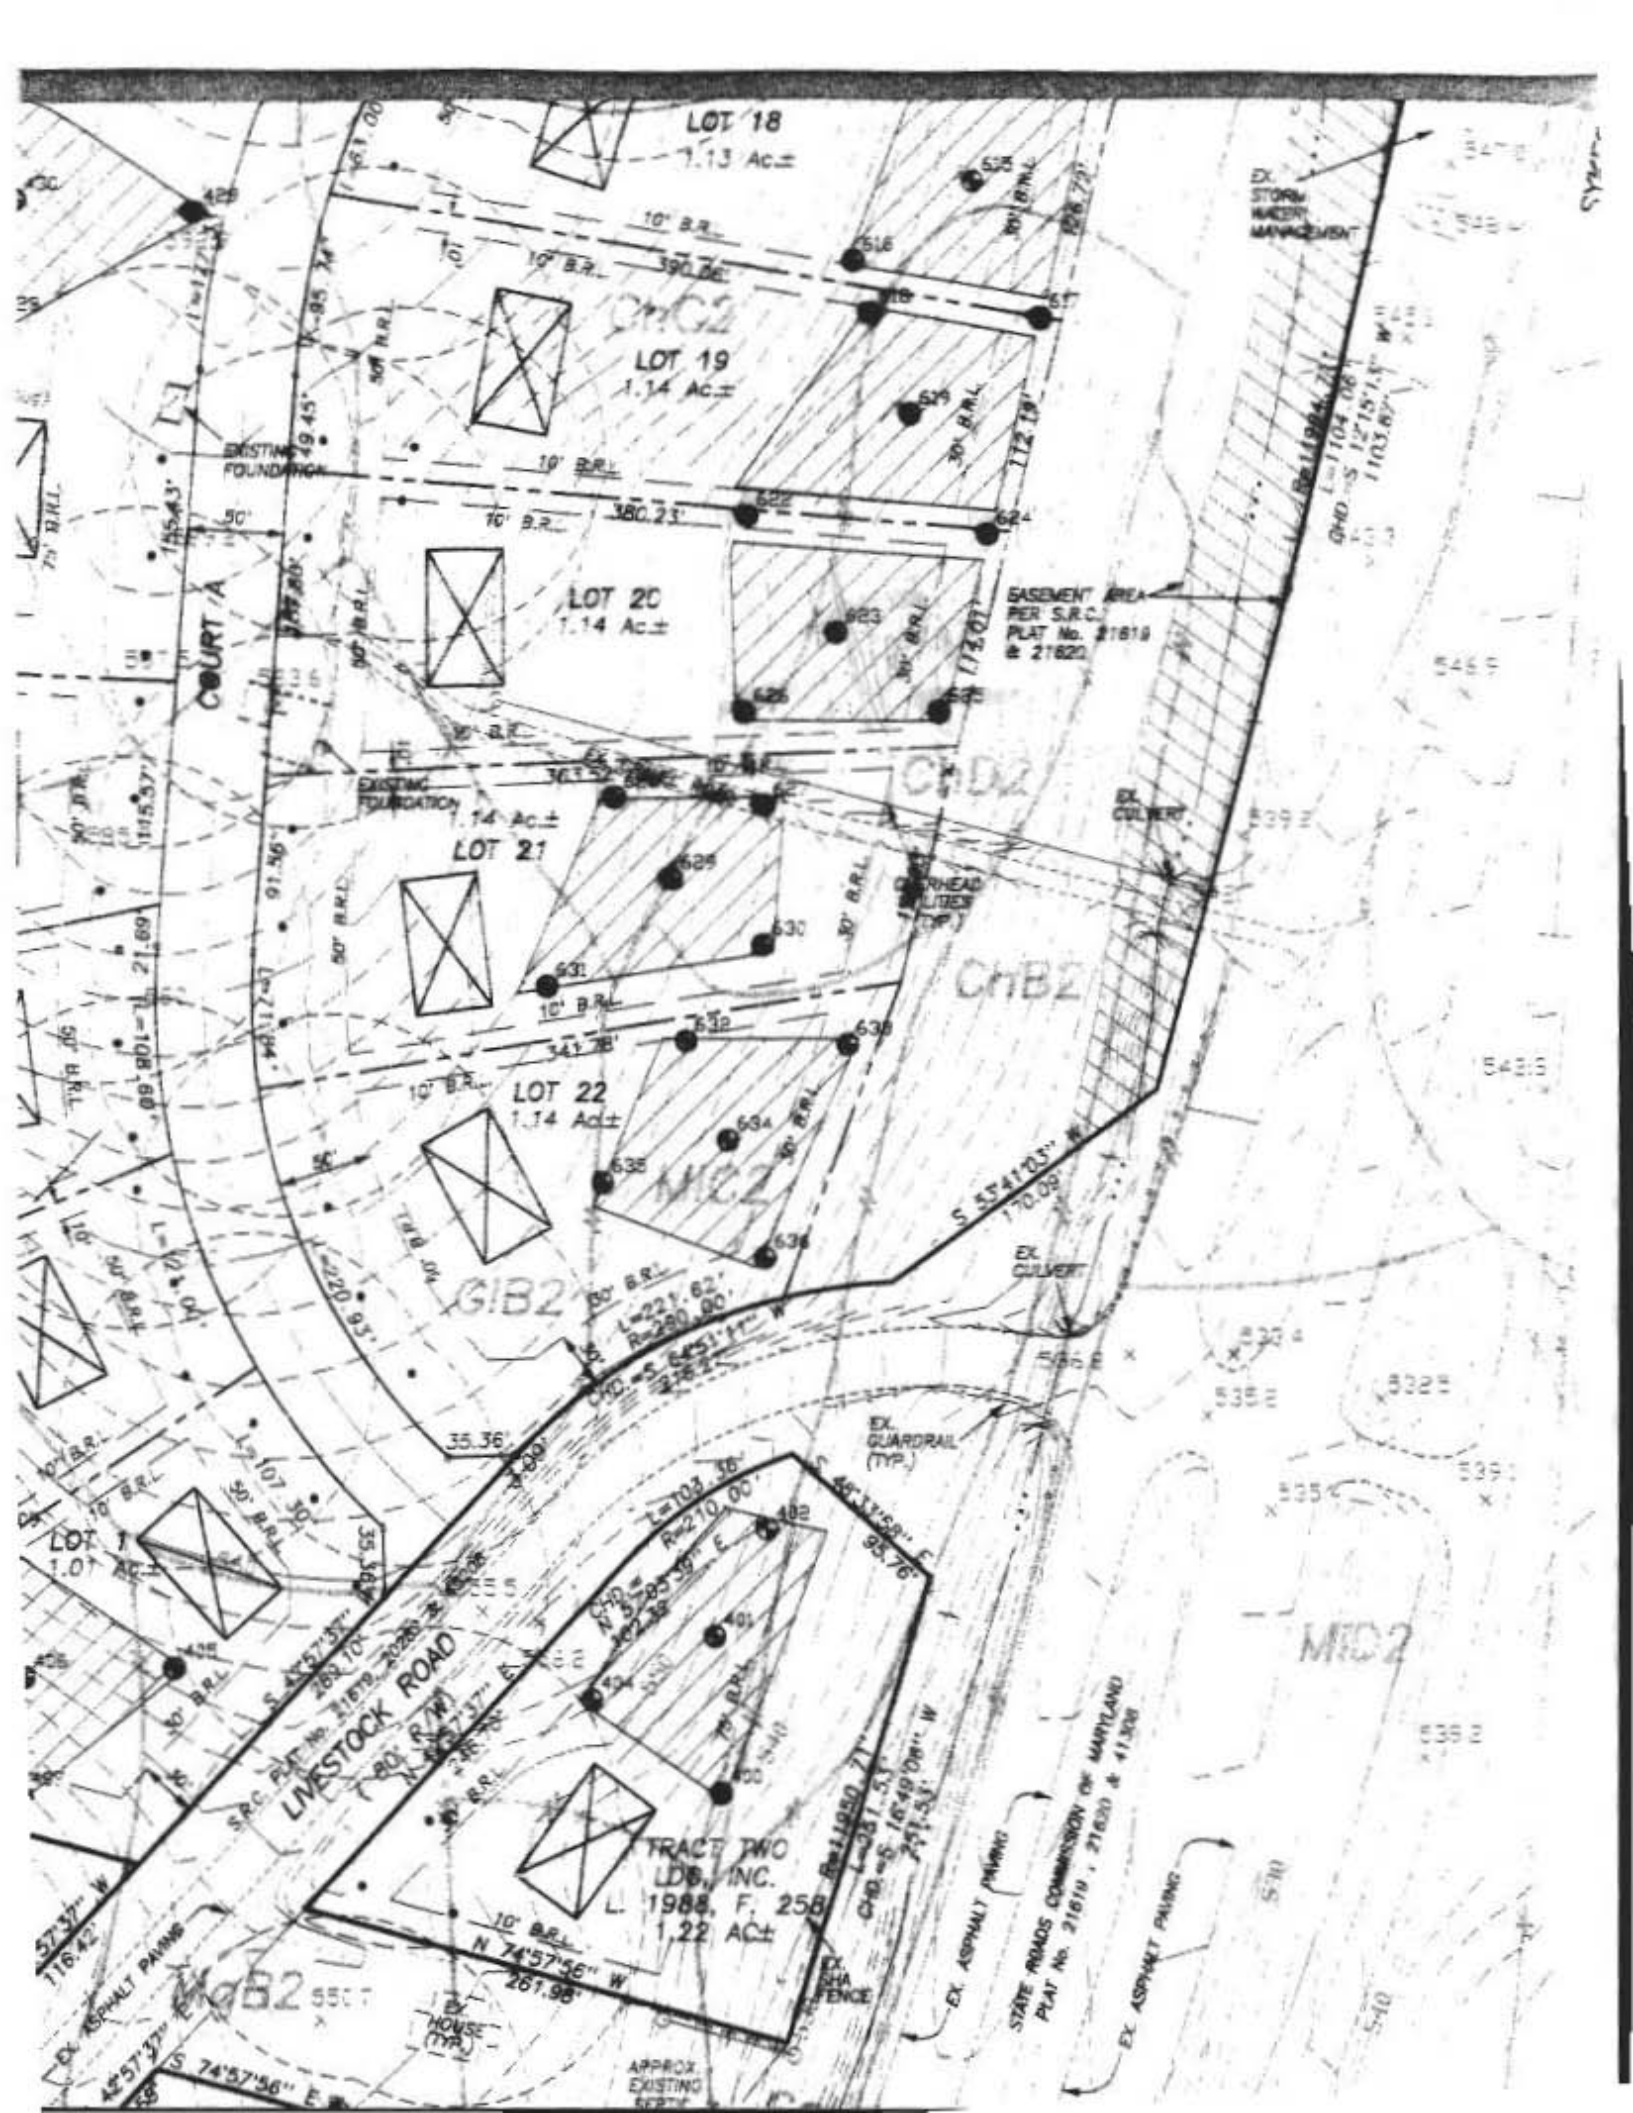

LOT 18
1.13 AC±

LOT 19
1.14 AC±

LOT 20
1.14 AC±

LOT 21
1.14 AC±

LOT 22
1.14 AC±

TRACT TWO
LDB, INC.
1988, F. 258
1.22 AC±

COURT A

LIVESTOCK ROAD

STATE ROADS COMMISSION OF MARYLAND
PLAT No. 21618, 21620 & 41300

EX. STORM
WATERS
MANAGEMENT

BASEMENT AREA
PER S.R.C.
PLAT No. 21618
& 21622

EX. ASPHALT PAVING

EX. GUARDRAIL
(TYP.)

EX. SHA
FENCE

EX. HOUSE
(TYP.)

APPROX.
EXISTING
ELEVATION

MTC2

ChB2

ChD2

GIB2

ChB2