

APPLICATION

SEWAGE DISPOSAL TESTING

A 15536

P

MARYLAND STATE DEPARTMENT OF HEALTH

HOWARD COUNTY *Deep trench 400 sq ft* ELLICOTT CITY

of absorbent sidewalk area below the inlet DISTRICT 5

pipe. Trench to be 7 to 8 ft below ^{original} grade 2 ft and original DATE 9/25/70

3 ft of gravel below the pipe to be hooked to distribution

box. Locate system 10 to 15 ft from front property line

to run ~~parallel~~ parallel with road

TO: THE COUNTY HEALTH OFFICER
ELLICOTT CITY, MARYLAND

I, HEREBY, APPLY FOR THE NECESSARY TESTS IN ORDER TO CONSTRUCT (OR RECONSTRUCT) A SEWAGE DISPOSAL SYSTEM.

PROPERTY OWNER Carroll Fraley & wife

ADDRESS Lime Kiln Road, Fulton, Maryland PHONE PA 5-4372

PROPERTY LOCATION:

SUBDIVISION _____ LOT NO. _____

ROAD AND DESCRIPTION Lime Kiln Road - in Fulton turn left on Lime Kiln Road

in front of Antique shop - turn left onto a gravel lane
2nd house right side - white stucco

OCCUPANT _____ PHONE _____

PERSON TO CONSTRUCT SYSTEM _____

ADDRESS _____ PHONE Existing house

SIZE OF LOT 1 ± acres TYPE BLDG. 2
NUMBER OF BEDROOMS

IF NOT SINGLE RESIDENCE DESCRIBE add additional bedroom and bath

SIGNATURE OF APPLICANT Carroll P. Fraley


APPROVED BY James T. Wright FOR ~~Deep Trench~~ DATE 9/30/70

REJECTED BY _____ FOR _____ DATE _____

HOLD PENDING FURTHER TESTS _____ DATE _____

REASONS FOR REJECTION OR HOLDING _____

THIS IS NOT A PERMIT

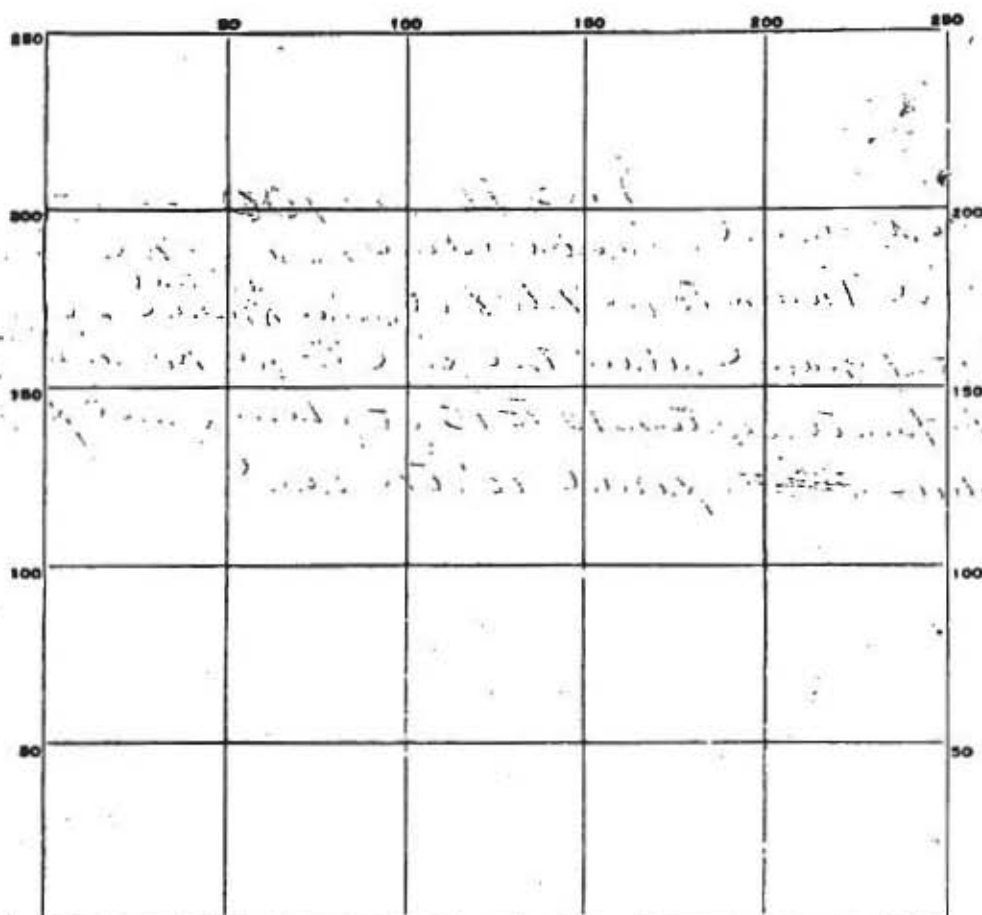

INDICATE NORTH. - NAME ADJOINING ROADWAY AS BASE LINE.

DATE	TEST NO.	DEPTH	PRE-WET		TEST - 1" DROP		TIME
			START	STOP	START	STOP	

SOIL AUGER FINDING _____

TESTED BY _____

REMARKS _____

SITE INSPECTION SHEET

OWNER: Tom Atwell

DATE REQUESTED: _____

PHONE #: 301-490-6579


CONTRACTOR: _____

ADDRESS: 11845 Lime Kiln Rd
Fulton 20759

WELL TAG #: _____

COUNTY #: _____

PROPOSAL: _____

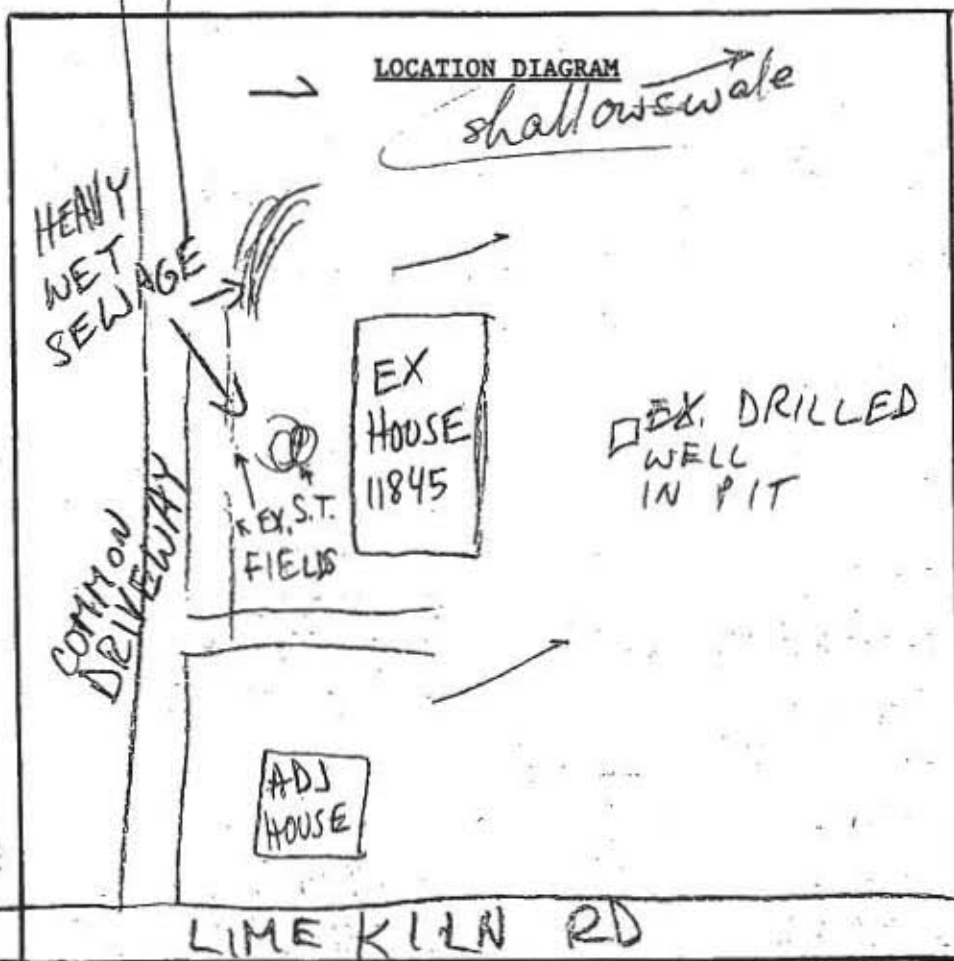

COMMENTS: _____

DATE: _____

INSPECTOR: _____

**FULTON
STATION**

RT.
216