

Building Permit Application

Howard County Maryland

Department of Inspections, Licenses and Permits 3430 Court House Drive

Permits: 410-313-2455 www.howardcountymd.gov

Date Received:	
Dute Headiveu.	

Permit No.:

		A A
Building Address: 6818 Real)	erry Koad	Property Owner's Name: \\ \( \lambda \) \\ \\ \\ \\ \\ \\ \\ \\ \\ \\ \\ \\
city: ClarkSVILL State: N		Address: USIS KEADENTI Ral.
	R 122	City: LIANKSVIVID State: MD Zip Code: LIO 29
Suite/Apt. #SDP/V		Phone: 443 - 878-8915 Fax: N/A  Fmail: KALLY, CASH & NETWACH COMA
Census Tract:	Subdivision:	Email: Kelly. cash @ not mail. com
Section: Area:	AND THE COURT OF THE PARTY OF T	1 en 1 au 3 (a) yan 00 · COM Applicant's Name & Mailing-Address, (If other than stated herein)
		Applicant's Name:
Tax Map: Parcel:		Address:
Zoning: Map Coordinate	es:Lot Size:	City: State: Zip Code:
		Phone:Fax:
Existing Use: <u>QVAGS</u> <u>AVEQ</u>		Email:
	ng of pole construction	Contractor Company:
Toposed use. VIOLUNE DUMAIL	TAN ON	Contact Person: VIIIA (IIX N
Estimated Construction Cost: \$ 201	VUU.UU	Address: Same as a Dove
Description of Work: CONSTRUCTIO	on of building (28x30)	Address:
for storage of ridin		License No. :
aavanalia taal-	PICO PALLIPHONE DI LAND	
	ccise equipment, & bikes	Email: Phone: Fax: Email: Phone: Fax: Phone: Fax: Fax: Fax: Fax: Fax: Fax: Fax: Fax
Occupant or Tenant:	V	Email Jerry des glasties e
Was tenant space previously occupied?	□Yes □No	Engineer/Architect Company: Th State Barn Buiders
Contact Name:		Responsible Design Prof.: AMOS Stoltzfus
Address:	,	Address: 1651 Mountain 2a.
City:S		City: New State: PA zip Code: 17240
		117. 221 0517 LIN
Phone:	rax:	Phone: 717-33/-8517 Fax: N/H
Email:		Email: amos@tristatebarn builders com
Commercial Building Characteristics	Residential Building Characteristics	Utilities
Height:	☐ SF Dwelling ☐ SF Townhouse	Water Supply .
No. of stories:	Depth Width	Public
Gross area, sq. ft./floor:	1 <sup>st</sup> floor:	☐ Private
Area of construction	2 <sup>nd</sup> floor:	Sewage Disposal
Area of construction (sq. ft.):	Basement:	Sewage Disposal
Use group:	☐ Finished Basement ☐ Unfinished Basement	☐ Public ☐ Private
Use group:	☐ Crawl Space	
Construction type:	☐ Slab on Grade	Electric: Yes No
Reinforced Concrete	No. of Bedrooms:	Gas: Yes No
☐ Structural Steel	Multi-family Dwelling	Heating System
☐ Masonry	No. of efficiency units:	□ Electric □ Oil
☐ Wood Frame	No. of 1 BR units:	□ Natural Gas □ Propane Gas
☐ State Certified Modular	No. of 2 BR units:	Other:
	No. of 3 BR units:	Sprinkler System:
	Other Structure:	Yes
D 0-1115	Dimensions:	111
Roadside Tree Project Permit	Footings:	Grading Posmit Number
Roadside Tree Project Permit #	Roof:	Grading Permit Number:
Roadside Tree Project Permit #	☐ State Certified Modular	D. W. W. Cl. H. D. C. C. C.
	☐ Manufactured Home	Building Shell Permit Number:
WITH ALL REGULATIONS OF HOWARD COUNTY	WHICH ARE APPLICABLE THERETO; (4) THAT HE/SHE OUNT OFFICIALS THE RIGHT TO ENTER ONTO THIS PR	TO MAKE THIS APPLICATION; (2) THAT THE INFORMATION IS CORRECT; (3) THAT HE/SHE WILL COMING WILL PERFORM NO WORK ON THE ABOVE REFERENCED PROPERTY NOT SPECIFICALLY DESCRIBED PROPERTY FOR THE PURPOSE OF INSPECTING THE WORK PERMITTED AND POSTING NOTICES.  Print Name  Date
Title/Company		
The Company		

Checks Payable to: DIRECTOR OF FINANCE OF HOWARD COUNTY

\*\*PLEASE WRITE NEATLY & LEGIBLY\*\*

-FOR OFFICE USE ONLY-DPZ SETBACK INFORMATION

AGENCY	DATE	SIGNATURE OF APPROVAL
State Highways		
Building Officials		
PSZA (Zoning)		
PSZA ( Engineering )		
Health	6-19-17	DBernauel

Is Sediment Control approval required for issuance? ☐ Yes ☐ No

 $\square$  CONTINGENCY CONSTRUCTION START

Green: PSZA,Zoning

Front: Rear: Side: Side St.: Historic District? ☐ Yes ☐No Lot Coverage for New Town Zone: SDP/Red-line approval date:

Filing Fee	\$
Permit Fee	\$
Tech Fee	\$
Excise Tax	\$
PSFS	\$
<b>Guaranty Fund</b>	\$
Add'l per Fee	\$
Total Fees	\$
Sub-Total Paid	\$
Balance Due	\$
Check	l‡


Distribution of Copies:

White: Building Officials

Yellow: PSZA, Engineering

Pink: Health

Gold: SHA

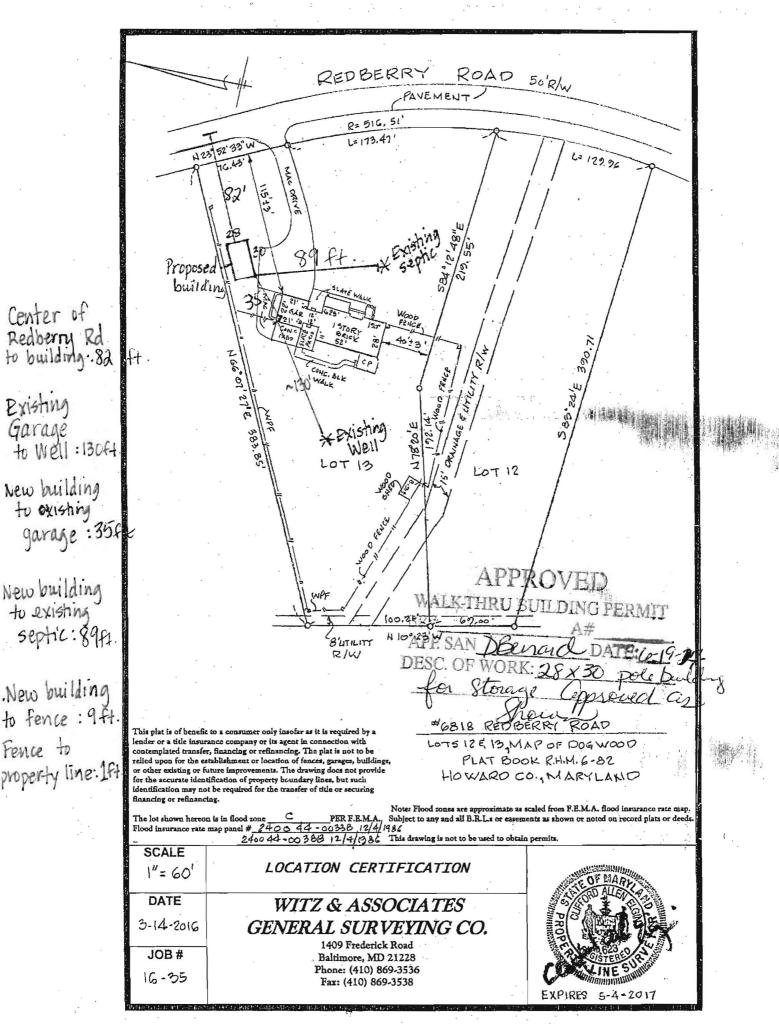

Existing

Fence to