


SITE INSPECTION SHEET

OWNER: Charles Brown PHONE #: _____
ADDRESS: 1015 River Rd CONTRACTOR: _____
Sykesville MD 21784 WELL TAG #: _____
SUBDIVISION: _____ LOT: _____ COUNTY #: _____
PROPOSAL: Verify well location and setback distance of well from house and proposed addition

LOCATION DIAGRAM

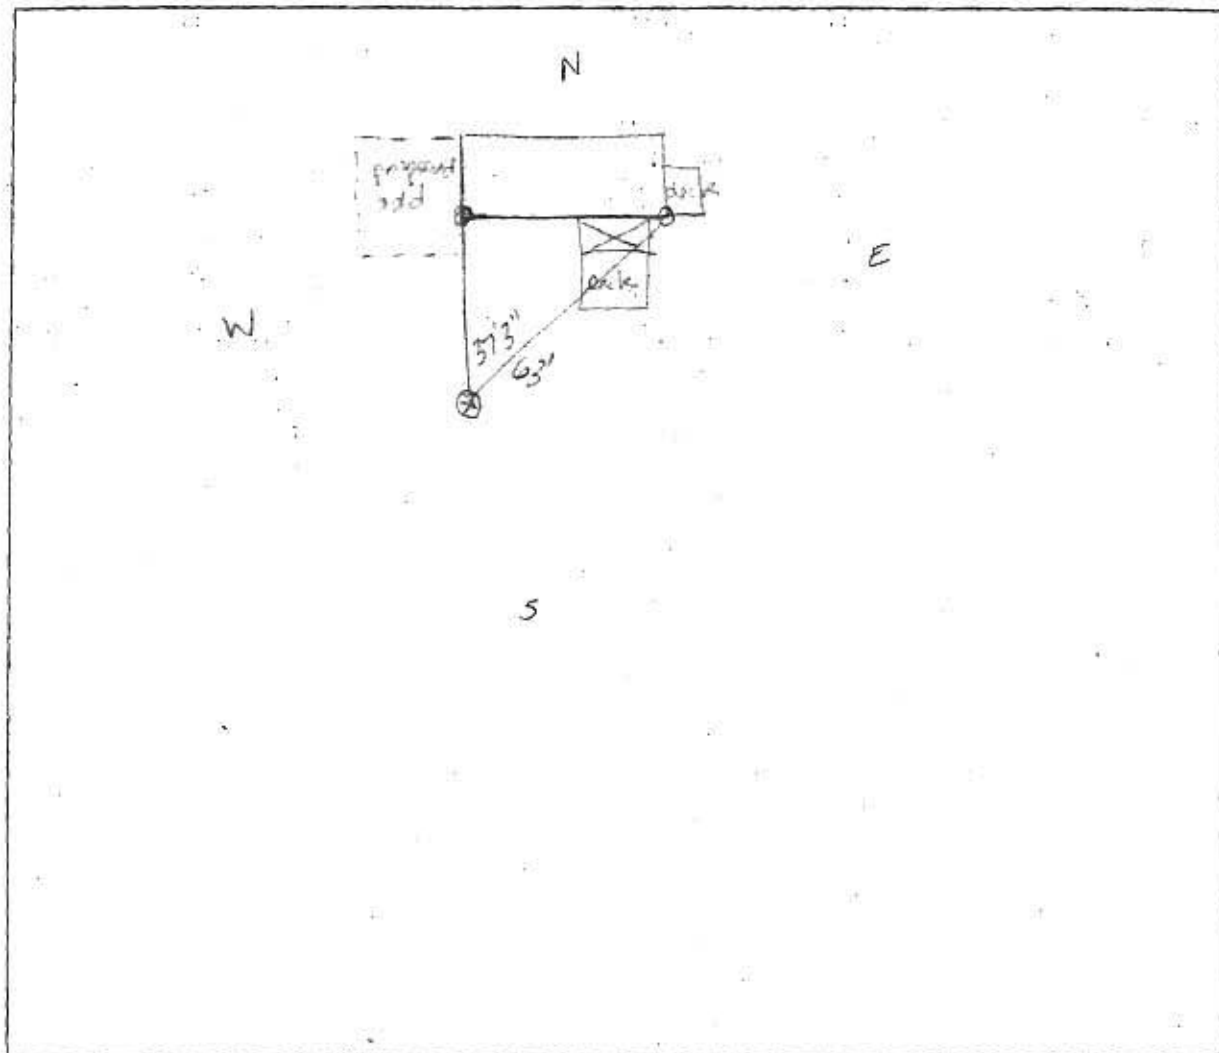

COMMENTS: Well located 37'3" from "W" corner of house.
The addition can extend no more than 7'
behind back of house in order to maintain the
30' setback distance. (SF)

DATE: 6/23/05 INSPECTOR: SF



RIVER ROAD
N 30° 09' 38" E 140'



THE PROPERTY SHOWN HEREON DOES NOT LIE WITHIN THE BOUNDARIES OF ANY FLOOD ZONE AS DESIGNATED ON THE FLOOD INSURANCE RATE MAP, COMMUNITY PANEL NO. 240044 0009 D DATED DEC. 4, 1986.

BEING KNOWN & DESIGNATED AS LOT 13, SECTION 2, RIVER PARK ESTATES, AS SHOWN ON PLAT OF SECTION 2 RIVER ROAD ESTATES, RECORDED IN PLAT BOOK WHH B-51.

I HEREBY CERTIFY THAT I HAVE MADE A SURVEY OF THIS LOT FOR THE PURPOSE OF LOCATING THE IMPROVEMENTS THEREON AND THAT THEY ARE LOCATED AS SHOWN.

REG. NO. 449

**W.T. SADLER
SURVEYORS**

152 WESTMINSTER ROAD
REISTERSTOWN, MD
21136
(410) 526-5618



LOCATION SURVEY

1015 RIVER ROAD

3RD DISTRICT, HOWARD CO., MD.

SCALE

1"=50'

DATE

5-6-1994

APP. NO.

JOB NO.
J-6003

REUSED Drawing
6/23/05

300154328

6/16/05

Proposed add. must main.
30' separation from well

~~high add. of 10' separation~~
~~septic must be upgraded~~
~~Code Building Permit~~
~~Structure 14~~
Lot

(KTB)

LOT 13
44,100 sq ft

FRAME SHED
5' UTILITY EASEMENT
POST & RAIL FENCE
N 30° 09' 38" E 140'

6/23/05

- Proposed garage
OK - site inspection done

SF 6/23/05 - RJB