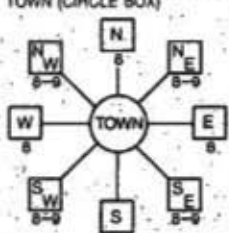
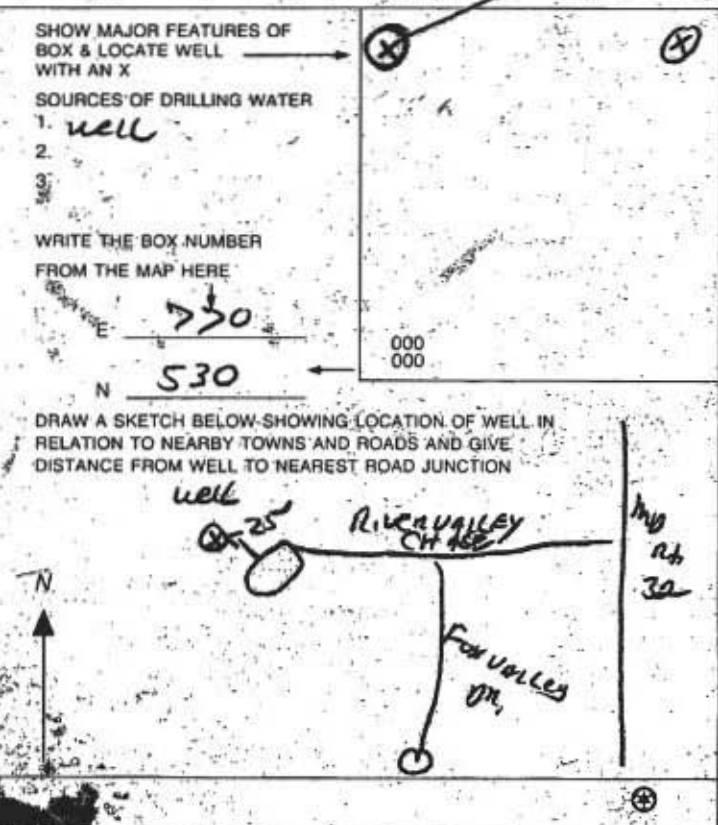


[illegible]

B 1	4700	SEQUENCE NO. (MDE USE ONLY)	STATE OF MARYLAND PERMIT TO DRILL WELL please print or type	STATE PERMIT NUMBER
Date Received (APA) 10/20/98			fill in this form completely	
OWNER INFORMATION			LOCATION OF WELL	
15 Last Name: WALSH 34 First Name: TIMOTHY C 36 Street or RFD: 3192 River Valley Chase 57 Town: West Friendship MD 21794 70 State: MD 72 Zip: 21794			8 COUNTY: Howard 23 SUBDIVISION: 3192 River Valley Chase SECTION 1 LOT 18 52 NEAREST TOWN: West Friendship MILES FROM TOWN (enter 0 if in town) I M I	
DRILLER INFORMATION			B 4	
Driller's Name: Ralph Mayne License No.: MSD 116 Firm Name: Ralph Mayne Well Drilling Address: 9120 Brown Church Rd Mt Airy Signature: Ralph Mayne Date: 10/2/98			1 2 DIRECTION OF WELL FROM TOWN (CIRCLE BOX)  11 NEAR WHAT ROAD: River Valley Chase ON WHICH SIDE OF ROAD (CIRCLE APPROPRIATE BOX) 34 25 37 DISTANCE FROM ROAD: 25 ENTER FT OR MI: Ft TAX MAP: BLK: PARCEL:	
B 2 WELL INFORMATION			NOT TO BE FILLED IN BY DRILLER HEALTH DEPARTMENT APPROVAL	
APPROX. PUMPING RATE (GAL. PER MIN.): 5 AVERAGE DAILY QUANTITY NEEDED (GAL. PER DAY): 500			COUNTY NAME: COUNTY NO.: STATE SIGNATURE: INSERT S: 41 DATE ISSUED: 43 MM DD YY 48 CO SIGNATURE: EXP. DATE: NORTH GRID: 50 000 EAST GRID: 57 000	
USE FOR WATER (CIRCLE APPROPRIATE BOX)			SHOW MAJOR FEATURES OF BOX & LOCATE WELL WITH AN X	
☒ DOMESTIC POTABLE SUPPLY & RESIDENTIAL IRRIGATION ☐ FARMING (LIVESTOCK WATERING & AGRICULTURAL IRRIGATION) ☐ INDUSTRIAL, COMMERCIAL, DEWATERING ☐ PUBLIC WATER SUPPLY WELL ☐ TEST, OBSERVATION, MONITORING ☐ GEO-THERMAL			SOURCES OF DRILLING WATER 1. well 2. 3.	
APPROXIMATE DEPTH OF WELL: 150 FEET			WRITE THE BOX NUMBER FROM THE MAP HERE: 530	
APPROXIMATE DIAMETER OF WELL: 6" INCH			DRAW A SKETCH BELOW SHOWING LOCATION OF WELL IN RELATION TO NEARBY TOWNS AND ROADS AND GIVE DISTANCE FROM WELL TO NEAREST ROAD JUNCTION	
METHOD OF DRILLING (circle one)				
BORED (or Augered) JETTED Jetted & DRIVEN ☒ AIR-ROTARY AIR-PERCUSION ROTARY (Hydraulic Rotary) 30 CABLE REVERSE-ROTARY DRIVE-POINT 37 other:				
REPLACEMENT OR DEEPENED WELLS (CIRCLE APPROPRIATE BOX)				
☐ THIS WELL WILL NOT REPLACE AN EXISTING WELL ☐ THIS WELL WILL REPLACE A WELL THAT WILL BE ABANDONED AND SEALED ☒ THIS WELL WILL REPLACE A WELL THAT WILL BE USED AS A STANDBY-CONTACT LOCAL APPROVING AUTHORITY FOR POLICY ON STANDBY WELLS ☐ THIS WELL WILL DEEPEAN AN EXISTING WELL				
PERMIT NUMBER OF WELL TO BE REPLACED OR DEEPEANED (IF AVAILABLE):				
Not to be filled in by driller (MDE OR COUNTY USE ONLY)				
APPROX. PERMIT NUMBER: 54				
PERMIT NO.: 70 71 72 73 74 75 76 77 78 79				
SPECIAL CONDITIONS				

9-4-96 W.S.I., SITE NOT STAKED

11/2/98 well site not stalked ^{OK}
(KRM)

9-19-96
WSI OK
AS STAKED

100% ~~Sanitarian~~

2nd well location

10' Public
Mainten-
Easer:

NOTES - LOTS - 16 =

- 1.) Provide dipped
- 2.) Provide positive
- 3.) Salt Fence to be

Handwritten signature: *James M. Smith*

[Handwritten notes:]
W. J. Miller
R. M. YAJE
the ...
Cbd ...

240279
7/10/79
Preservat

10/12/19



HOWARD COUNTY HEALTH DEPARTMENT

49019

DATE
10/28/98

WS 11055

Received
From

Timothy C. Walsh

3192 River Valley Chase W. Friendship Md

For

Well Permit Application - Replacement

3192 River Valley Chase

☐ CASH

☒ CHECK

NO.

179

Eighty and

25/100


Dollars

\$

80 10


Received By

H. Jane Roper

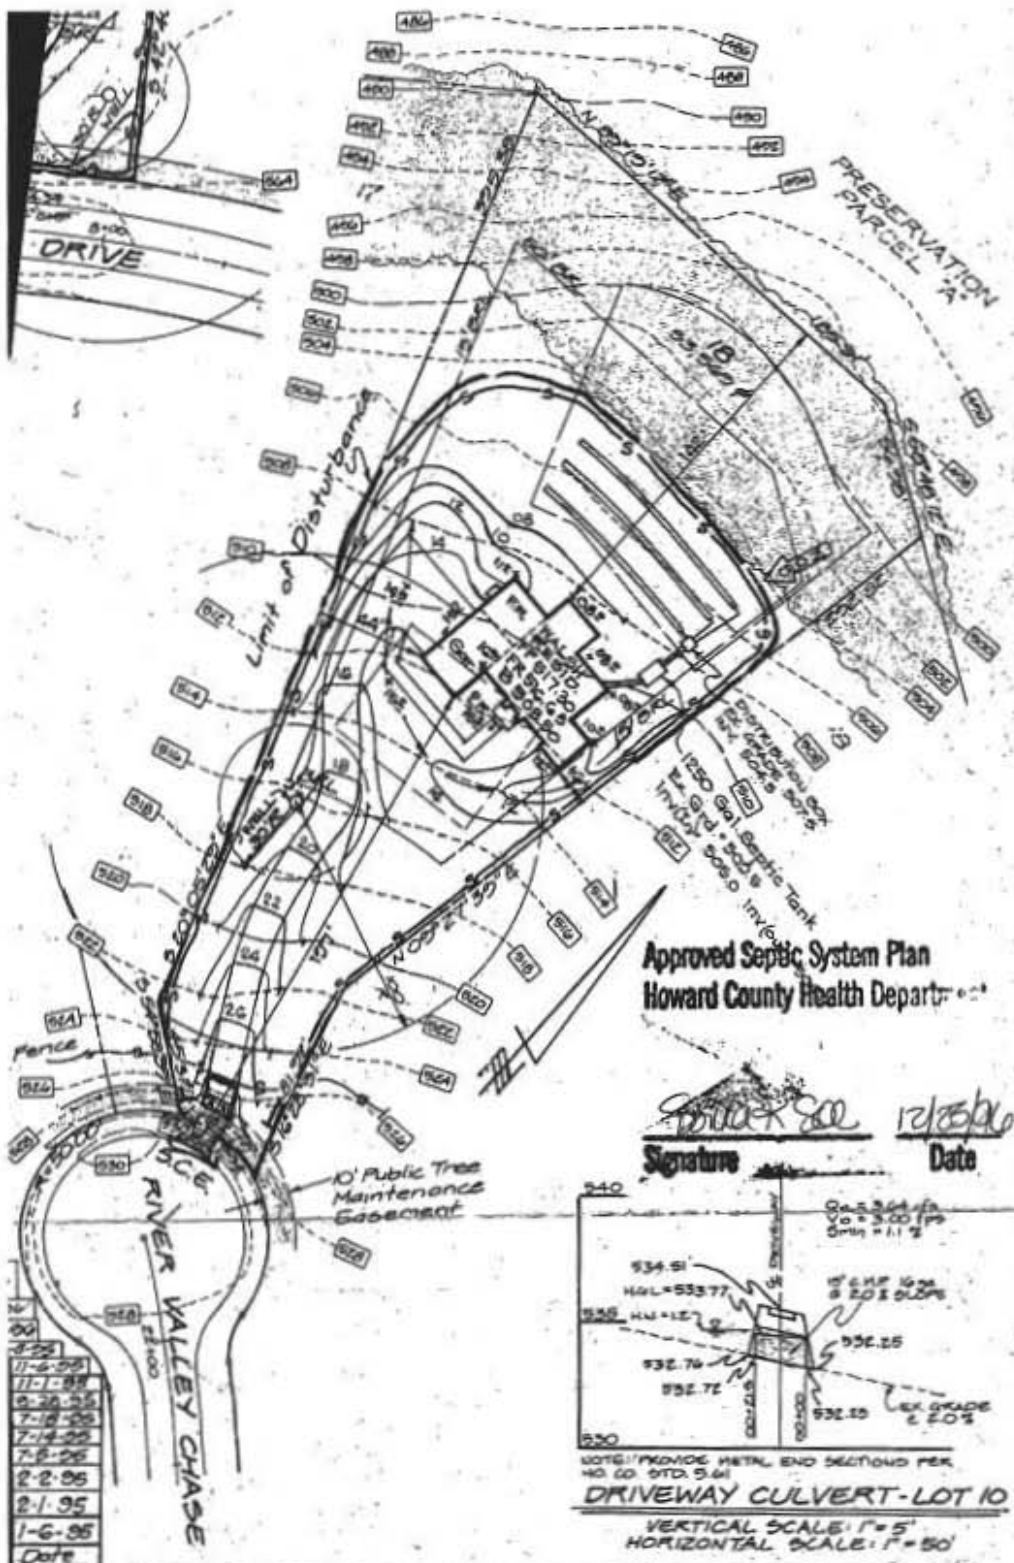

11-6-95
11-7-95
2-26-96
7-14-96
7-8-96
2-2-96
2-1-95
1-6-95
Date

 CLARK • FINEFROCK & SACKETT, INC. ENGINEERS • PLANNERS • SURVEYORS 7135 MINISTREL WAY • COLUMBIA, MD. 21045 • (410) 381-7500 - BALTO. • (301) 621-8100 - WASH.		
DESIGNED	SITE DEVELOPMENT, SEDIMENT AND EROSION CONTROL PLAN LOTS 4, 5, 9 thru 11, 15, 35 WEST FRIENDSHIP ESTATES SECTION 1 3RD ELECTION DISTRICT HOWARD COUNTY, MARYLAND For DORSEY CONTRACTORS, INC. 13090 Old Frederick Road Sykesville, MD 21784	SCALE
RMT		1" = 50'
DRAWN		DRAWING
MCR		1 OF 1
CHECKED		JOB NO.
JME		24-102
DATE		FILE NO.
Oct 18, 1994		24-102 X

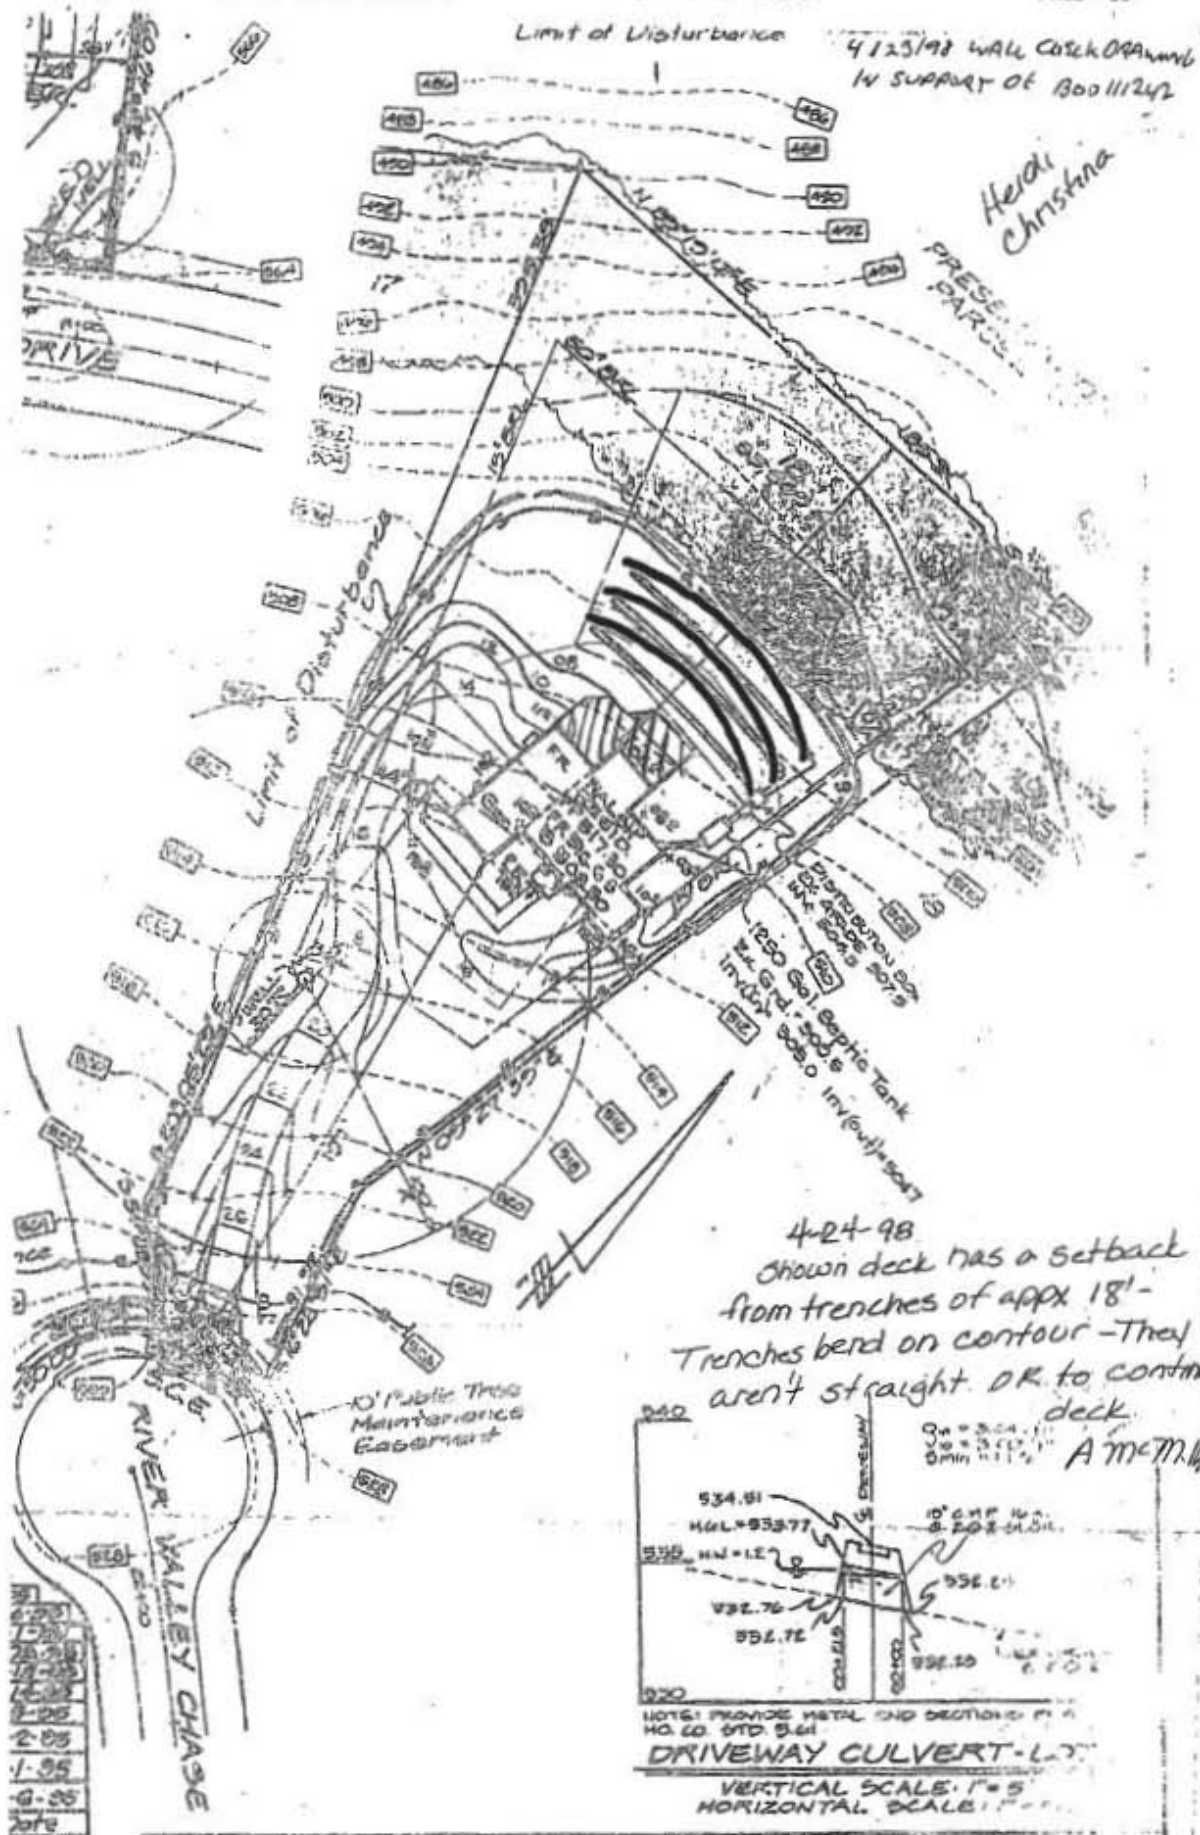

CLARK • FINEFROCK & SACKETT, INC.
ENGINEERS • PLANNERS • SURVEYORS

7125 MINSTREL WAY • COLUMBIA, MD. 21045 • (410) 361-7500 - BALTO. • (301) 621-5111

DESIGNED

ALTA DEVELOPMENT, SEDIMENT

