LAYOUT	1000	INSP 4		
INSP 2	TE SA	INSP 5		
INSP 3		INSP 6		
ISSUE DATE:	10/3/08	PERMIT	P	529584
APPROVAL DATE:		TERMIT	A	REPAIR
	0.11.01	TAX ID#		

ON-SITE SEWAGE DISPOSAL SYSTEM
HOWARD COUNTY HEALTH DEPARTMENT
BUREAU OF ENVIRONMENTAL HEALTH
MINOR SEPTIC REPAIR

Gina and Charles Brow	n	_ IS PER	MITTED TO I	NSTALL [☑ ALTER □	
ADDRESS: 1015 R	iver Rd		PHONE NUMB	ER: 410-	442-3712	
SUBDIVISION:			LOT NUMBER:			
ADDRESS: 1015 R	_ PROPE	PERTY OWNER: Charles and Gina Brown				
SEPTIC TANK CAPAC	CITY (GALLONS):	Existing	OUTLET BAFF	LE FILTER	REQUIRED	
PUMP CHAMBER CA	PACITY (GALLONS):	200	COMPARTMEN	TED TANK	REQUIRED 🖾	
NUMBER OF BEDRO	OMS:					
SQUARE FEET PER B	EDROOM:					
LINEAR FEET OF TR	ENCH REQUIRED:					
TRENCHES:					E SHELVE	
LOCATION:	Septic line between the exist	ing septic t	ank and existing d	lrywell		
NOTES:	Septic line between the tank and drywell has cracked causing flow problems for homeowners, needs replacing.					
PLANS APPROVED:	SS	4.7		DATE:	10/3/08	

NOTE: PERMIT VOID AFTER 2 YEARS

NOTE: CONTRACTOR RESPONSIBLE FOR SCHEDULING A PRE-CONSTRUCTION INSPECTION FOR ALL INSTALLATIONS

NOTE: WATERTIGHT SEPTIC TANKS REQUIRED

NOTE: ALL PARTS OF SEPTIC SYSTEM SHALL BE 100 FEET FROM ANY WATER WELL

NOTE: MANHOLE RISERS REQUIRED ON ALL SEPTIC TANKS AND PUMP CHAMBERS UNLESS SPECIFICALLY AUTHORIZED

NEITHER THE HOWARD COUNTY COUNCIL NOR THE HEALTH DEPARTMENT IS RESPONSIBLE FOR THE SUCCESSFUL OPERATION OF ANY SYSTEM PERMITTEE RESPONSIBLE FOR OBTAINING FINAL APPROVAL ON THIS PERMIT CALL 410-313-1771 FOR INSPECTION OF SEPTIC SYSTEM 12/23/93. Or pour

PERMIT

PERMII SEWAGE DISPOSAL SYSTEM P 33416

A Repair

MARYLAND STATE DEPARTMENT OF HEALTH'

HOWARD COUNTY
BUREAU OF ENVIRONMENTAL HEALTH
992-2330

03-281868 INDEX

DISTRICT 3xd

DATE 12/23/83

Jack Fyock	IS PERMITTED TO INSTALLALTERX
ADDRESS 13775 Triadelphia	Road, Gleneig, Md. 21737 PHONE 988-9270
SUBDIVISION	ROAD 1015 River Road LOT / 5 Seet
PROPERTY OWNER Nr. James	Yim ONE PAR
ADDRESS 1015 River Road, S	Sykesville, Maryland 21784
IF GARBAGE GRINDER IS USED INCREAS	SE SEPTIC TANK CAPACITY BY 50% AND ABSORPTION AREA BY 22%.
GARBAGE GRINDER? YES	NO L
SEPTIC TANK CAPACITY	GALLONS NUMBER OF BEDROOMS
REPAIR - Call for ins	pection when ground is opened up and Sanitarian will
regonwend th	e repair system.
BUILDING PERMIT	SIGNED
AND RETURN	
623 05 BOD 15432 GA	UBS B
PLANS APPROVED BY Frank A.	Skinner DATE 12/21/83
COVER NO WORK UNTIL INSPECTED AND APP	ROVED.
NEITHER THE HOWARD COUNTY COUNCIL NO	R THE HEALTH DEPARTMENT IS RESPONSIBLE FOR THE SUCCESSFUL OPERATION OF ANY SYSTEM.
NOTE: IF TRENCH IS USED CALL FOR INSPE	CTION BEFORE AND AFTER PLACING GRAVEL IN TRENCH
NOTE: NO DRY WELL SHALL EXCEED 15 FO	OT IN DIAMETER. NO ABSORPTION TRENCH TO EXCEED 100 FEET IN LENGTH,
NOTE: ALL PIPE FROM HOUSE TO SEPTIC TO	ANK MUST BE CAST IRON OR SCHEDULE 40 PVC OR ABS.
PERMIT VOID AFTER THREE YEARS.	
NOTE: INSTALL STAND PIPE ON SEPTIC TAN	IX AND DRY WELL. STAND PIPES MUST BE 6 INCHES IN DIAMETER, CAST IRON, CONCRETE OR TERRA COTTA, O
PVC OR ABS ACCEPTED, IF TOP OF S	SEPTIC TANK IS DEEPER THAN 3 FEET MANHOLE TO GRADE REQUIRED.

*INSTALLER IS RESPONSIBLE FOR OBTAINING FINAL APROVAL ON THIS PERMIT


*CALL 992-2330 FOR INSPECTION OF SEPTIC SYSTEMS.

EH - 2-1082

X 33416

150 11-1156 100 NAME ADJOINING HOADWAY AT BASE LINE.

				PERMITSICNED	DELLERING
SEPTIC TANK	K, LEVEL		CLEANOUTS		
	N BOX LEVEL #		#1/1/2	Land of the land o	
TILE FIELD,	DEPTH	THENCH WID	тн	777	
	NUMBER OF TRENCH	7	TOTAL BOTTOM	AREA 2 4 25	7 =633
	TS, INSIDE DIAMETER		DEPTH BELOW	<i>i i</i>	
	ABSORBENT AREA	sq.	PT.		
REMARKS	LLA	11116 BC	2-5	A8492 1 TI	THAVE Z
1 1	age Eq. 1	200 / 200	1		
250	432	- VL	12-7 5	20072	
- 70	o ver	160	filler is	1	
			7		
					-
	у -	1300	7	70 1	W Can
DATE SYSTE	M APPROVED	1	INSPECTOR	MAND MELL	1 Charles

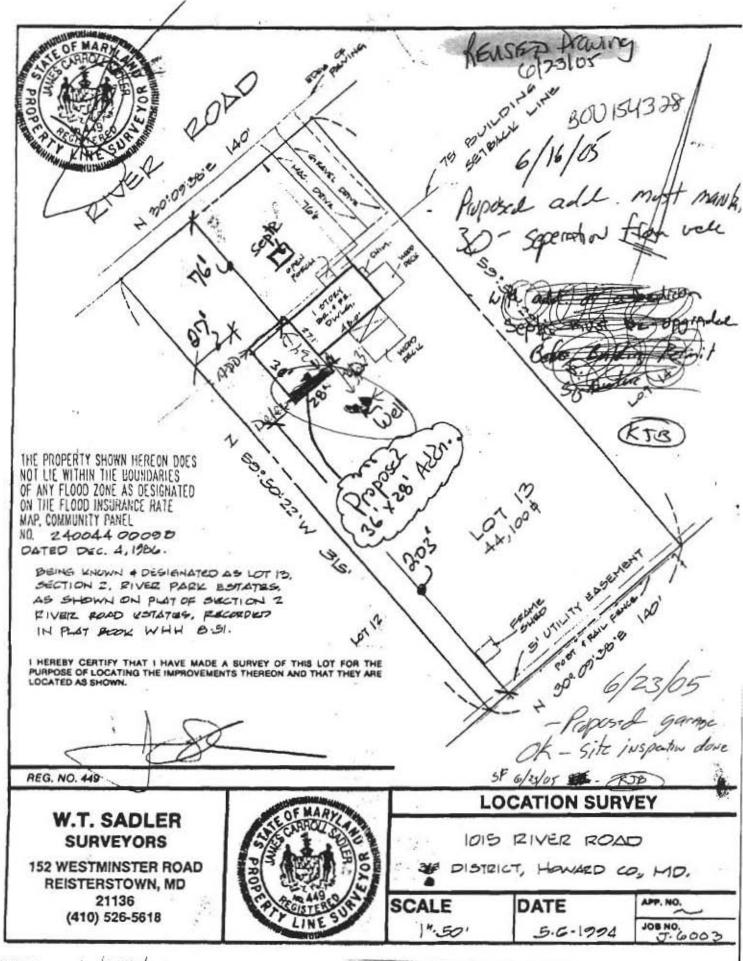

DATE: 6/23/05

INSPECTOR:

CF