

05-385091

## PERMIT

SEWAGE DISPOSAL SYSTEM

MARYLAND STATE DEPARTMENT OF HEALTH\*

HOWARD COUNTY

ELLICOTT CITY

DISTRICT 5th

DATE 4/2/81

INDEX

Oskar Schulz

IS PERMITTED TO INSTALL ☒ ALTER

ADDRESS 6610 Blackwatch Lane, Highland, Md. 20777

PHONE

SUBDIVISION Highland Lake

ROAD 6544 River Clyde Drive LOT 86, Sec. 3

PROPERTY OWNER Oskar Schulz

ADDRESS same as above

SPECIFICATIONS 4 Bedrooms

SEPTIC TANK CAPACITY 1250 GALLONS

DRAIN FIELD DEPTH FEET. BOTTOM AREA SQ. FT.

DEEP TRENCH DEPTH FEET. BOTTOM AREA SQ. FT.

DRY WELL

SEEPAGE PITS ☒ ABSORBENT SIDE-WALL AREA 120 SQ. FT. per bedroom

INLET PIPE 3 FT. BELOW ORIGINAL GRADE. MAXIMUM DEPTH 9 FT. BELOW ORIGINAL GRADE

EFFECTIVE DEPTH AT FT. BELOW ORIGINAL GRADE

LOCATE DISPOSAL AREA 50 FT. FROM front LOT LINE AND 60 FT. FROM right LOT LINE AS SEEN WHEN  
FACING LOT FROM River Clyde Drive.BUILDING PERMIT SIGNED  
AND RETURNED

04/17/81 - 800148976 - Screened Poreh

PLANS APPROVED BY Frank Skinner

DATE 12/17/80

COVER NO WORK UNTIL INSPECTED AND APPROVED.

NEITHER THE HOWARD COUNTY COUNCIL NOR THE HEALTH DEPARTMENT IS RESPONSIBLE FOR THE SUCCESSFUL OPERATION OF ANY SYSTEM.

NOTE: IF TRENCH IS USED CALL FOR INSPECTION BEFORE PLACING GRAVEL IN TRENCH.

NOTE: NO DRY WELL SHALL EXCEED 15 FOOT IN DIAMETER.


NOTE: ALL PIPE FROM HOUSE TO DISPOSAL AREA MUST BE CAST IRON.

PERMIT VOID AFTER THREE YEARS.

NOTE: INSTALL STAND PIPE ON SEPTIC TANK AND DRY WELL. STAND PIPES MUST BE 6 INCHES IN DIAMETER. CAST IRON, CONCRETE OR TERRA  
COTTA ACCEPTED.

\*INSTALLER IS RESPONSIBLE FOR OBTAINING FINAL APPROVAL ON THIS PERMIT.

1107046

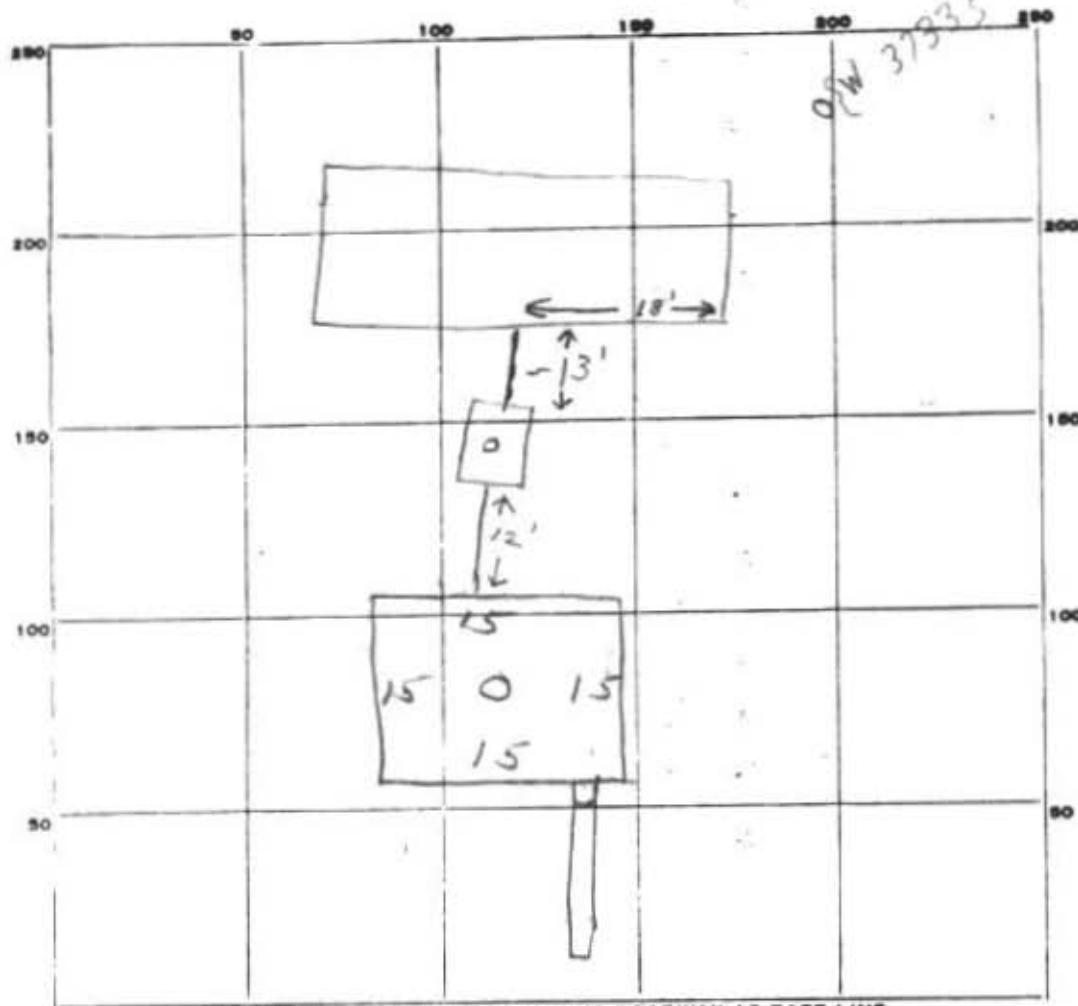

INDICATE NORTH - NAME ADJOINING ROADWAY AS BASE LINE.

PERMIT CARD ✓ River Clyde Dr. C.I. S.T. C.I. D.W.

SEPTIC TANK, LEVEL ✓ CLEANOUTS ✓ ✓

DISTRIBUTION BOX, LEVEL ✓ AND RETURNED

TILE FIELD, DEPTH 9 FT. TRENCH WIDTH 2 FT.

GRAVEL DEPTH 7' 900 IN. TOTAL LENGTH 20 FT. 120

NUMBER OF TRENCHES 1 TOTAL BOTTOM AREA 360

SEEPAGE PITS, INSIDE DIAMETER 60 FT. DEPTH BELOW INLET 6 FT. 360

ABSORBENT AREA 480 SQ. FT.

REMARKS 6/26/81 OK to add stone in trench.

OK to cover septic + drywell after cleanouts are on.

6/30/81 SYSTEM - PARTIAL - NEED HOUSE CONNECTION; OK TO

COVER TRENCH; DRYWELL AND SEPTIC TANK TO 1' OF END CLOSE

TO HOUSE. 9/14/81 Final OK. JS

C.R.V.

DATE SYSTEM APPROVED 9/14/81 INSPECTOR Stamen