

APPLICATION

A 246-46

SEWAGE DISPOSAL TESTING

P _____

STATE OF MARYLAND - DEPARTMENT OF HEALTH AND MENTAL HYGIENE

HOWARD COUNTY HEALTH DEPARTMENT
ENVIRONMENTAL HEALTH SERVICES

P. O. BOX 476, ELLICOTT CITY, MARYLAND 21043
TELEPHONE: 465-5000, EXT. 356

3 B.R. 1000 gal. Septic tank DISTRICT Fifth

4 B.R. 1250 gal. Septic tank DATE 9/15/76

Drywell to have 120 SQ. FT. effective sidewall absorption area per bedroom below unit pipe. Drywell inlet at 3 ft. below original grade. Maximum depth of drywell is 9 ft. below original grade. Place the drywell 50 ft. from the front lot line and 60 ft. from the right side line as seen when facing the property from River Clyde Drive.

TO: THE COUNTY HEALTH OFFICER
ELLICOTT CITY, MARYLAND

I, HEREBY, APPLY FOR THE NECESSARY TEST IN ORDER TO CONSTRUCT (OR RECONSTRUCT) A SEWAGE DISPOSAL SYSTEM.

Oskar Schulz, Inc.

PROPERTY OWNER Mr. Walter Bucher

ADDRESS Highland Partnership
8777 First Avenue PHONE (8) 388-3100
Silver Spring, MD 20901

PROPERTY LOCATION:

SUBDIVISION Highland Lake LOT NO. 109 # 107 86

ROAD AND DESCRIPTION Court Road G.P. 45301 old cert 11/1/8

6544 River Clyde Drive

SIZE OF LOT one acre m/l TYPE BLDG. 4 Bedrooms
3 or 4 bedroom
NUMBER OF BEDROOMS

IF NOT SINGLE RESIDENCE DESCRIBE _____

THE SYSTEM INSTALLED UNDER THIS APPLICATION IS ACCEPTABLE ONLY UNTIL PUBLIC FACILITIES BECOME AVAILABLE.

SIGNATURE OF APPLICANT for Mr. Walter Bucher

APPROVED BY Frank Skinn FOR Dr. J. J. Skinn DATE 12/17/80
(KIND OF SYSTEM)

REJECTED BY _____ FOR _____ DATE _____
(KIND OF SYSTEM)

HOLD PENDING FURTHER TESTS _____ DATE _____

REASONS FOR REJECTION OR HOLDING _____

THIS IS NOT A PERMIT

A24046

INDICATE NORTH. - NAME ADJOINING ROADWAY AS BASE LINE

DATE	TEST NO.	DEPTH	PRE-WET		TEST - 1" DROP		TIME
			START	STOP	START	STOP	
4-1	1	3'	10.50	10.52	10.52	10.55	3.00
	2	12.2'	10.55	10.58	10.58	10.60	3.00
	3	4'	10.58	10.60	10.60	10.62	3.00
	(E) 4		10.60	10.62	10.62	10.65	3.00
		5'	10.65	10.68	10.68	10.70	3.00
		11'	10.70	10.72	10.72	10.75	3.00
		12'	10.75	10.78	10.78	10.80	3.00
						6.16	


Unit =

3m

REMARKS _____

TYPE OF SOIL _____

TESTED BY _____ ALSO PRESENT: _____

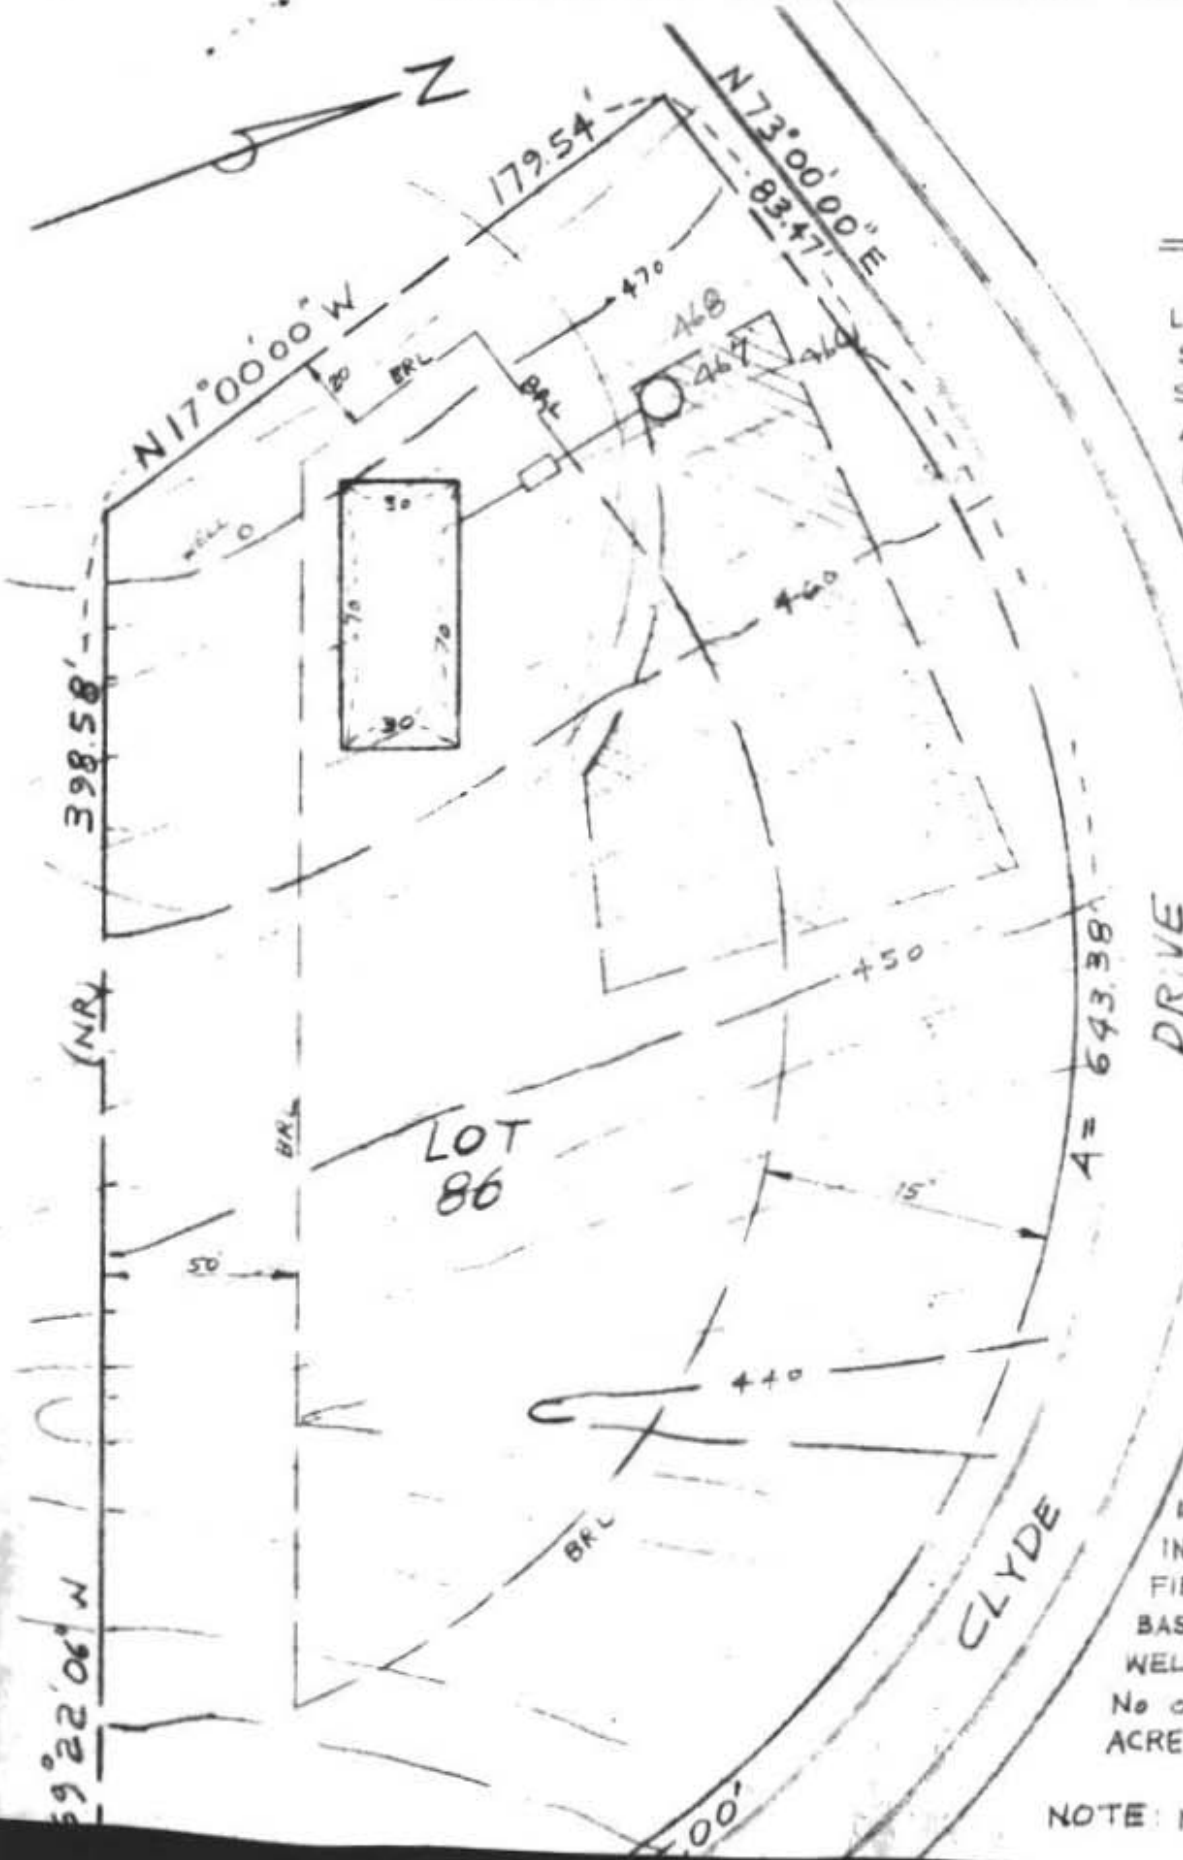

SITE PLAN


RIVER CLYDE DRIVE
LOT 86
SHEET 1001
SECTION III
AREA I
HIGHLAND LAKE
ELECT. DIST 5
HOWARD CO., MD.

12/17/80
Sketch O.K.
J. S.

DRY WELL DATA

INV. IN DRYWELL	463.5
INV. OUT SEPTIC TANK	464.1
INV. IN SEPTIC TANK	464.4
INV. OUT DWELLING	464.96
FIRST FLOOR ELEV.	471.00
BASEMENT ELEV	463.00
WELL ELEV.	470.5
No of BEDROOMS	4
ACREAGE	2.1815 Ac

NOTE: NO PLUMBING IN BASEMENT

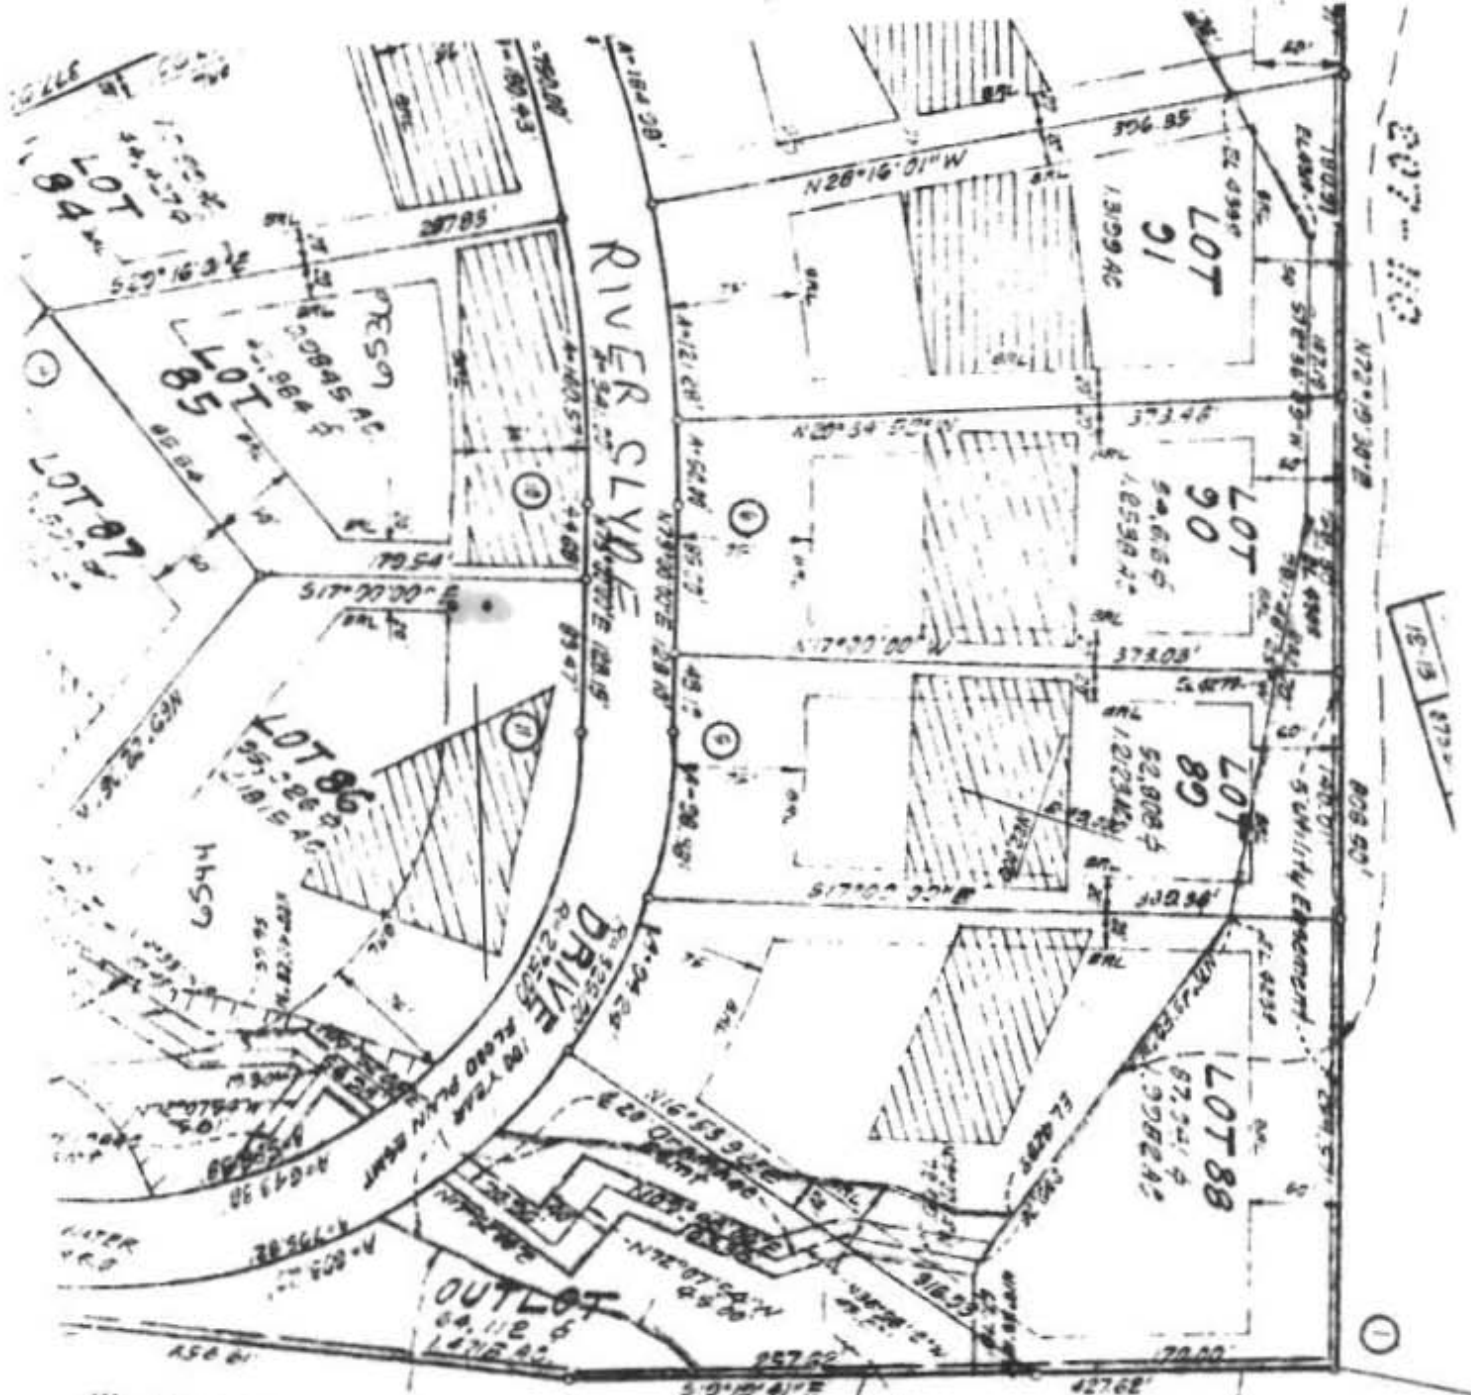

B GREENE

HENRY H. HARTES

100 YEAR FLOOD PLAIN, PARK
DRAINAGE & UTILITY ESENT. ELEV. 439.9

520-450
487-115

Highland
Sec. 3
Area I

10-18-77

A24C39

