

APPLICATION

SEWAGE DISPOSAL TESTING

STATE OF MARYLAND - DEPARTMENT OF HEALTH AND MENTAL HYGIENE

HOWARD COUNTY HEALTH DEPARTMENT
ENVIRONMENTAL HEALTH SERVICES

P.O. BOX 476, ELLICOTT CITY, MARYLAND 21043
TELEPHONE: 465-5000, EXT. 356

A 28388

P _____

DISTRICT 3rd

DATE 7/5/78

TO: THE COUNTY HEALTH OFFICER
ELLICOTT CITY, MARYLAND

I, HEREBY, APPLY FOR THE NECESSARY TEST IN ORDER TO CONSTRUCT (OR RECONSTRUCT) A SEWAGE DISPOSAL SYSTEM.

PROPERTY OWNER John M. Harris property

5C10 ADDRESS _____ PHONE 795-0606

PROPERTY LOCATION _____

SUBDIVISION _____ LOT NO. _____

ROAD AND DESCRIPTION River Road and Route 32

950 Aiven Rd.

SIZE OF LOT ? TYPE BLDG. 3 or 4 bedrooms
NUMBER OF BEDROOMS

IF NOT SINGLE RESIDENCE DESCRIBE _____

THE SYSTEM INSTALLED UNDER THIS APPLICATION IS ACCEPTABLE ONLY UNTIL PUBLIC FACILITIES BECOME AVAILABLE.

SIGNATURE OF APPLICANT /s/ Pat Lendrim

APPROVED BY G. Keller FOR Drywell DATE 7/27/78
(KIND OF SYSTEM)

REJECTED BY _____ FOR _____ DATE _____
(KIND OF SYSTEM)

HOLD PENDING FURTHER TESTS _____ DATE _____

REASONS FOR REJECTION OR HOLDING _____

BLDG. PERMIT SIGNED
AND RETURNED 6/4/87

BP 12323
8/16

THIS IS NOT A PERMIT

RT
32

see
ATTACHED
7/23/78

INDICATE NORTH - NAME ADJOINING ROADWAY AS BASE LINE

River Road

DATE	TEST NO.	DEPTH	PRE-WET		TEST - 1" DROP		TIME
			START	STOP	START	STOP	
7/26/78	35	8	1558	1603	1603	1609	6
	30 - low	12'	1555	1559	1559	1605	6
	43	4'	1542	1546	1546	1551	5
	40	13'	1540	1541	1541	1542	1
	53	5' B	1532	1538	1538	1549	9
	50 - high	14' B	1532	1537	1537	1543	6
	2	10'	visual		see profile		
	40	13	1547	1549	1549	1551	2
	Refill						

good soil
at 4'


Take high hole
TIME = 7.5 min
+ 2070 = 9.0
= 130 ft/or

REMARKS Backhoe trouble at 2:00 7/26/78

TYPE OF SOIL _____

TESTED BY _____

ALSO PRESENT: _____

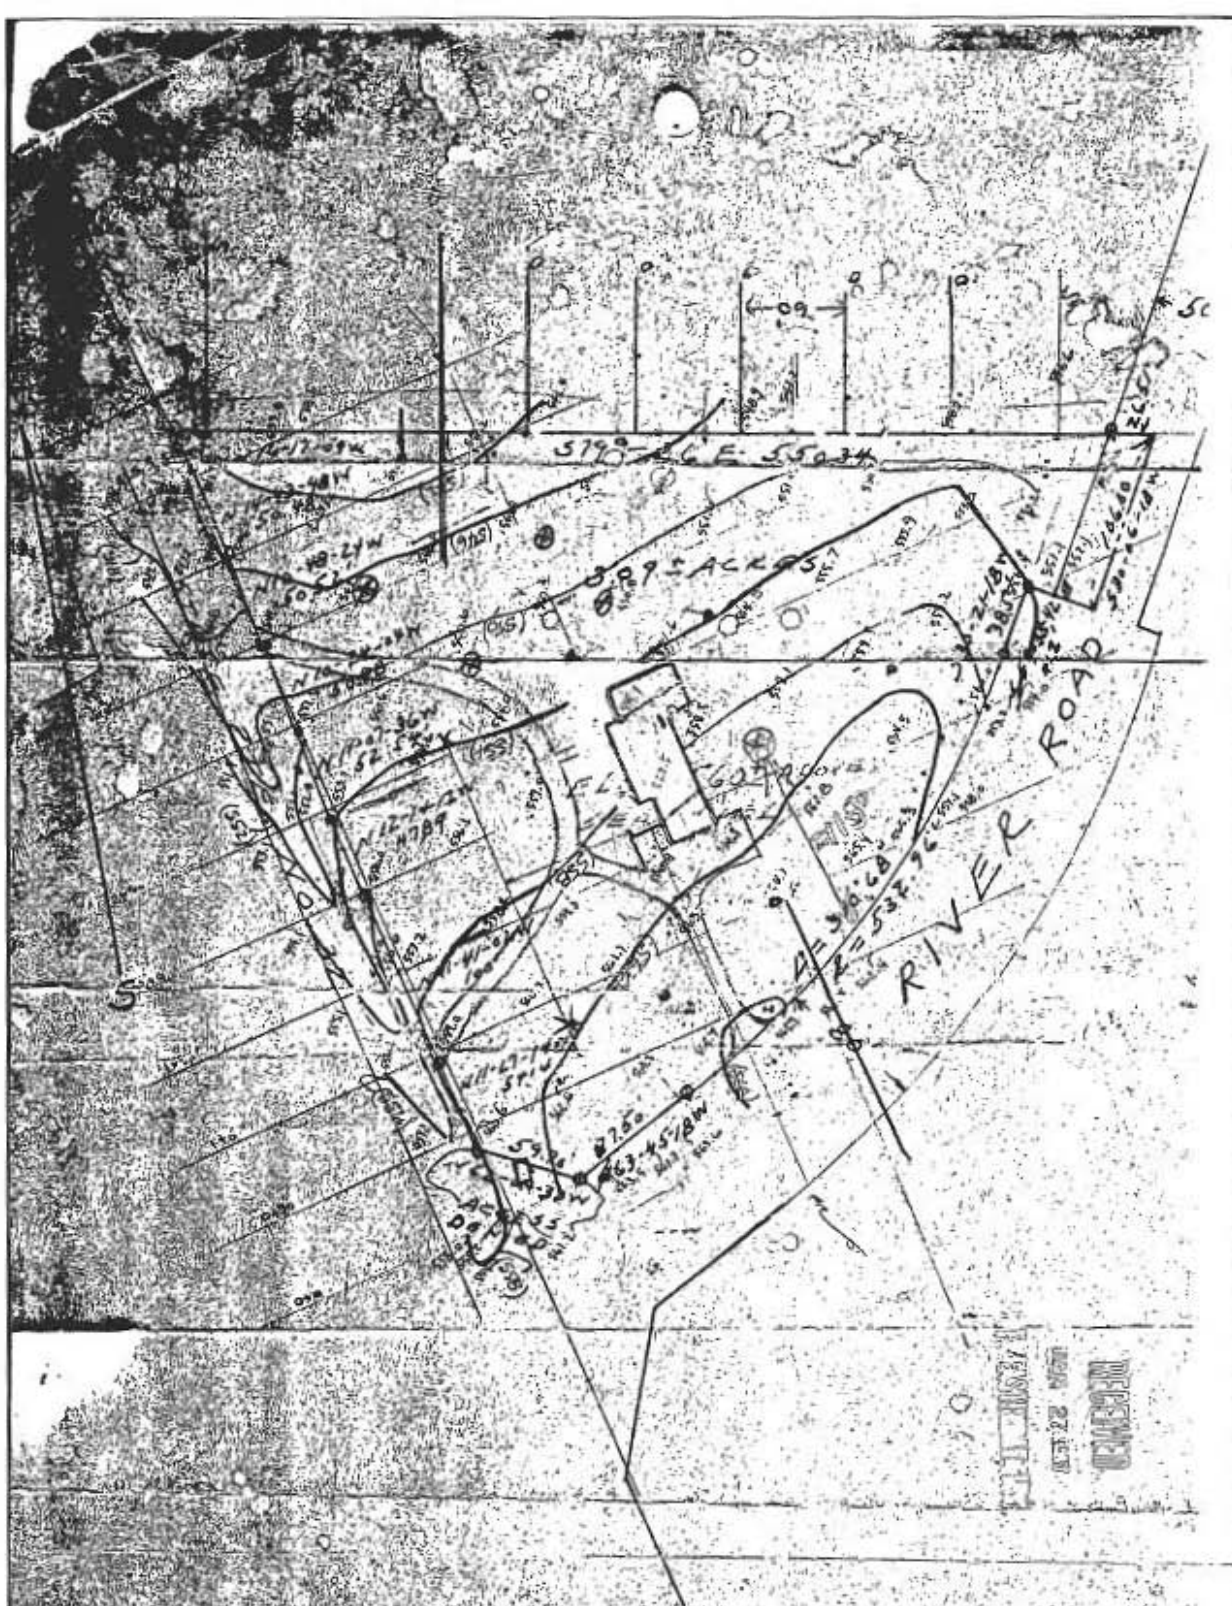



Plat of a lot for John M. Harris,
Third District, Howard Co., Maryland

Scale 1 in. to 100 ft.
Robert C. Morris, ss. Surveyor
Old Court Road, A to H 1,



VICINITY MAP

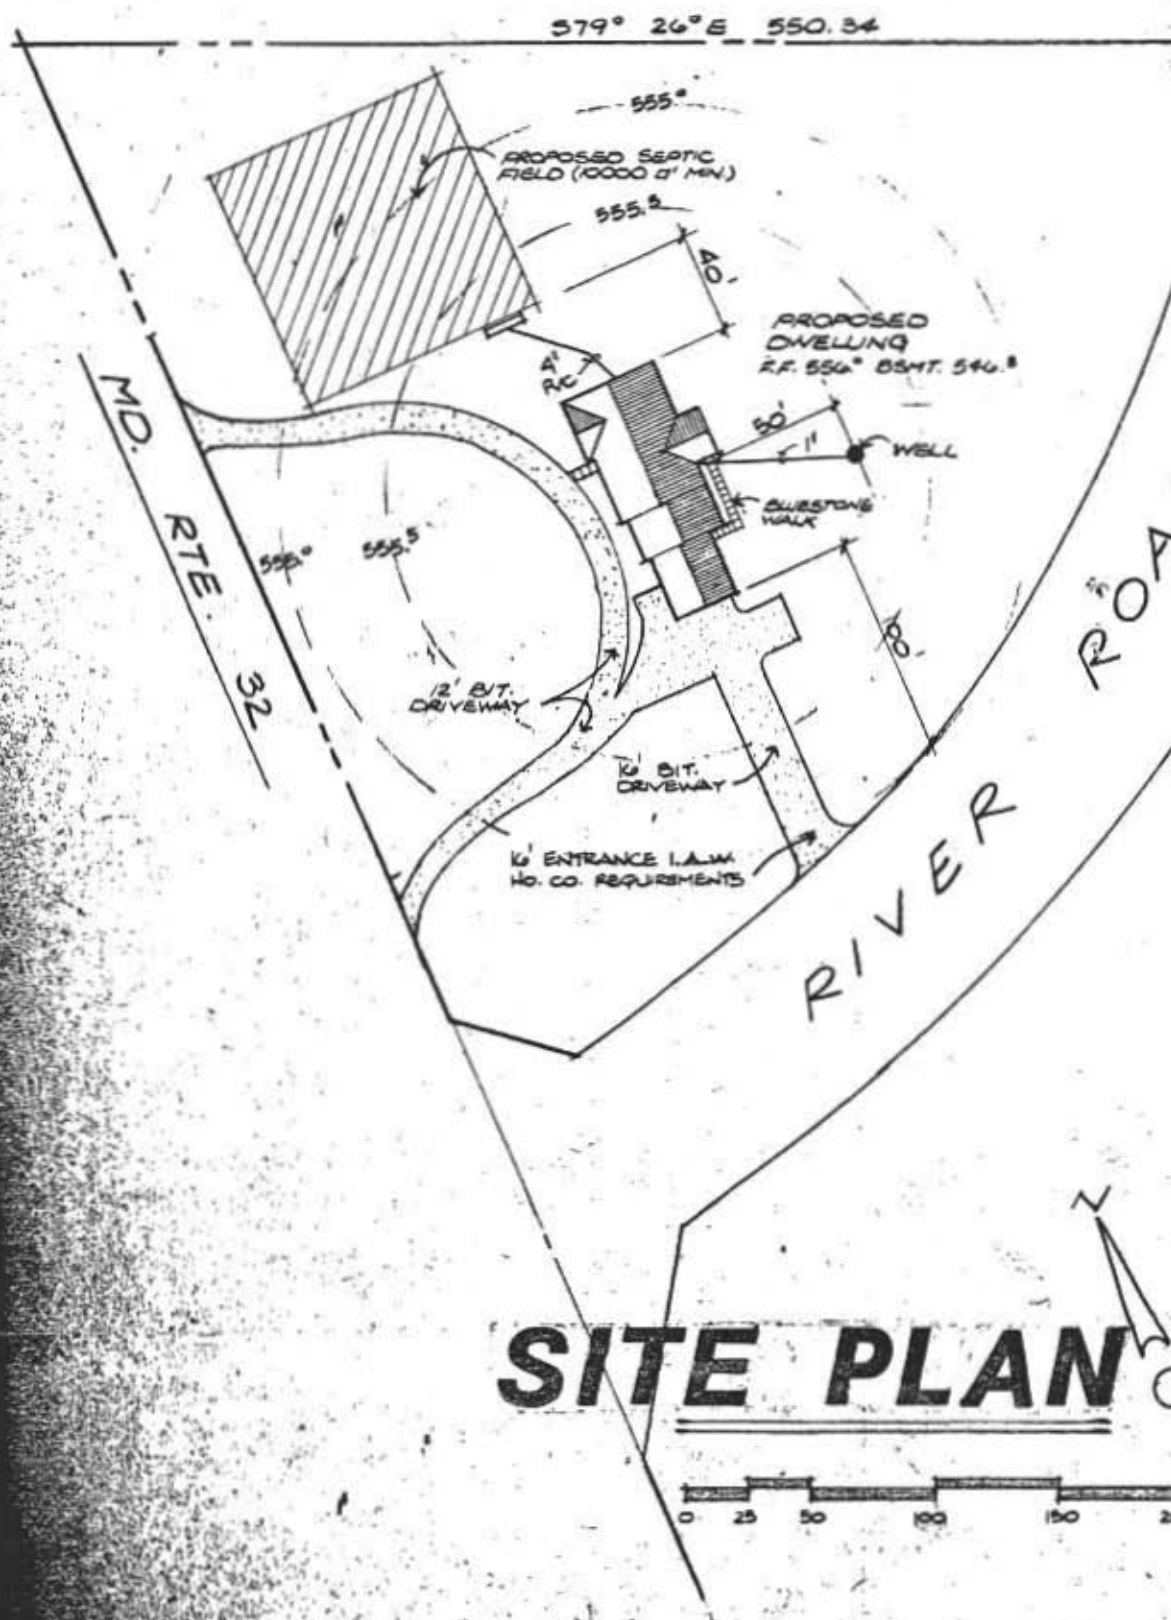

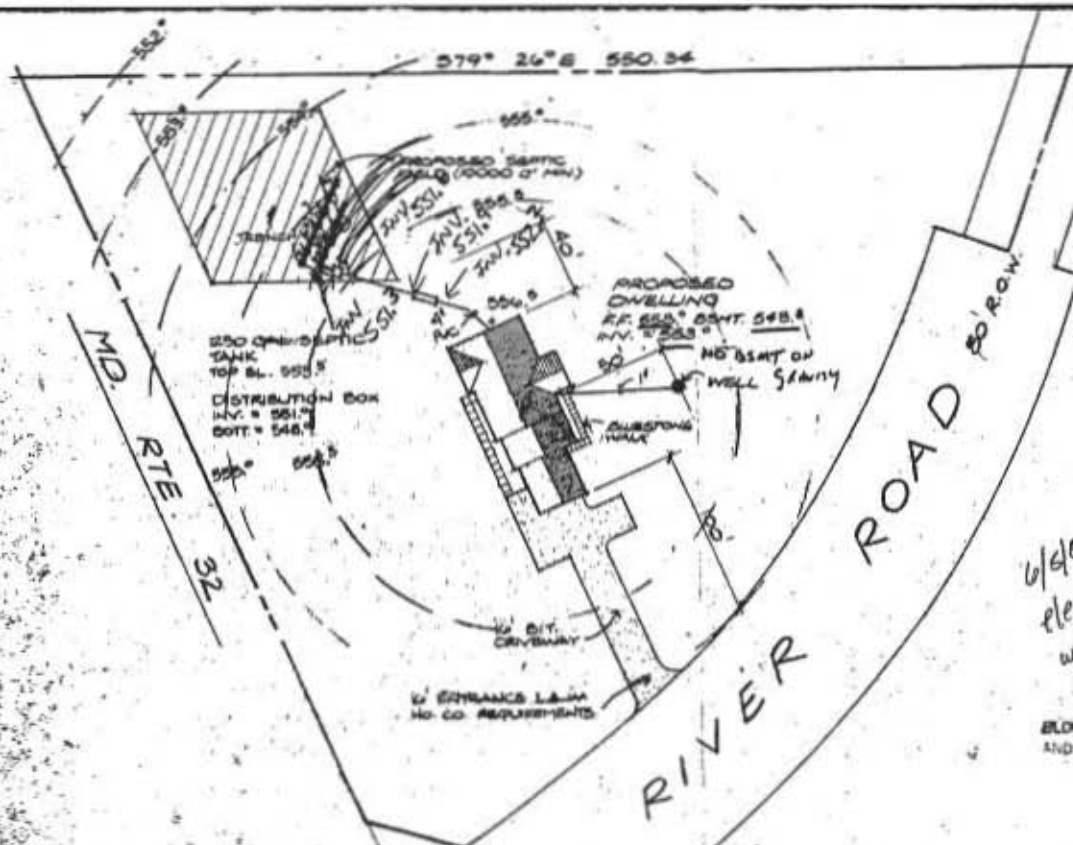

6/6/87
 elevations to complete
 with present info able
 to complete for owner
 or other

BLOG. PERMIT SIGNED
 AND RETURNED 6/6/87
 BP 12323
 [Signature]

⊗ So where well is to be
↑ dug.

⊗ So where 4 percolation
test were dug & passed
& recorded in the record
of offices

Location:

RECEIVED

FEB 3 1917

L.F. EASTERDAY, INC.

go north on route #32
& when you pass under the
bridge on route #32 it is
exactly 2.1 miles to left. Turn
right on River Rd & property is
↓ on left, right on route #32.
over

There is a large, ^{white} bird house
on property!

ENVIRONMENTAL
HEALTH
DIVISION

FEB 6 13 15 PM '87

RECEIVED
HOWARD COUNTY
HEALTH DEPT