

Repair Approved (GUK)
15 Aug. 78

8/14/78
9:30 a.m.

PERMIT

SEWAGE DISPOSAL SYSTEM

MARYLAND STATE DEPARTMENT OF HEALTH*

HOWARD COUNTY

ELLICOTT CITY

DISTRICT 3rd

DATE 8/8/78

03-287920

INDEXED

P 28652

A REPAIR

Robert Reinhardt

IS PERMITTED TO INSTALL ALTER X

ADDRESS _____ PHONE _____

SUBDIVISION _____ ROAD 1105 River Road LOT _____

PROPERTY OWNER Mrs. Hursey & Mrs. Eichelberger

ADDRESS 1105 River Road, Sykesville, Md.

SPECIFICATIONS 2 bedrooms

SEPTIC TANK CAPACITY 1000 GALLONS

DRAIN FIELD _____ DEPTH _____ FEET, BOTTOM AREA _____ SQ. FT.

DEEP TRENCH _____ DEPTH 10 FEET, BOTTOM AREA 300 SQ. FT.

SEEPAGE PITS _____ ABSORBENT SIDE-WALL AREA _____ SQ. FT.

INLET PIPE 2-4 FT. BELOW ORIGINAL GRADE. MAXIMUM DEPTH 10 FT. BELOW ORIGINAL GRADE

EFFECTIVE DEPTH AT 4 FT. BELOW ORIGINAL GRADE.

LOCATE DISPOSAL AREA _____ FT. FROM _____ LOT LINE AND _____ FT. FROM _____ LOT LINE AS SEEN WHEN
FACING LOT FROM _____

REPAIR-CALL FOR INSPECTION WHEN GROUND IS OPENED UP SO SANITARIAN CAN

RECOMMEND REPAIR. Good soil at 4'-10' to 0'6 to 4' clayey-silty loam to 10'

Trench to be 50 feet long, 10 feet deep, inlet at 2-4' and
contain 6 feet of stone. Run with contour toward left prop. line.

PLANS APPROVED BY Palmer F. Wine

DATE 8/8/78

COVER NO WORK UNTIL INSPECTED AND APPROVED.

NEITHER THE HOWARD COUNTY COUNCIL NOR THE HEALTH DEPARTMENT IS RESPONSIBLE FOR THE SUCCESSFUL OPERATION OF ANY SYSTEM.

NOTE: IF TRENCH IS USED CALL FOR INSPECTION BEFORE PLACING GRAVEL IN TRENCH.

NOTE: NO DRY WELL SHALL EXCEED 15 FOOT IN DIAMETER.

NOTE: ALL PIPE FROM HOUSE TO DISPOSAL AREA MUST BE CAST IRON.


PERMIT VOID AFTER THREE YEARS.

NOTE: INSTALL STAND PIPE ON SEPTIC TANK AND DRY WELL. STAND PIPES MUST BE 6 INCHES IN DIAMETER. CAST IRON, CONCRETE OR TERRA
COTTA ACCEPTED.

*INSTALLER IS RESPONSIBLE FOR OBTAINING FINAL APPROVAL ON THIS PERMIT.

P28652

42'
ST depth
liquid level
2.5'

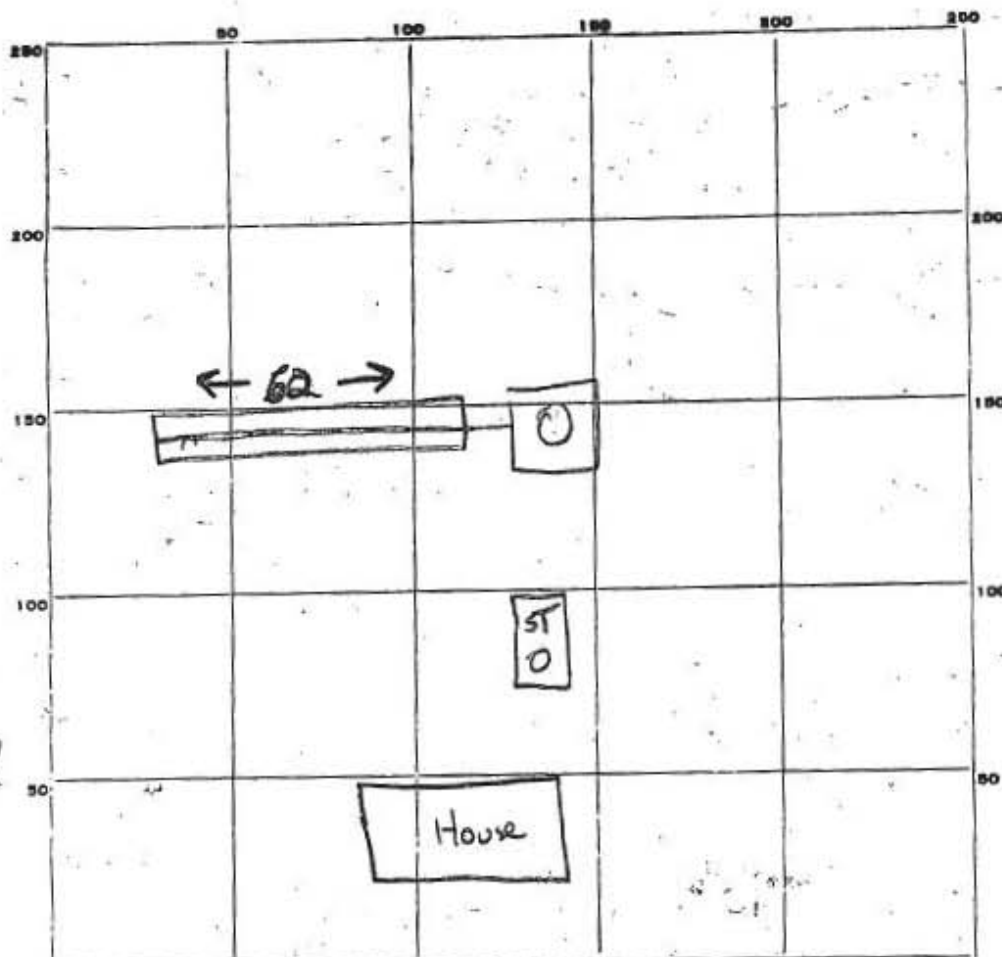

INDICATE NORTH - NAME ADJOINING ROADWAY AS BASE LINE.

River Rd

PERMIT CARD NW

SEPTIC TANK, LEVEL _____

CLEANOUTS _____

DISTRIBUTION BOX, LEVEL _____

TILE FIELD, DEPTH 10 FT. TRENCH WIDTH 2 FT.

GRAVEL DEPTH 8 FT. TOTAL LENGTH 62 FT.

NUMBER OF TRENCHES 1 TOTAL BOTTOM AREA 1256

SEEPAGE PITS, INSIDE DIAMETER _____ FT. DEPTH BELOW INLET _____ FT.

ABSORBENT AREA _____ SQ. FT.


REMARKS 14 Aug 78 - Specs. written. OK to add gravel to trench
if owners will certify depth of trench (GLK)
15 Aug 78 - Final OK - Cover all work (GLK)

DATE SYSTEM APPROVED 15 Aug. 78

INSPECTOR G. Keller

NOTES:

- 1) B.L.R. information, if shown, was obtained from existing record plat or local agencies and is not guaranteed by NTT, Inc.
- 2) Building line and/or Flood Zone information is subject to the interpretation of the originator.
- 3) NTT, Inc. does not certify to unknown or unrecorded encroachments or overlaps.
- 4) Property markers NOT found, or guaranteed by this location.
- 5) Setback distance accuracy: 1/8"

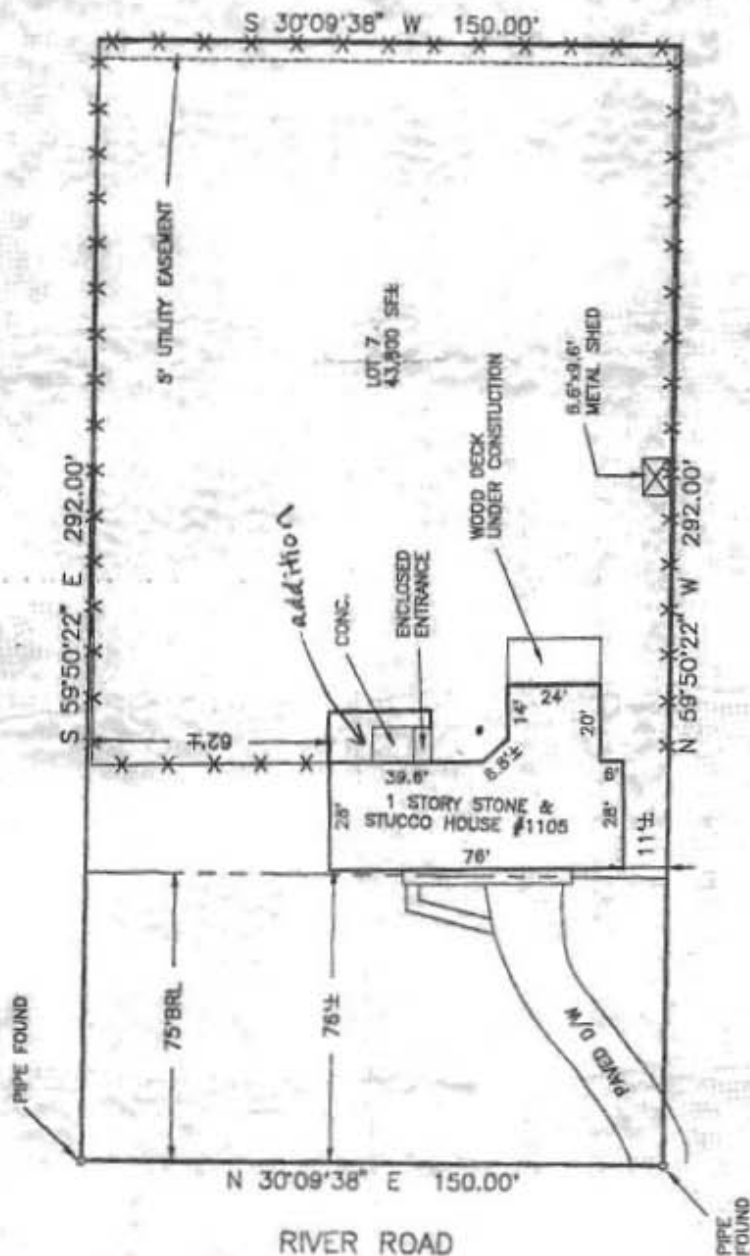

Lot 6

Subject property is shown in Zone C on the FIRM Map of Howard County, Maryland on Community Panel 240044 0009B Effective December 4, 1986

This is to certify that I have surveyed the property shown hereon, being known as LOT 7 AS SHOWN ON PLAT OF SECTION 2, RIVER PARK ESTATES and recorded among the land records of Howard County, Maryland in Plat 08, folio 51 for the purpose of locating the improvements thereon.

- * This plat is of benefit to the consumer only insofar as it is required by a lender or a title insurance company or its agent in connection with contemplated transfer, financing, or refinancing purposes.
- * This plat is not to be relied upon for the establishment of location of fences, garages, buildings, or other existing or future structures.
- * This plat does not provide for the accurate identification of property boundary lines, but such identification may not be required for the transfer of title or for securing financing or refinancing.

LOCATION DRAWING
1105 RIVER ROAD
HOWARD COUNTY, MARYLAND
3RD ELECTION DISTRICT

NTT Associates, Inc.
16205 Old Frederick Road
Mt. Airy, Maryland 21771
Ph. (410)442-2031
Fax No. (410)442-1315

Scale: 1" = 50'
Date: 08-17-03
Field By: J.D.C.
Drawn By: J.D.C.
Drawing # AEC07764-03



J. Carl Hudgins
Property Line Surveyor #96

CONLEY RESIDENCE, 1105 RIVER ROAD, SYKESVILLE MD 21784, LOT 7, SECTION 2, RIVER PARK ESTATES, PLOT BOOK 8

