




06.04.2013 14:33

SITE INSPECTION SHEET

OWNER: William Conley PHONE #: _____
ADDRESS: 1105 River Rd. CONTRACTOR: Oliver Hand
Sykesville WELL TAG #: no tag, pit well
SUBDIVISION: _____ LOT: _____ COUNTY #: _____
PROPOSAL: addition

LOCATION DIAGRAM

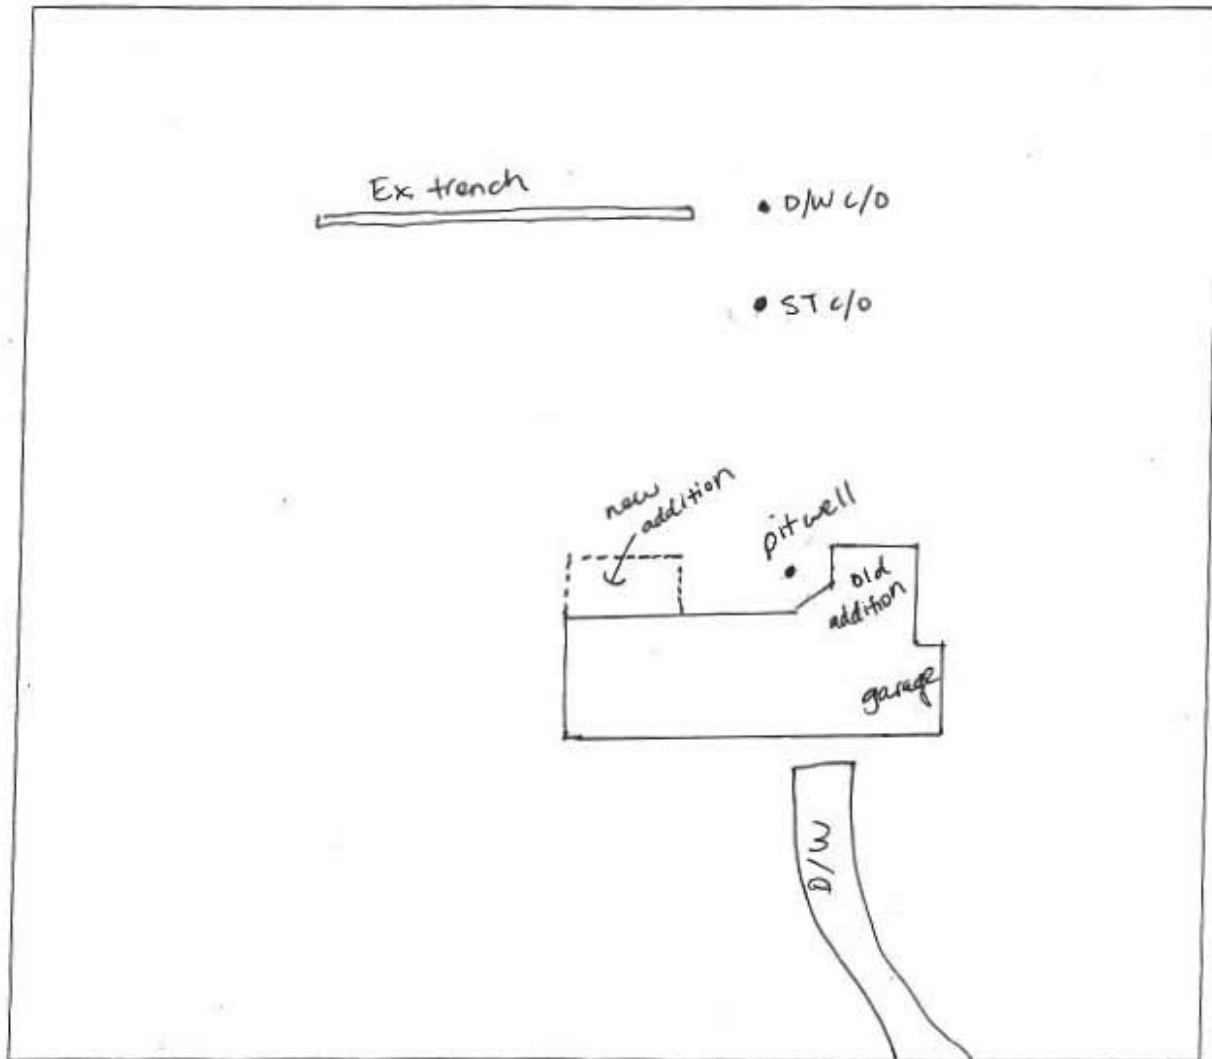

COMMENTS: Removed cleanouts from S.T. & D.W. Effluent levels OK.
Inlet depth on drywell approx 2'-2.5'. Area of trench off
of D.W. is satisfactory.

- Pit well needs to be upgraded.

Walk-thru of house confirms 2 BR upstairs

DATE: 5/23/13 INSPECTOR: NB