

APPLICATION

SEWAGE-DISPOSAL TESTING

A 03198

P 03402

MARYLAND STATE DEPARTMENT OF HEALTH

HOWARD COUNTY 750 Gallon Tank

ELLICOTT CITY

DISTRICT 3

DATE 11/25/60

Dry Well 300sq ft sidewalk area below the inlet

Place the dry well about 45 ft to 70 ft from the edge of River Rd and about 50 ft to 75 ft from

TO: THE COUNTY HEALTH OFFICER
ELLICOTT CITY, MARYLAND

the side of the lot furthest from Lot # 4

I, HEREBY, APPLY FOR THE NECESSARY TESTS IN ORDER TO CONSTRUCT OR RECONSTRUCT A SEWAGE DISPOSAL SYSTEM.

PROPERTY OWNER Norris, Wallace

ADDRESS Rt. 3, Mt. Airy PHONE Mt. Airy 574

PROPERTY LOCATION:

SUBDIVISION River Park Estates LOT NO. ~~5~~ 5

ROAD AND DESCRIPTION River Rd.

OCCUPANT _____ PHONE _____

PERSON TO CONSTRUCT SYSTEM _____

ADDRESS _____ PHONE _____

SIZE OF LOT 1 ACRES TYPE BLOC. 3 NUMBER OF SECTIONS

IF NOT SINGLE RESIDENCE DESCRIBE _____

SIGNATURE OF APPLICANT Wallace E. Norris


APPROVED BY Raymond Hedge FOR Dry Well DATE 11/18/60

REJECTED BY _____ FOR _____ DATE _____

HOLD PENDING FURTHER TESTS _____ DATE _____

REASONS FOR REJECTION OR HOLDING _____

THIS IS NOT A PERMIT

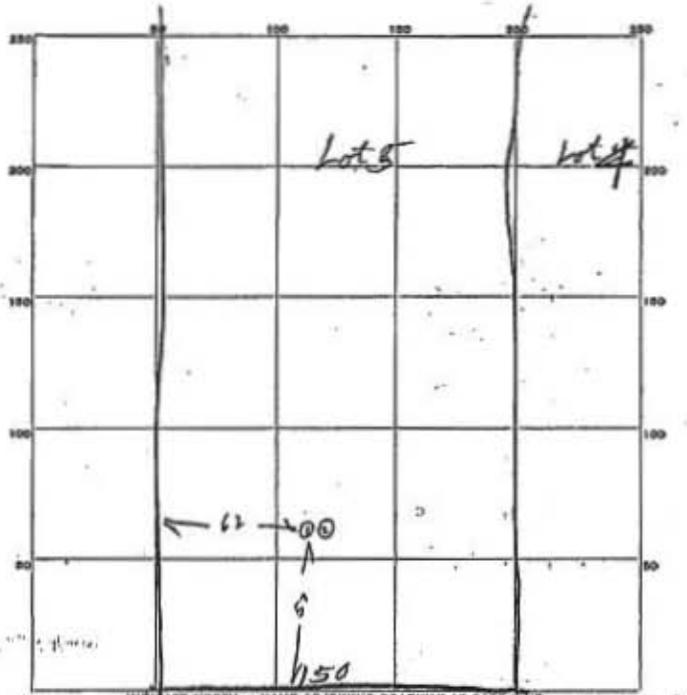

| DATE | TEST NO. | DEPTH | PRE-WET | | TEST - 1" DROP | | TIME |
|----------|----------|-------|---------|------|----------------|------|--------|
| | | | START | STOP | START | STOP | |
| 11/18/60 | 1 | 7 | 1038 | 1039 | 1039 | 1042 | 3 |
| " | 2 | 4 | 1039 | → | → | 1057 | 10 min |
| | | | | | | | |
| | | | | | | | |
SOIL AUGER FINDING _____

TESTED BY Raymond Hodges

REMARKS _____

ALSO PRESENT Wallace & Harris LOT NO. 5