


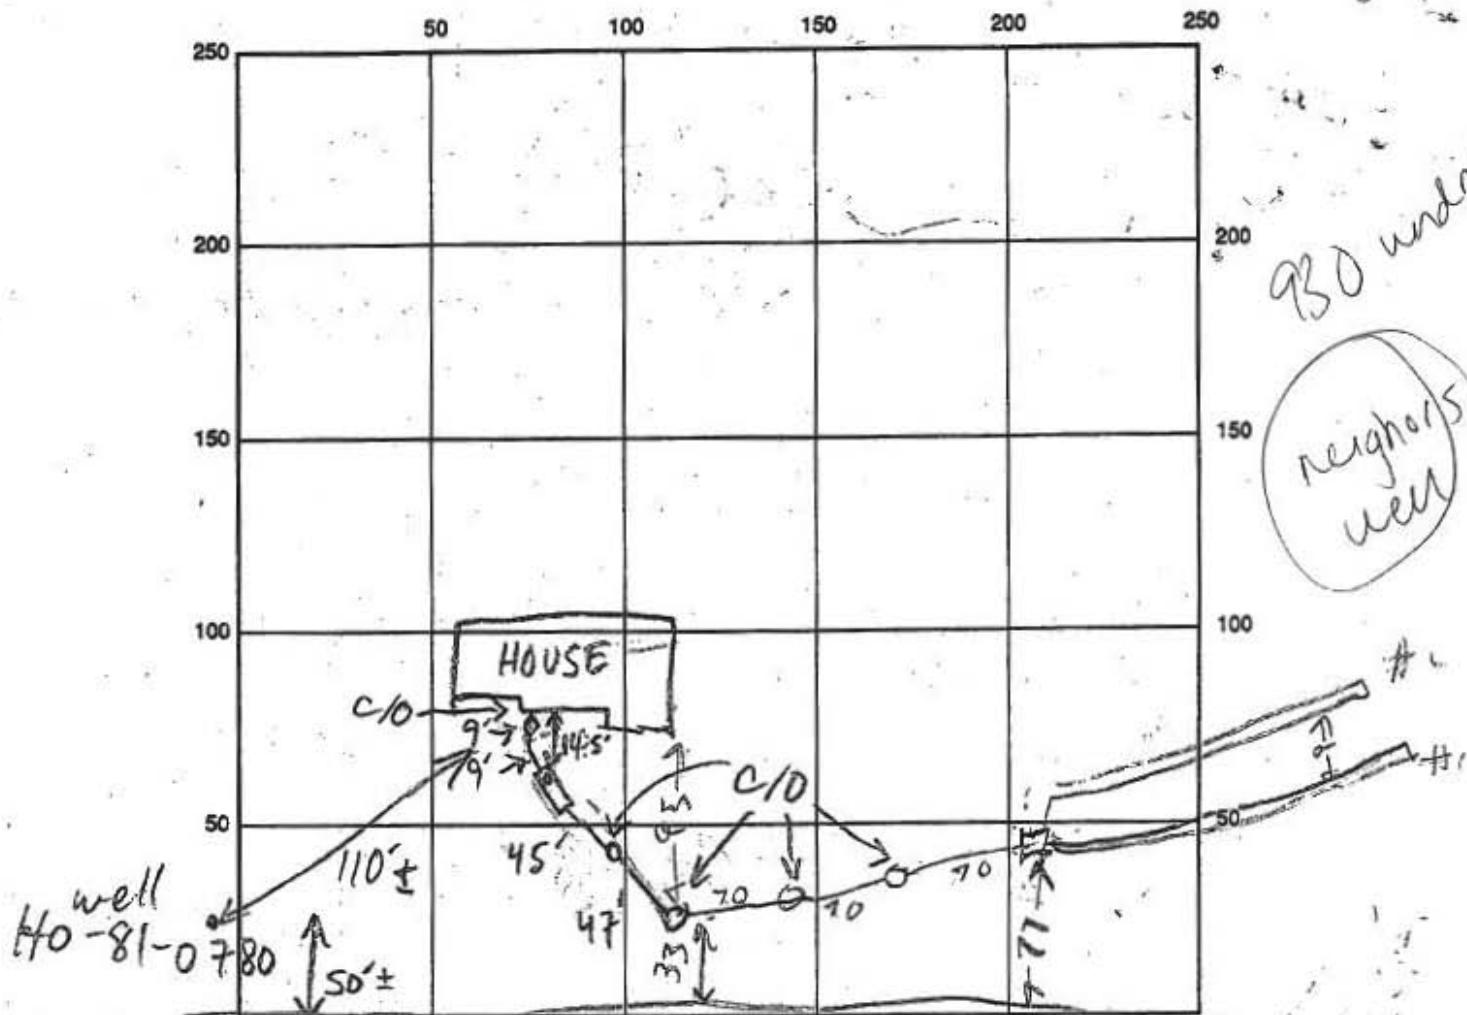

WINDRIVER DR INDICATE NORTH - NAME ADJOINING ROADWAY AS BASE LINE

SEPTIC TANK LEVEL 1000 GAL - OK

CLEANOUTS S.T. SEWER LINE OK OK OK OK OK (#)

DISTRIBUTION BOX LEVEL OK

DRAIN FIELD/TITLE DEPTH 1 1/2 FT.

TRENCH WIDTH 2 1/2 FT.

INLET DEPTH 3.5 FT.

EFFECTIVE GRAVEL DEPTH 4 1/2 FT.

TOTAL LENGTH 102 1/2 FT.

NUMBER OF TRENCHES 2

ONE SIDEWALL/BOTTOM AREA 408 SQ. FT. 725 TOTAL

DRYWALL INSIDE DIAMETER — FT.

EFFECTIVE DEPTH BELOW INLET — FT.

ABSORBENT AREA 725 SQ. FT.

REMARKS: 2/12/91 - SITE INSPECTION OK PER PLANS RH 2/15/91 OK

TO COVER DISTRIBUTION BOX & HOUSE SEWER

4/15/91 - TRENCH - TRENCH: OK ADD STONE RH

4/15/91 330 PM - TRENCH OK EXTRA STONE ADDED TO CONNECT

TANK RH 6/5/91 OK TO COVER ALL WORK MR

DATE SYSTEM APPROVED 6/5/91

INSPECTOR M RIFKIN (CW)