

DEPT. OF INSPECTIONS, LICENSES AND PERMITS 3400 COURT HOUSE DRIVE ELLICOTT CITY, MD 21043 PERMITS (410) 313-2433 INSPECTIONS (410) 313-1818 AUTOMATED INFORMATION (410) 313-3800		HOWARD COUNTY PERMIT APPLICATION		PERMIT NUMBER	
Building Address <u>1121 RIVER RD</u> <u>Sykesville MD 21784</u>			Property Owner's Name <u>Philip Coombes</u> Address <u>1121 RIVER RD</u> City <u>Sykesville</u> State <u>MD</u> Zip Code <u>21784</u> Home Phone <u>410-442-3616</u> Work Phone <u>410-442-3632</u> Applicant's Name & Mailing Address, (if other than stated herein): _____ _____ _____		
Suite/Apt. #: _____ SDP/WP/Petition #: _____ Census Tract _____ Subdivision _____ Section _____ Area _____ Lot _____ Tax Map _____ Parcel _____ Grid _____ Zoning _____ Map Coordinates _____ Lot Size _____			Phone _____ Fax _____ Contractor Company _____ Contact Person _____ Address _____ City _____ State _____ Zip Code _____ License No. _____ Phone _____ Fax _____ Engineer or Architect Company _____ Contact Person _____ Address _____ City _____ State _____ Zip Code _____ Phone _____ Fax _____		
Existing Use <u>SFD</u> Proposed Use <u>SFD - Grand Porch</u> Estimated Construction Cost \$ _____ Description of Work <u>Turnball road</u> <u>over existing state</u>					
Occupant or Tenant <u>Philip Coombes</u> Contact Name <u>Philip Coombes</u> Address <u>1121 River Rd</u> City <u>Sykesville</u> State <u>MD</u> Zip Code <u>21784</u> Phone <u>410-442-3616</u> Fax _____					

BUILDING DESCRIPTION - COMMERCIAL		BUILDING DESCRIPTION - RESIDENTIAL	
Building Characteristics Height: _____ No. of stories: _____ Gross area, sq. ft. per floor: _____ Use group: _____ Construction type: ☐ Reinforced Concrete ☐ Structural Steel ☐ Masonry ☐ Wood Frame ☐ State Certified Modular	Utilities Water Supply: ☐ Public ☐ Private Sewage Disposal: ☐ Public ☐ Private Electric: Yes ☐ No ☐ Gas: Yes ☐ No ☐ Heating System: Electric ☐ Oil ☐ Natural Gas ☐ Propane Gas ☐ Sprinkler system: N/A ☐ ☐ Full ☐ Partial ☐ Other Suppression ☐ # of Heads	Building Characteristics SF Dwelling ☐ SF Townhouse ☐ Depth _____ Width _____ 1 st floor: _____ 2 nd floor: _____ Basement: _____ Finished Basement ☐ Unfinished Basement ☐ Crawl space ☐ Slab on Grade ☐ No. of Bedrooms: <u>3</u> Multi-family dwellings: No. of efficiency units: _____ No. of 1 BR units: _____ No. of 2 BR units: _____ No. of 3 BR units: _____ Other Structure: _____ Dimensions: _____ Footings: _____ Roof: _____ ☐ State Certified Modular ☐ Manufactured Home	Utilities Water Supply: ☐ Public ☐ Private Sewage Disposal: ☐ Public ☐ Private Electric: Yes ☐ No ☐ Gas: Yes ☐ No ☐ Heating System: Electric ☐ Oil ☐ Natural Gas ☐ Propane Gas ☐ Sprinkler system: N/A ☐ ☐ NFPA #13D ☐ NFPA #13R ☐ Other

THE UNDERSIGNED HEREBY CERTIFIES AND AGREES AS FOLLOWS: (1) THAT HE/SHE IS AUTHORIZED TO MAKE THIS APPLICATION; (2) THAT THE INFORMATION IS CORRECT; (3) THAT HE/SHE WILL COMPLY WITH ALL REGULATIONS OF HOWARD COUNTY WHICH ARE APPLICABLE THERE TO; (4) THAT HE/SHE WILL PERFORM NO WORK ON THE ABOVE REFERENCED PROPERTY NOT SPECIFICALLY DESCRIBED IN THIS APPLICATION; (5) THAT HE/SHE GRANTS COUNTY OFFICIALS THE RIGHT TO ENTER ON TO THIS PROPERTY FOR THE PURPOSE OF INSPECTING THE WORK PERMITTED AND POSTING NOTICES.

Applicant's Signature Philip Coombes Print Name Philip Coombes
 Email Address Phillip@valcoo.com
 Date 1/8/13


Title/Company _____ Date _____

Checks payable to: DIRECTOR OF FINANCE OF HOWARD COUNTY
 PLEASE WRITE NEATLY AND LEGIBLY

AGENCY	DATE	SIGNATURE APPROVAL	DPZ SETBACK INFORMATION	PROPERTY ID #
Land Development DPZ			Front: _____	Filing fee \$ _____
State Highway			Rear: _____	Permit fee \$ _____
Building Officials			Side: _____	Excise tax \$ _____
Dev. Engineering DPZ			Side St: _____	Add'l per fee \$ _____
Health <u>1/8/2013</u> <u>Phineas</u>			All minimum setbacks met?	TOTAL FEES \$ _____
Fire Protection			YES ☐ NO ☐	Sub-total paid \$ _____
Is Sediment Control approval required prior to issuance?			YES ☐ NO ☐	Balance due \$ _____
			Is Entrance Permit Required?	Check # _____
			Historic District?	Validation # _____
			YES ☐ NO ☐	
			Lot Coverage for New Town Zone	
			SDP/Red-line approval date _____	Amounted by _____

CONTINGENCY CONSTRUCTION START ☐
 ONE STOP SHOP: ☐

Distribution of Copies White: Building Officials Green: LDD, DPZ Yellow: DED, DPZ Pink: Health To: SHA

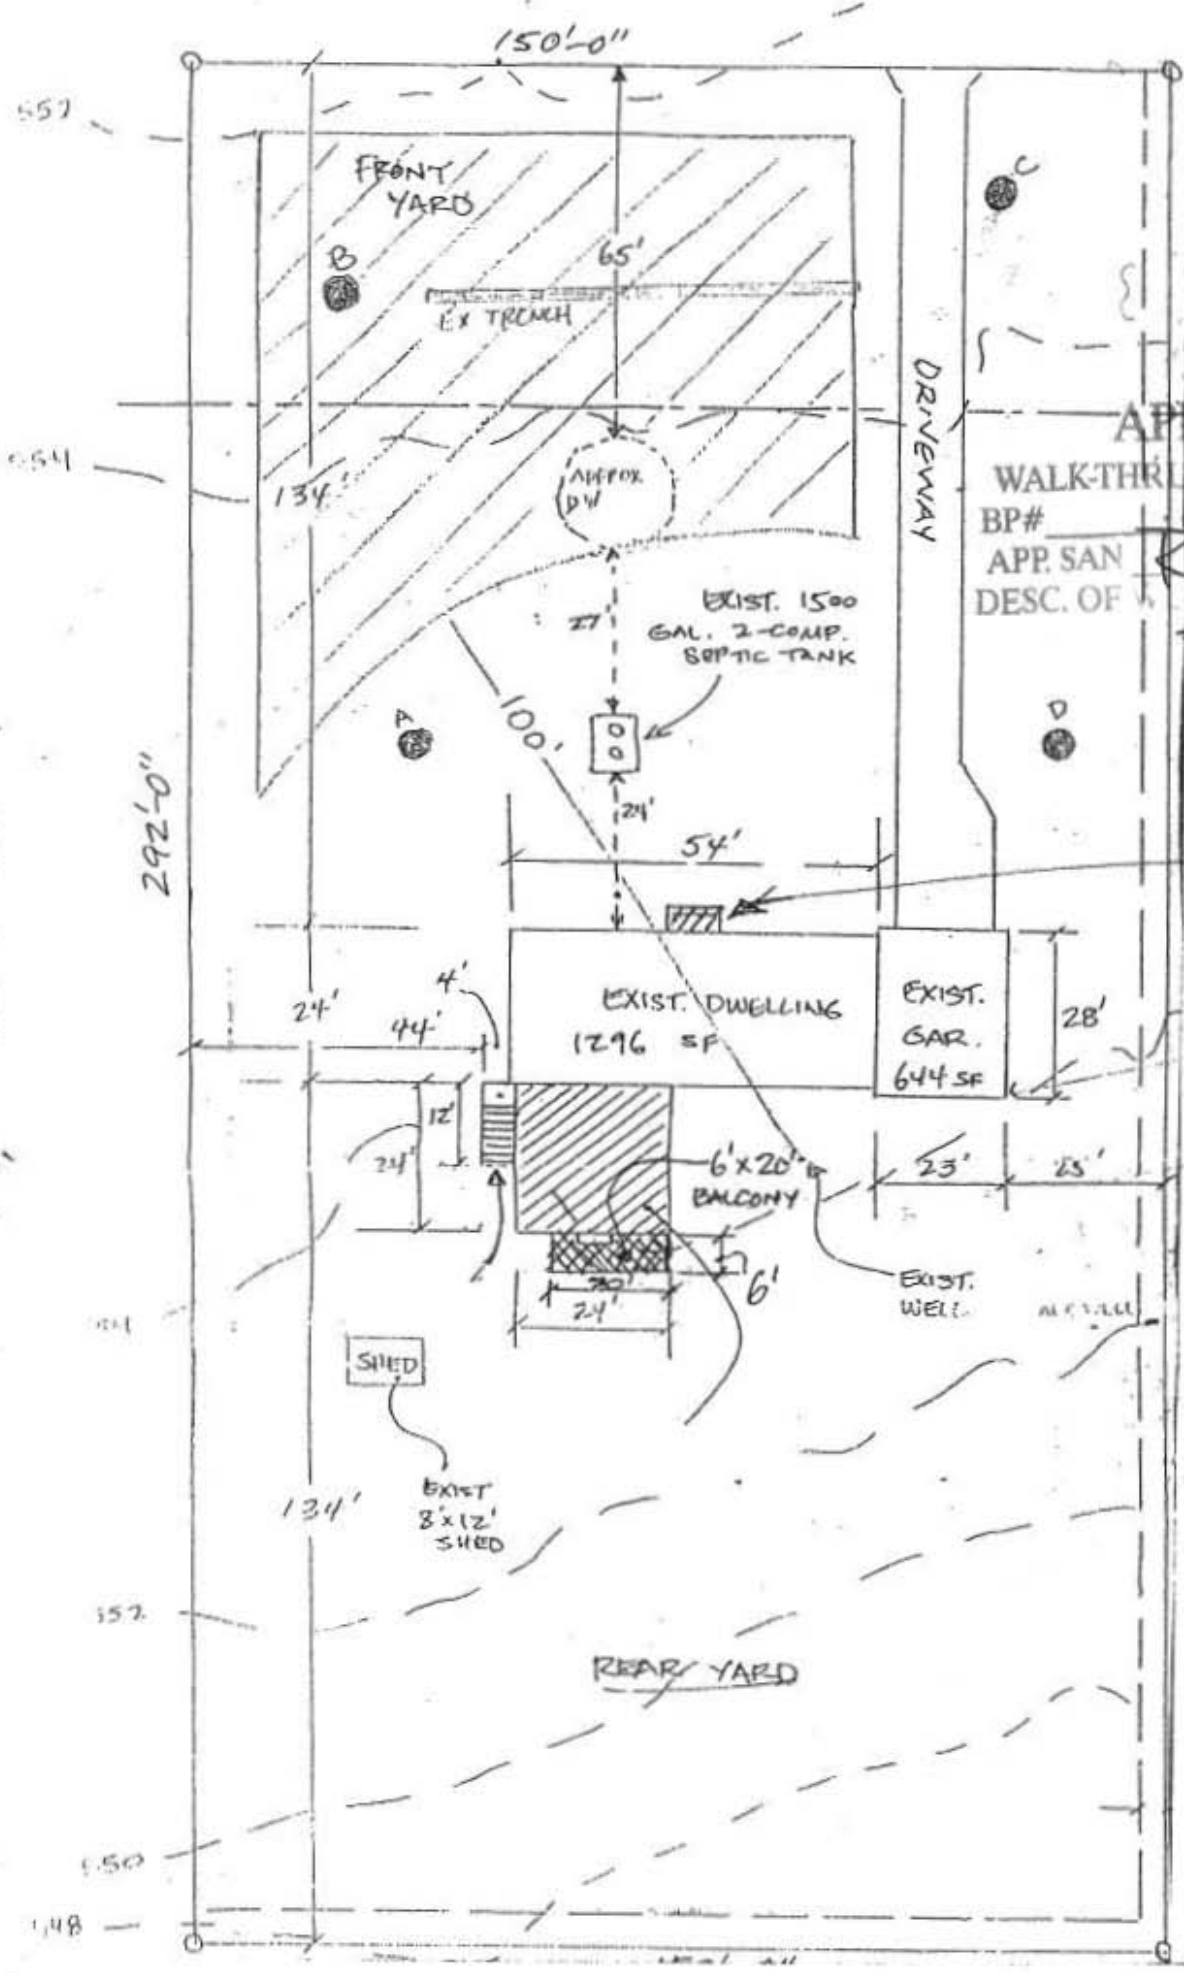

APPROVED
WALK-THRU BUILDING PERMIT
BP# _____ A# _____
APP. SAN _____
DESC. OF _____

DATE: 1/8/13
Roof over existing slab (5'x8')

Proposed new front porch

5' x 8'

DEPT. OF INSPECTIONS, LICENSES AND PERMITS 3430 COURT HOUSE DRIVE ELLICOTT CITY, MD. 21043 PERMITS (410) 313-2455 INSPECTIONS (410) 313-1810 AUTOMATED INFORMATION (410) 313-3800		HOWARD COUNTY PERMIT APPLICATION	PERMIT NUMBER P4000122
Building Address <u>1121 RIVER RD.</u> <u>SYKESVILLE, MD. 21784-5514</u>		Property Owner's Name <u>MR. & MRS. COOMBER</u> Address <u>1121 RIVER RD.</u> City <u>SYKESVILLE</u> State <u>MD.</u> Zip Code <u>21784</u> Home Phone _____ Work Phone <u>410-592-6302</u> Applicant's Name & Mailing Address, (if other than stated herein): <u>JEFF BYERLY</u> <u>307 LANIBETH RD.</u> <u>CATONSVILLE, MD. 21728</u>	
Suite/Apt. #: _____ SDP/WP/Petition #: _____		Phone <u>410-952-1347</u> Fax _____	
Census Tract _____ Subdivision <u>RIVER PARK</u> <u>ESTATES</u>		Contractor Company <u>CAPE HORN ARTISANS</u> Contact Person <u>DAVID KIRBY</u> Address <u>CAPE HORN RD.</u> City <u>ELLSMINSTER</u> State <u>MD.</u> Zip Code _____ License No. <u>MHC # 46710</u> Phone <u>410-546-1215</u> Fax _____	
Section _____ Area <u>1</u> Lot <u>551</u>		Engineer or Architect Company <u>RONALD JOHNSTON</u> <u>ASSOC.</u> Contact Person <u>RONALD JOHNSTON</u> Address <u>11407 EARLY FIELDS WAY</u> City <u>MARRIOTTSV.</u> State <u>MD.</u> Zip Code <u>21104</u> Phone <u>410-442-3667</u> Fax _____	
Tax Map <u>9</u> Parcel <u>47</u> Grid <u>11</u>		Address <u>11407 EARLY FIELDS WAY</u> City <u>MARRIOTTSV.</u> State <u>MD.</u> Zip Code <u>21104</u> Phone <u>410-442-3667</u> Fax _____	
Zoning _____ Map Coordinates _____ Lot Size <u>1.00 AC</u>		City <u>MARRIOTTSV.</u> State <u>MD.</u> Zip Code <u>21104</u> Phone <u>410-442-3667</u> Fax _____	
Existing Use <u>RESIDENTIAL</u> Proposed Use <u>RESIDENTIAL</u> Estimated Construction Cost \$ <u>30,000.</u> Description of Work <u>ATTACHED 2-STY.</u> <u>ADDITION, NEW FRONT PORCH</u> <u>(152 S/F) (30 S/F)</u>		Engineer or Architect Company <u>RONALD JOHNSTON</u> <u>ASSOC.</u> Contact Person <u>RONALD JOHNSTON</u> Address <u>11407 EARLY FIELDS WAY</u> City <u>MARRIOTTSV.</u> State <u>MD.</u> Zip Code <u>21104</u> Phone <u>410-442-3667</u> Fax _____	
Occupant or Tenant <u>OWNERS</u>		City <u>MARRIOTTSV.</u> State <u>MD.</u> Zip Code <u>21104</u> Phone <u>410-442-3667</u> Fax _____	
Contact Name <u>PHIL COOMBER</u>		City <u>MARRIOTTSV.</u> State <u>MD.</u> Zip Code <u>21104</u> Phone <u>410-442-3667</u> Fax _____	
Address <u>1121 RIVER RD.</u>		City <u>MARRIOTTSV.</u> State <u>MD.</u> Zip Code <u>21104</u> Phone <u>410-442-3667</u> Fax _____	
City <u>SYKESVILLE</u> State <u>MD.</u> Zip Code <u>21784</u>		City <u>MARRIOTTSV.</u> State <u>MD.</u> Zip Code <u>21104</u> Phone <u>410-442-3667</u> Fax _____	
Phone <u>410-592-6302</u> Fax _____		City <u>MARRIOTTSV.</u> State <u>MD.</u> Zip Code <u>21104</u> Phone <u>410-442-3667</u> Fax _____	

BUILDING DESCRIPTION - COMMERCIAL		BUILDING DESCRIPTION - RESIDENTIAL	
Building Characteristics Height: _____ No. of stories: _____ Gross area, sq. ft. per floor: _____ Use group: _____ Construction type: _____ Reinforced Concrete _____ Structural Steel _____ Masonry _____ Wood Frame _____ State Certified Modular _____	Utilities Water Supply: _____ Public _____ Private _____ Sewage Disposal: _____ Public _____ Private _____ Electric Yes ☐ No ☐ Gas Yes ☐ No ☐ Heating System: _____ Electric ☐ Oil ☐ Natural Gas ☐ Propane Gas ☐ Sprinkler system: N/A ☐ Full _____ Partial _____ Other Suppression _____ # of Heads _____	Building Characteristics SF Dwelling ☒ SF Townhouse ☐ Depth _____ Width _____ 1 st floor: <u>24' x 54'</u> 2 nd floor: _____ Basement: <u>24' x 54'</u> Finished Basement ☒ Unfinished Basement ☐ Crawl space ☐ Slab on Grade ☐ No. of Bedrooms <u>3</u> Multi-family dwellings: No. of efficiency units: _____ No. of 1 BR units: _____ No. of 2 BR units: _____ No. of 3 BR units: _____ Other Structure: <u>GARAGE</u> Dimensions: _____ Footings: <u>YES</u> Roof: <u>YES SHINGLED</u> State Certified Modular _____ Manufactured Home _____	Utilities Water Supply: _____ Public _____ Private ☒ Sewage Disposal: _____ Public _____ Private ☒ Electric Yes ☐ No ☐ Gas Yes ☐ No ☒ Heating System: _____ Electric ☐ Oil ☒ Natural Gas ☐ Propane Gas ☐ Sprinkler system: N/A ☒ NFA #13D _____ NFA #13R _____ Other: _____

THE UNDERSIGNED HEREBY CERTIFIES AND AGREES AS FOLLOWS: (1) THAT HE/SHE IS AUTHORIZED TO MAKE THIS APPLICATION; (2) THAT THE INFORMATION IS CORRECT; (3) THAT HE/SHE WILL COMPLY WITH ALL REGULATIONS OF HOWARD COUNTY WHICH ARE APPLICABLE THERETO; (4) THAT HE/SHE WILL PERFORM NO WORK ON THE ABOVE REFERENCED PROPERTY NOT SPECIFICALLY DESCRIBED IN THIS APPLICATION; (5) THAT HE/SHE GRANTS COUNTY OFFICIALS THE RIGHT TO ENTER ONTO THIS PROPERTY FOR THE PURPOSE OF INSPECTING THE WORK PERMITTED AND POSTING NOTICES.

Applicant's Signature Jeff Byerly Print Name JEFF BYERLY

Email Address _____
Title/Company AGENT, CAPE HORN ARTISANS Date 13 MAY 2010

Checks payable to: DIRECTOR OF FINANCE OF HOWARD COUNTY

PLEASE WRITE NEATLY AND LEGIBLY.

- FOR OFFICE USE ONLY -

AGENCY	DATE	SIGNATURE APPROVAL	DPZ SETBACK INFORMATION	PROPERTY ID#
Land Development, DPZ			Front: _____	Filing fee \$ <u>25.00</u>
State Highways			Rear: _____	Permit fee \$ _____
Building Officials			Side: _____	Excise tax \$ _____
Dev. Engineering, DPZ			Side St.: _____	Add'l per fee \$ _____
Health			All minimum setbacks met?	TOTAL FEES \$ _____
Fire Protection			YES ☐ NO ☐	Sub-total paid \$ _____
Is Sediment Control approval required prior to issuance?			Is Entrance Permit Required?	Balance due \$ <u>Cost</u>
YES ☐ NO ☐			YES ☐ NO ☐	Check # _____
			Historic District?	Validation # _____
			YES ☐ NO ☐	
			Lot Coverage for New Town Zone	
			SDP/Red-line approval date	Accepted by _____

CONTINGENCY CONSTRUCTION START: ☐
ONE STOP SHOP: ☐

Distribution of Copies - White: Building Officials Green: LDD, DPZ Yellow: DED, DPZ Pink: Health Gold: SHA
T:Operations/Updated forms

305 817



Bureau of Environmental Health
7178 Columbia Gateway Drive, Columbia, MD 21046-2147
(410) 313-2640 Fax (410) 313-2648
TDD (410) 313-2323 Toll Free 1-866-313-6300
website: www.hchealth.org

Peter L. Beilenson, M.D., M.P.H., Health Officer

May 24th, 2010

Phil Coomber
1121 River Rd.
Sykesville, MD 21784

Re: Building Permit Application B10001282

Dear Mr. Coomber

This office has recently received the above referenced building permit application for a 2 story addition. However, we are unable to recommend approval of your application at this time. The Annotated Code of Maryland [COMAR, 26.04.02.02.D(4)] and Howard County Code Section 3.8.05 requires the Approving Authority, i.e. the Health Department, to certify existing on-site sewage disposal and water supply systems prior to issuance of a construction permit for addition of living space greater than 250 sq. ft. Furthermore, Howard County Code [3.805(A)(2)(X)] requires that each lot created prior to March 1972 have a septic easement having "adequate area for an initial septic system and two 2 repairs".

The Howard County Health Department requires that you have an approved Percolation Certification Plan. The content of this plan [Howard County Code 3.805] and the supporting data serve as Health Department's justification for approving the current building permit application and any subsequent building permit applications. Percolation tests must be conducted in order to establish a septic easement. An Environmental Sanitarian records data of these evaluations.

Usually the data are compiled in a technical drawing by a Licensed Land Surveyor or Professional Engineer, and submitted to the Health Department for approval. The Health Department maintains lists of excavation contractors and engineers or surveyors who are known to offer their services in Howard County

You may contact me at the Bureau of Environmental Health, 410-313-1771 if you have questions about these contents.

Sincerely,

Heidi Scott, R.S.
Well & Septic Program

HS
Copy: _____ file _____