

Building Permit Application

Howard County Maryland

Department of Inspections, Licenses and Permits

3430 Court House Drive

Permits: 410-313-2455

www.howardcountymd.gov

DILP 2017 /W	TANKE STREET
Date Received:	A STATE OF SEVERY

Permit No.: 1317003653


					The state of the s
Building Address: 1377 ().			Property Owner's	Name: Chata Ca 7754 Dan a Ca	<u> </u>
City:	e: <u>^ </u>	1.75.6 \$	Address:	State: 14 15	Zip Code: //
Suite/Apt. #S			Phone:	Figure 6.1 of Fi	ax:
Suite/Apt. #	Subdivision Durat w	G 5.	Email:		
Census Tract:	SUDUNVISION		A	e & Mailing Address, (If o	than than stated harain
Section:A	rea:Lot:			e & Ivialling Address, (ii o	
Tax Map:Parce	l: Grid:		Address: Po	Description	
Tax Map: Parce Zoning: Map Coordi	nates:Lot Size	7,00(6)	City: Per 1 44	State:	Zip Code: 💯 🕡 🏋
			Phone: ~ MA	Fax:	1200001
Existing Use:			Email: _ / + · · · · ·	C C) APPLIX 'A	capene term
Proposed Use:			Contractor Comp	eany: LI T Trans	
Estimated Construction Cost: \$		114	Contact Person:	FILMET CHEEN	
			Address:	Para III	
Description of Work:			City: <u>{ 6.71 - }</u>	State:	Zip Code:
1 11 Lister	100 100 100 110	r officers	License No. :	(200) 12: 15:17	
Occupant/Tenant Name:			Email:		
Mas tenant space previously occupie		□No	Engineer/Archite	ct Company:	
"mark"		1			
Contact Name:]			
Address.	14.				
City:	State: Zip Code:		City:	State:	_ Zip Code:
Phone: _ = -	Fax:		Phone:	Fax:	
Email:			Email:		
- Tillani			Linea.		
Commercial Building Characteristic				<u>Utilitles</u>	可是使用是是"自要基本基础。"
Height:	SF Dwelling SF Tow	777		☐ Yes ☐ No	是是美国和哈德特的
No. of stories:	Depth 1 st floor:	<u>Width</u>	1.35533	□·Yes □ No	Property Charles and the first
Gross area, sq. ft./floor:	2 nd floor:		<u> 10</u>	<u>ater Supply</u>	
Area of construction (sq. ft.):	Basement:		☐ Public		《新聞歌歌歌》。《
	☐ Finished Basement		>☑ Private		连州县 农工会员的加州及鲁州
Use group:	☐ Unfinished Basement		Sev	vage Disposal	沙洲 最高级 的作 相外。
	☐ Crawl Space		☐ Public		
Construction type:	☐ Slab on Grade		·□ Private		
Reinforced Concrete	No. of Bedrooms:	***	He	ating System	Complete Com
☐ Structural Steel	Multi-family Dw	elling	☐ Electric	□ oil	
Masonry	No. of efficiency units:			☐ Propane Gas	
☐ Wood Frame	No. of 1 BR units:		11-920-13-4-3112-2-13-4-13-4	Li Fropatie Gas	CONTROLICATION AND A STATE OF
☐ State Certified Modular	No. of 2 BR units: No. of 3 BR units:		Other:		
2	Other Structure:			inkler System:	
	Dimensions:		☐ Yes	□´No	
> Roadside Tree Project Permit	Footings:				
□Yes □No	Roof:		Gı	rading Permit Number:	
Roadside Tree Project Permit #	☐ State Certified Modula	ar			
	☐ Manufactured Home		Buildi	ng Shell Permit Number:	
THE UNDERSIGNED HEREBY CERTIFIES AND AI WITH ALL REGULATIONS OF HOWARD COUNTINS APPLICATION; (5) THAT HE/SHE GRANTS (1) (1) (1) (2) (3) (4) (4) (4) (4) (4) (4) (4) (4) (4) (4	TY WHICH ARE APPLICABLE THERETO; COUNTY OFFICIALS THE RIGHT TO ENT	(4) THAT HE/SHE WILL ER ONTO THIS PROPER Prin	L PERFORM NO WORK	ON THE ABOVE REFERENCED PRO FINSPECTING THE WORK PERMI	OPERTY NOT SPECIFICALLY DESCRIBED IN
Email Address	1 1 1 1 1 1 1 1 1 1 1 1 1 1 1 1 1 1 1	Date	2	,	
Fit com v=s					
Title/Company		• > *	0.5E 9.5E		
			ANCE OF HOWARD	COUNTY	
EARLY CENTRAL CONTRACTOR		LEASE WRITE NEAT FOR OFFICE U		Market de Salerence X	Must Votable warderstand a
The state of the s	AND THE REPORT OF THE PROPERTY OF	IN NAME OF PARTY OF PERSONS IN	Charles Service Co. S. S. S. S. S.	PERSONAL OF ANY MERCH	CHARLES SERVICE THE STREET
AGENCY DATE	SIGNATURE OF APPROVAL	DPZ SETBACK IN	FORMATION	Filing Fee	\$

AGENCY	DATE	SIGNATURE OF APPROVAL
State Highways		
Building Officials	- 124	
PSZA (Zoning)		
PSZA (Engineering)		-
-Health	referred	Relat

Is Sediment Control approval	required for issuance? ☐ Yes ☐ No
CONTINGENCY CONSTRUC	

DPZ SETBACK INFORMATION		
Front:		
Rear:		-77
Side:		
Side St.:		
All minimum setbacks met?	☐ Yes	□No
Is Entrance Permit Required?	☐ Yes	□No
Historic District?	☐ Yes	ONo
Lot Coverage for New Town 2	one:	
SDP/Red-line approval date:		

Filing Fee	\$
Permit Fee	\$ (1,1.)
Tech Fee	\$ 117
Excise Tax .	\$
PSFS	\$
Guaranty Fund	\$
Add'I per Fee	\$
Total Fees	\$ 11/0/00
Sub- Total Paid	\$
Balance Due	\$
Check	# 1111/11

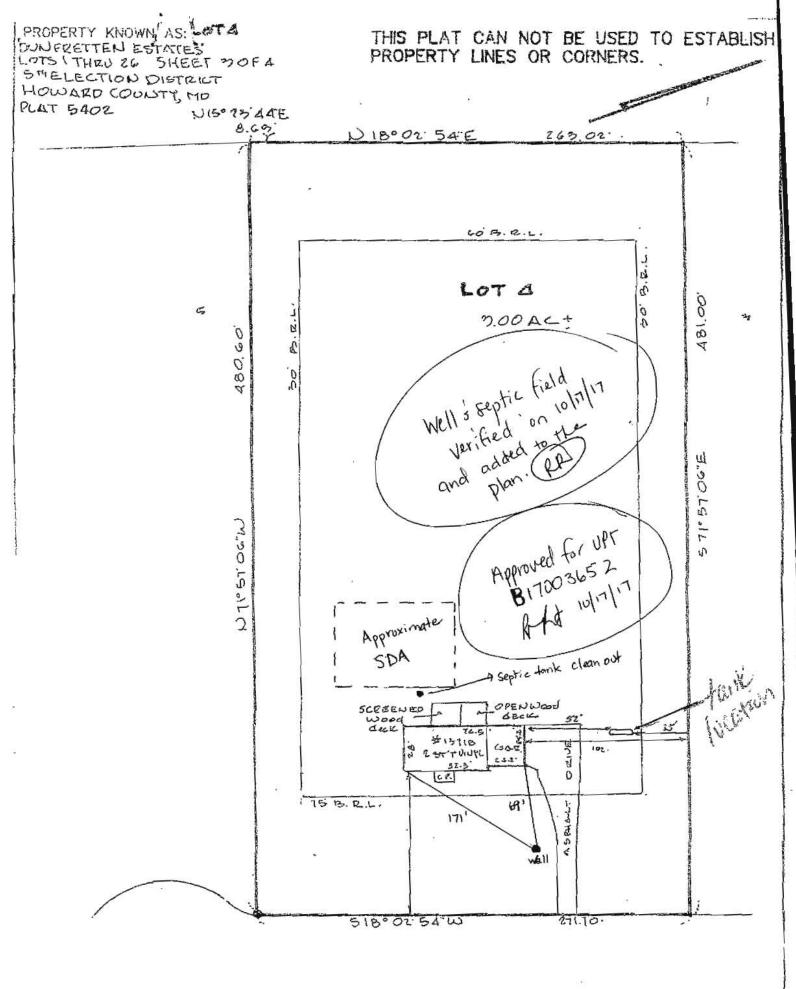

PASTURE GREEN

LOCATION DRAWING

CERTIFICATION	SEAL	SCALE 1=60 DATE 4-19-00
his is to certify that I have surveyed he property known as: 127(8) PASTURE CAREEN The information shown has been established by current acceptable survey procedures and rom available record information. This drawings to be used for Title Transfer Financing, or lefinancing Only and IS NOT to be used for the Establishment of Property Lines, Location or Fences. Garages, Buildings, or other ixisting or Future Improvements.	OF MARINE POLL	IDE Inc. 9250 Rumsey Road Suite 106 Columbia, Maryland 21045 (410) 715—1070 (Balt.) (301) 596—3424 (Wash) (410) 715—9540 (Fax)