

COMPLETE THIS FORM WHEN DROPPING OFF ANY
CORRESPONDENCE AND/OR PLANS TO THE HOWARD COUNTY
DEPARTMENT OF INSPECTIONS, LICENSES AND PERMITS COUNTER:

Date: 10/20/17

To: Andrew Arnold RECEIVED
(Person's Name and Division)

From: Timothy Dawson (410) 949-0068 OCT 20 2017
(Your Name, Company Name and Telephone Number)

Subject: Project name _____ PLAN REVIEW DIVISION

Project site address 5502 HANZIS FARM LANE

Permit # B17003698 SDP # _____

Other information pertinent to this project _____

- ✓ Please check the attachments below that you are submitting with this transmittal:
- ☐ Letter of response to address plan review comment letter
- ✓ ☒ Revised plans and/or revised details: When submitting for a complete re-review, duplicate sets shall be submitted.
- ☐ Letter Summarizing Changes
- ☐ Energy conservation calculations
- ☐ Copies of _____ (be specific).
- ☐ Health Department Request ☐ DPZ/ DED Request ☐ Applicant's Request
- ☐ Two sets of single family dwelling model plans to be placed on permanent file: Model name and/or # _____
- ☐ Other _____

Contact Person Information: (Required)

Timothy Dawson
Please Print Name

Telephone No: 4109490068

E-Mail Address: tdawson143@gmail.com

PLEASE ASSURE ALL DOCUMENTS AND/OR REVISIONS ARE APPROPRIATELY SIGNED AND SEALED, IF NECESSARY, BY A LICENSED ARCHITECT OR ENGINEER. PLEASE BE ADVISED THAT INSUFFICIENT INFORMATION MAY RESULT IN THE DELAY OF REVIEW BY THE PLANS EXAMINER. THE DEPARTMENT OF INSPECTIONS, LICENSES AND PERMITS WILL CONTACT YOU IF THERE IS A PROBLEM. IN ADDITION, ONCE THE BUILDING PERMIT IS APPROVED BY THE PLAN REVIEW DIVISION AND ALL OTHER REQUIRED SIGNATORY AGENCIES, AND THE BUILDING PERMIT IS READY FOR ISSUANCE, THE PERMIT DIVISION WILL NOTIFY THE APPROPRIATE CONTACT PERSON FOR PERMIT PICK UP. ALL PERMIT STATUS INQUIRIES SHALL BE DIRECTED TO THE PERMIT DIVISION AT 410-313-2455. CODE RELATED QUESTIONS AND PLAN REVIEW INQUIRIES SHALL BE DIRECTED TO THE PLAN REVIEW DIVISION AT 410-313-2436. PLEASE ALLOW A MINIMUM OF FIVE (5) WORKING DAYS FOR ANY PLAN SUBMITTALS TO BE REVIEWED. THANK YOU.

Received by MF

Revision CC: PTZ
Health

10/27/17


50' From House

REVISED

Date: 10-20-17

Comments: Revised site plan to show dimensions and distances

Ten Oaks Road

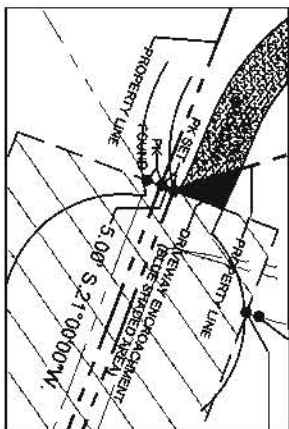

DETAIL A



NOTES:

- 1) Properly subject to any/all rights-of-way, easements, and/or covenants of record and/or imposed by law.
- 2) No title report furnished.
- 3) See Howard County Plate 7586 and 7369
- 4) Area Tack

216 664 70 SEASIDE AVE
ATLANTA, GA 30316



GRADEN A. ROGERS - Property Line Surveyor
Maryland License No. 119

LEGEND

- 14 PIPE POUND
- 18 IRON BAR POUND
- 18 NAIL POUND
- 18 MONUMENT POUND
- 18 STONE POUND
- 18 CLIPPED PIPE
- 18 IRON BAR SET
- 18 PK SET
- 18 POINT ON LINE
- 18 RETAINERS
- 18 CONCRETE
- 18 ONE RUNNING
- 18 GATE
- 18 RIGHT-OF-WAY

BOUNDARY SURVEY
 5502 Harris Farm Lane
 Liber 17542 Folio: 253
 Howard County
 MARYLAND
 August 9, 2017
 Scale: See Drawing
 File No: LT21741096