

Building Permit Application
Howard County Maryland
Department of Inspections, Licenses and Permits
3430 Court House Orive
Permits: 410-313-2455
www.howardcountymd.gov

Date Received 2017 007 11 9× 10:45

Ilding Address: 11950 Sinop	SON Road		Property Owner's Name:	obert 1	Hoch	
Clarkerille state:	MD Zlo Code: 2	1039	Address: 11950 Sic	mpson (	Lone	
te/Apt. #SDP		307 Sec. 30 Se	CHOCK SHITTE	State: MAL	Zip Code 21029	
			Email: (201 + 725	- 1807/11	410-409-875	
nsus Tract:		V=	SN 1550 (# 30)		Property State Section 2	
ction:Area			Applicant's Name & Mailing Applicant's Name:		raer than stated nerein)	
Map: OD4 Parcel:			Address:			
ning: Map Coordina	tes:Lot Size	e:	City:			
sting Use: Single Franci	and lower		Phone:Email:	Fax:		
				T C	T C	
posed use: Single Famil			Contractor Company: Sau	thorn 5	lates Cop.	
imated Construction Cost: \$ 2,0	00 =		Contact Person: Jay Address: 121 John	Wishau		
scription of Work: Installa	ction of a l	Dugal	City: Westrawister Sta	CM	7in Code: 21160	
bove around Pro	nane Tank	2-	License No. 20000	60625	zip code.	
01-			Phone: 40-848-9	70 Fax: 4	40-848-7852	
011	Hoch		Email: Jay - NUShaw			
cupant/Tenant Name: Hobert	HOCK					
is tenant space previously occupied?	₽Yes	□No	Engineer/Architect Company	r:		
ntact Name:			Responsible Design Prof.:			
dress:		Address:				
y:			Morrest of Management Control of the		Market .	
	Table 1980 The second of the second of				Zip Code:	
one:	Fax:		Phone:	Fax:		
ail:			Email:			
monated Duttation Characteristics	Backdon states at	armata data	The man		Contraction factors a linearing	
immercial Building Characteristics	Residential Building Ch		Electric:	□ No		
of stories:	Depth	Width		Z No	The state of the s	
oss area, sq. ft./floor:	1st floor:		Water Supply		W Committee of the comm	
	2 <sup>nd</sup> floor:		☐ Public		A CONTROL OF THE CONT	
ea of construction (sg. ft.):	Basement:		GZ Private	-		
	☐ Finished Basement		Sewage Dispos	al .		
e group:	☐ Unfinished Basement ☐ Crawl Space			<u> </u>	2-50 Parts Tituling	
Construction type:			□ Public			
Reinforced Concrete	No. of Bedrooms:		Private	4		
Structural Steel <u>Multi-family Dw</u>		elling	Heating System	<u>n</u>		
Masonry	No. of efficiency units:		O Electric Oil		1.7.28 TEPRESULTER	
Wood Frame	No. of 1 BR units:		☐ Natural Gas ☐ Propan	ne Gas	(1) (1) (1) (1) (1) (1) (1) (1) (1) (1)	
State Certified Modular	No. of 2 BR units: No. of 3 BR units:		O Other:			
	Other Structure:		Sprinkler System	<u>n:</u>	AND MAKE BEFORE THE	
	Dimensions:		☐ Yes ☐ No		A CHECK TO A COLUMN	
Roadside Tree Project Permit	Footings:				(1) 10 10 10 10 10 10 10 10 10 10 10 10 10	
□Yes StNo	Roof:		Grading Perm	it Number:		
Roadside Tree Project Permit #	State Certified Modul	ar			<u> </u>	
	☐ Manufactured Home		Building Shell Per	mit Number:		
UNDERSIGNED HEREBY CERTIFIES AND AGRE TH ALL REGULATIONS OF HOWARD COUNTY W SARPHICATION; (S) THAT HE/SHE GRAN'S COU A COUNTY W SARPHICATION; (S) THAT HE/SHE GRAN'S COU A COUNTY OF THE COUNTY THE THE C	WHICH ARE APPLICABLE THERETO;	(4) THAT HE/SHE WILL FER ONTO THIS PROPE	L PERFORM NO WORK ON THE ABOVE	REFERENCED PRO THE WORK PERMIT	PERTY NOT SPECIFICALLY DESCRIBED IN	
		to: DIRECTOR OF FIN PLEASE WRITE NEAT -FOR OFFICE (		March S.		
	GNATURE OF APPROVAL	DPZ SETBACK II	NFORMATION	Filing Fee	\$ (6)	
AGENCY DATE S		Front:		Permit Fee	\$ 100	
AGENCY DATE SI State Highways		Reac				
		Rear: Side:		Excise Tax		
State Highways Building Officials		Side: Side St.:		Excise Tax PSFS	\$ \$	
State Highways  Building Officials  PSZA { Zoning }		Side: Side St.: All minimum se		Excise Tax PSFS Guaranty	\$ \$ \$ Fund \$	
State Highways Building Officials PSZA { Zoning } PSZA ( Engineering )	0.06	Side: Side St.: All minimum se	mit Regulred?   Yes   No	Excise Tax PSFS	\$ S Fund S Fee S	
State Highways  Building Officials  PSZA { Zoning }	RICE TO SERVICE OF THE PROPERTY OF THE PROPERT	Side: Side St.: All minimum se Is Entrance Per Historic District	mit Required?    Yes    No ?    Yes    No or New Town Zone:	Excise Tax PSFS Guaranty Add1 per	\$ \$ \$ \$ \$ \$ \$ \$ \$ \$ \$ \$ \$ \$ \$ \$ \$ \$ \$	



Location Drawing

This plat is of benefit to a consumer only insofar as it is required by a lender or a title insurance company or its agent in connection with contemplated transfer, financing or refinancing. This plat is not to be retied upon for the establishment or location of fences, garages, buildings, dwellings or other existing or future improvements nor does this plat purport to reflect setbacks or other distances with any specific level of accuracy. This plat does not provide for the accurate identification of property boundary lines, but such identification may not be required for the transfer of title or securing financing or refinancing. The approximate location of the dwelling is shown in relation to the apparent property lines for the property known as

11950 Simpson Road Howard County, Maryland


7/27/09

Design Corporation Ruxton 8422 Bellona Lane Suite 300 Towson, Naryland 21204

> 410-823-5000 410-823-0115fax

rdcoruxtondesign.com

www.ruxtondesign.com

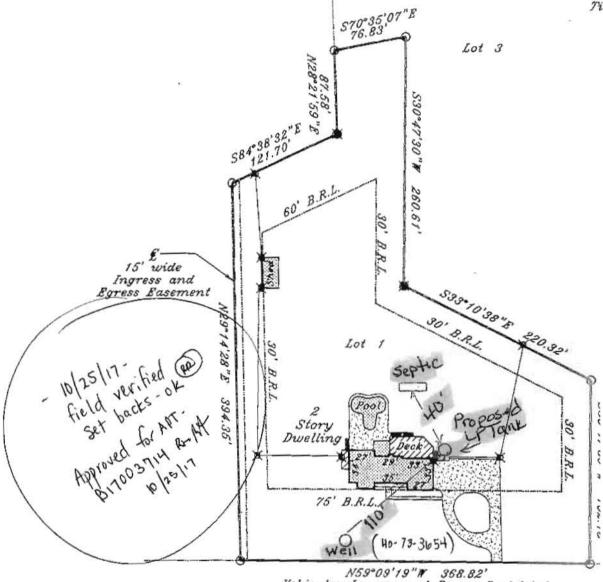

Vehicular Ingress and Egress Restricted

Front

SIMPSON

ROAD

1207