

Directions on last sheet.

6/17/65 - Approved - JHK

PERMIT

SEWAGE DISPOSAL SYSTEM

MARYLAND STATE DEPARTMENT OF HEALTH

HOWARD COUNTY

ELLICOTT CITY

DISTRICT 3

DATE 4/13/65

INDEXED

W. W. Wagner

IS PERMITTED TO INSTALL X ALTER

ADDRESS Gamber Rd., Finksburg, Maryland PHONE

A SEWAGE DISPOSAL SYSTEM LOCATED AT

SUBDIVISION ROAD Old Court Rd. LOT

PROPERTY OWNER Alvin A. Mullinix & Wife

ADDRESS

SPECIFICATIONS - 3 bedrooms

DRAIN FIELD DEPTH FEET, BOTTOM AREA SQ. FT.

SEEPAGE PITS ABSORBENT SIDE-WALL AREA SQ. FT.

SEPTIC TANK CAPACITY 750 GALLONS

FOR GARBAGE GRINDER, INCREASE DISPOSAL AREA 22% & TANK CAPACITY 50%.


OTHER Dry well - 300 sq. ft. sidewall area below inlet pipe. Inlet pipe to be 3 ft. below grade. 8' x 14' would be adequate.
Place dry well about 162 ft. from front lot line and in center of lot.

PLANS APPROVED BY D. W. Monaghan DATE 3/2/65

FILL SEPTIC TANK AND DISTRIBUTION BOX WITH WATER BEFORE CALLING FOR AN INSPECTION. COVER NO WORK UNTIL INSPECTED AND APPROVED.

NEITHER THE HOWARD COUNTY COMMISSIONERS NOR THE HEALTH DEPARTMENT IS RESPONSIBLE FOR THE SUCCESSFUL OPERATION OF ANY SYSTEM.

A 09580

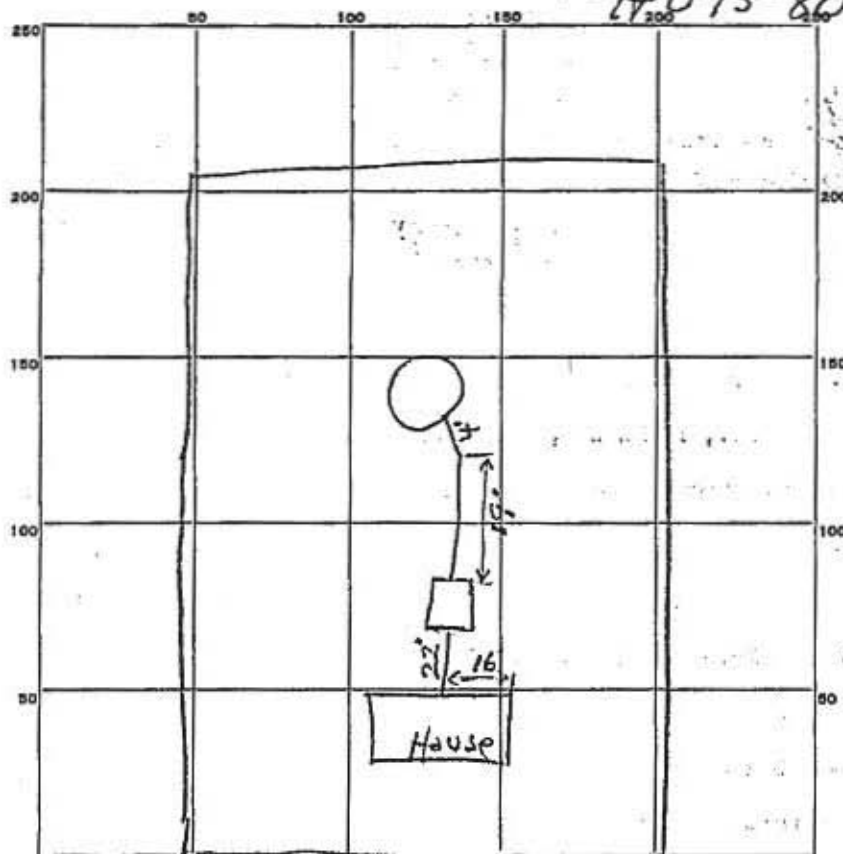

INDICATE NORTH. - NAME ADJOINING ROADWAY AS BASE LINE.

OLD COURT RD

PERMIT CARD OK

SEPTIC TANK, LEVEL OK

CLEANOUTS OK

DISTRIBUTION BOX, LEVEL _____

TILE FIELD, DEPTH _____ FT. TRENCH WIDTH _____ FT.

GRAVEL DEPTH _____ IN. TOTAL LENGTH _____ FT.

NUMBER OF TRENCHES _____ TOTAL BOTTOM AREA _____

SEEPAGE PITS, INSIDE DIAMETER 10 FT. DEPTH BELOW INLET 10 FT.

ABSORBENT AREA 314 SQ. FT.

REMARKS

A09580 tests in area of S.W. 3' in at 4' ft
7 1/2' in at 9' ft Dm

Well permit # 65-W-396

Harry Blumstein #294

DATE SYSTEM APPROVED

6/17/65

INSPECTOR

D. H. Kilmer