

4/20/89 1146x16

03-314006

PERMIT

SEWAGE DISPOSAL SYSTEM

MARYLAND STATE DEPARTMENT OF HEALTH

HOWARD COUNTY
BUREAU OF ENVIRONMENTAL HEALTH
461-9933

INDEXED

P 45077

A 40579

DISTRICT 6th

DATE 10/10/88

DATE SYSTEM APPROVED 11/20/88

INSPECTOR RB

Paul Schiessler/South Carroll Backhoe, Inc. IS PERMITTED TO INSTALL ☒ ALTER

ADDRESS 4410 Salem Bottom Road, Westminster, Maryland PHONE 875-4197

SUBDIVISION Roscommon Estates ROAD 3216 Roscommon Drive LOT 3

PROPERTY OWNER S. F. Contractors Mark & Jennifer Faris

ADDRESS

IF GARBAGE GRINDER IS USED INCREASE SEPTIC TANK CAPACITY BY 50% AND ABSORPTION AREA BY 22%

GARBAGE GRINDER? YES NO ☒

SEPTIC TANK CAPACITY 1250 GALLONS NUMBER OF BEDROOMS 4

TRENCHES - 180 sq. ft. per bedroom. Trench to be 2 feet wide. Inlet 3 feet below original grade. Bottom maximum depth 8 feet below original grade. Effective area begins at 3 feet below original grade. 5 feet of stone below distribution pipe.

LOCATION - Start the first trench 210 feet from Roscommon Drive and 160 feet from the right (403') lot line. Run trench(es) along contour in both directions.

NOTE - No trench to exceed 100 feet in length. Provide 6" - 8" diameter cleanout and cap to grade or above on septic tank. n/cw

PLANS APPROVED BY C. Williams DATE 10/17/88

COVER NO WORK UNTIL INSPECTED AND APPROVED

NEITHER THE HOWARD COUNTY COUNCIL NOR THE HEALTH DEPARTMENT IS RESPONSIBLE FOR THE SUCCESSFUL OPERATION OF ANY SYSTEM

NOTE: CLEANOUT REQUIRED EVERY 70 FEET OF SEWER LINE AND/OR AT 90° SWEEPS IN LINES FROM HOUSE TO DRAIN FIELDS

NOTE: ALL PARTS OF SEPTIC SYSTEMS (I.E. TANK, DISTRIBUTION BOX, TRENCHES) TO BE 100 FEET FROM WELL (UNLESS OTHERWISE SPECIFICALLY AUTHORIZED)

NOTE: IF DEEP TRENCHES ARE USED CALL FOR INSPECTION BEFORE AND AFTER PLACING GRAVEL IN TRENCHES

NOTE: NO DRY WELL SHALL EXCEED 15 FOOT IN DIAMETER NO ABSORPTION TRENCH TO EXCEED 100 FEET IN LENGTH

NOTE: ALL PIPE FROM HOUSE TO SEPTIC TANK MUST BE CAST IRON OR SCHEDULE 40 PVC OR ABS

PERMIT VOID AFTER TWO YEARS

NOTE: INSTALL STAND PIPE ON SEPTIC TANK AND DRY WELL. STAND PIPES MUST BE 6 INCHES IN DIAMETER. CAST IRON, CONCRETE OR TERRA COTTA OR PVC OR ABS ACCEPTED. IF TOP OF SEPTIC TANK IS DEEPER THAN 3 FEET, MANHOLE TO GRADE REQUIRED


NOTE: DISTRIBUTION BOXES MUST HAVE BAFFLES

BLDG. PERMIT SIGNED
AND RETURNED 3/4/93

Serial # 47494

*INSTALLER IS RESPONSIBLE FOR OBTAINING FINAL APPROVAL ON THIS PERMIT

*CALL 461-9933 FOR INSPECTION OF SEPTIC SYSTEMS.

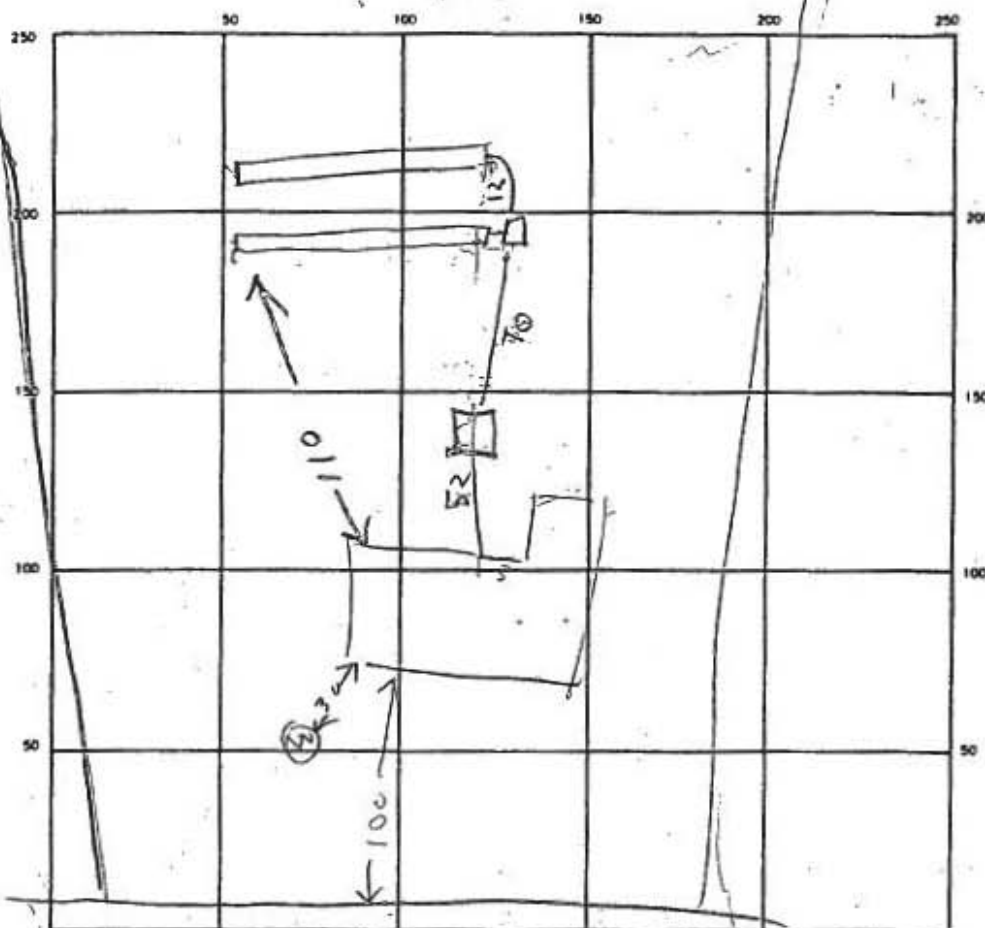

INDICATE NORTH - NAME ADJOINING ROADWAY AS BASE LINE
 BOS common DR

SEPTIC TANK LEVEL

1580

CLEANOUTS

ST
OK

DISTRIBUTION BOX LEVEL

DRAIN FIELD/TILE FIELD DEPTH

8/8 FT

TRENCH WIDTH

2 FT

INLET DEPTH

3/3 FT

EFFECTIVE GRAVEL DEPTH

5/5 FT

TOTAL LENGTH

75/73 FT

NUMBER OF TRENCHES

2

ONE SIDEWALL BOTTOM AREA

740

50 FT

DRYWELL INSIDE DIAMETER

FT

EFFECTIVE DEPTH BELOW INLET

FT

ABSORBENT AREA

50 FT

REMARKS

11/20/89^{AN}

TRENCH #1 OK

11/20/89^{AN}

TRENCHES FINISHED

DATE SYSTEM APPROVED

11/20/89

INSPECTOR

Raymond Hodge

APPLICATION

SEWAGE DISPOSAL TESTING

STATE OF MARYLAND - DEPARTMENT OF HEALTH AND MENTAL HYGIENE

HOWARD COUNTY HEALTH DEPARTMENT
ENVIRONMENTAL HEALTH SERVICES

P.O. BOX 476 ELLICOTT, MARYLAND 21043
TELEPHONE 992-2330

A 31026

P _____

DISTRICT 3rd

DATE 11/07/80

TO: THE COUNTY HEALTH OFFICER
ELLICOTT CITY, MARYLAND

I HEREBY APPLY FOR THE NECESSARY TEST IN ORDER TO CONSTRUCT (OR RECONSTRUCT) A SEWAGE DISPOSAL SYSTEM.

PROPERTY OWNER FARNANDIS FARMS, INC

ADDRESS 9075 FREDERICK RD PHONE 989-8300

PROPERTY LOCATION:

SUBDIVISION Howard County, Md LOT NO 6

ROAD-AND-DESCRIPTION off PEEFFELKORN RD, 2000 ft left of Rt 32

SIZE OF LOT 3 ACRES TYPE BLDG _____

THE SYSTEM INSTALLED UNDER THIS APPLICATION IS ACCEPTABLE ONLY UNTIL PUBLIC FACILITIES BECOME AVAILABLE.

I FULLY UNDERSTAND THE FEE CONNECTED WITH THE FILING OF THIS PERC TEST APPLICATION IS NON-REFUNDABLE UNDER

ANY CIRCUMSTANCES.

SIGNATURE OF APPLICANT LIBERTY-FARNANDIS ENTERPRISES / Curtis T. Byrd

APPROVED BY _____ FOR _____ DATE _____


REJECTED BY _____ FOR _____ DATE _____

HOLD PENDING FURTHER TESTS _____ DATE _____

REASONS FOR REJECTION OR HOLDING _____

THIS IS NOT A PERMIT

Lot 6

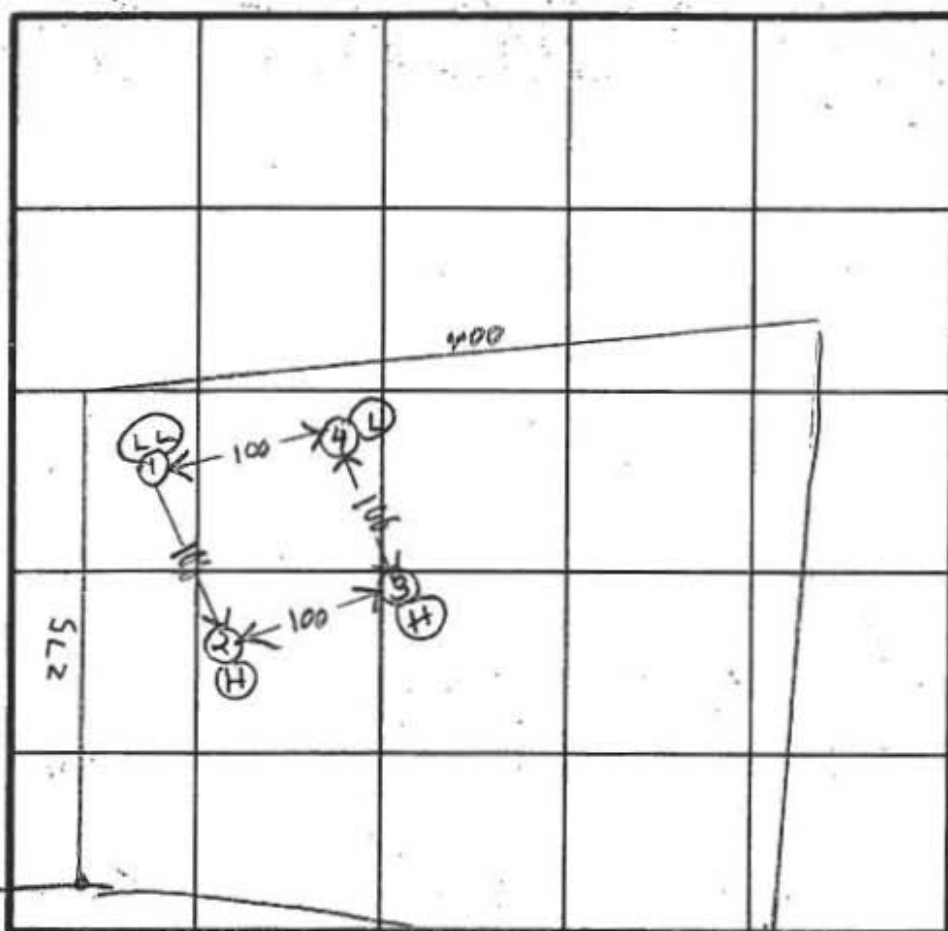

INDICATE NORTH - NAME ADJOINING ROADWAY AS BASE LINE.

TALLY HO DRIVE

DATE	TEST NO.	DEPTH	PRE-WET		TEST - 1" DROP		TIME
			START	STOP	START	STOP	
11/25/00	1 S	4	306	308	308	312	4
	1 D	9	306	309	309	314	5
	2 S	3 1/2	322	328	328	333	5
	2 D	8 1/2	322	324	324	328	4
	3 S	3 1/2	338	340	340	344	4
	3 D	4	338	344	344	349	4
	4 S	4	350	356	356	402	6
	4 D	8	350	352	352	356	4
11/25/00	IV	12	SEE SOIL PROFILE DRY				
2/1/01	5	4	VIS OK -		SEE A 40579	EST 5-7 MIN	

air
Tumb
5 min
max
Depth
3 1/2 ft

REMARKS

TYPE OF SOIL

TESTED BY

RHJS

SURVEYOR L LIPPIN

ALSO PRESENT

OK ETHERMAN

CW