

APPLICATION

FOR PERCOLATION TESTING AND SITE EVALUATION

TEST DATE(S) _____ TEST TIME _____

AP 520108-5

AGENCY REVIEW: _____

DATE 4/9/04

DO NOT WRITE ABOVE THIS LINE

I HEREBY APPLY FOR THE NECESSARY TESTING/EVALUATION PRIOR TO ISSUANCE OF SEWAGE DISPOSAL SYSTEM PERMIT(S) TO:

CHECK AS NEEDED:

- ☒ CONSTRUCT NEW SEPTIC SYSTEM(S)
☐ REPAIR/ADD TO AN EXISTING SEPTIC SYSTEM
☐ REPLACE AN EXISTING SEPTIC SYSTEM

CHECK AS NEEDED:

- ☒ NEW STRUCTURE(S)
☐ ADDITION TO AN EXISTING STRUCTURE
☐ REPLACE AN EXISTING STRUCTURE

CHECK ONE:

- ☒ CREATE NEW LOT(S)
☐ BUILD ON AN EXISTING LOT IN A SUBDIVISION
☐ BUILD ON AN EXISTING PARCEL OF RECORD

IS THE PROPERTY WITHIN 2500' OF ANY RESERVOIR?

- ☐ YES
☒ NO

THE TYPE OF STRUCTURE IS:

- ☒ RESIDENTIAL WITH UNKNOWN PROPOSED BEDROOMS IN THE COMPLETED STRUCTURE (NOTE UNKNOWN IF APPROPRIATE)
☐ COMMERCIAL (PROVIDE DETAIL OF NUMBERS AND TYPES OF EMPLOYEES/ CUSTOMERS ON ACCOMPANYING PLAN)
☐ INSTITUTIONAL/GOVERNMENT (PROVIDE DETAIL OF NUMBERS AND TYPES OF EMPLOYEES/USERS ON ACCOMPANYING PLAN)

PROPERTY OWNER(S) LDG Inc. Lee Plaza

DAYTIME PHONE 301-585-7000

CELL _____

FAX _____

MAILING ADDRESS 8601 Georgia Ave.

Silver Spring

MD

20910

STREET

CITY/TOWN

STATE

ZIP

APPLICANT VanMar Associates Inc.

DAYTIME PHONE 301-829-2890

CELL _____

FAX _____

MAILING ADDRESS 310 South Main St.

Mount Airy

MD

21771

STREET

CITY/TOWN

STATE

ZIP

APPLICANT'S ROLE: DEVELOPER BUILDER BUYER RELATIVE/FRIEND REALTOR CONSULTANT

PROPERTY LOCATION

SUBDIVISION/PROPERTY NAME Schwabe Farms

LOT NO. 20

PROPERTY ADDRESS MD Route 32

West Friendship

STREET

TOWN/POST OFFICE

TAX MAP PAGE(S) 15

GRID 5

PARCEL(S) 12

PROPOSED LOT SIZE 1AC±

AS APPLICANT, I UNDERSTAND THE FOLLOWING: THE SYSTEM INSTALLED SUBSEQUENT TO THIS APPLICATION IS ACCEPTABLE ONLY UNTIL PUBLIC SEWERAGE IS AVAILABLE. THIS APPLICATION IS COMPLETE WHEN ALL APPLICABLE FEES AND A SUITABLE SITE PLAN HAVE BEEN RECEIVED. I ACCEPT THE RESPONSIBILITY FOR COMPLIANCE WITH ALL M.O.S.H.A. AND "MISS UTILITY" REQUIREMENTS. APPROVAL IS BASED UPON SATISFACTORY REVIEW OF A PERC CERTIFICATION PLAN. TEST RESULTS WILL BE MAILED TO APPLICANT.

Danielle Spout
SIGNATURE OF APPLICANT

HOWARD COUNTY HEALTH DEPARTMENT, BUREAU OF ENVIRONMENTAL HEALTH, WELL AND SEPTIC PROGRAM
3525-H ELLICOTT MILLS DRIVE, ELLICOTT CITY, MARYLAND 21043-4544 (410) 313-1771 FAX (410) 313-2648
TDD (410) 313-2323 TOLL FREE 1-877-4MD-DHMH

AP

495


Blank L	1'
Red/Yellow micaceous Scl	4'
Yellow/Brown Sl w/ Pockets of white silt + trace Rust	8'4"
Water	10 1/2'

496

Brown L	1'
Brown/Yellow micaceous Scl	4'
Brown/gray micaceous Sl	8'4"
Water	10 1/2'

497

Brown L	1'
Orange/Yellow Brown Scl	4'
Black/Brown Yellow/Red micaceous Sl w/ Cavities	8'4"
Water	10 1/2'

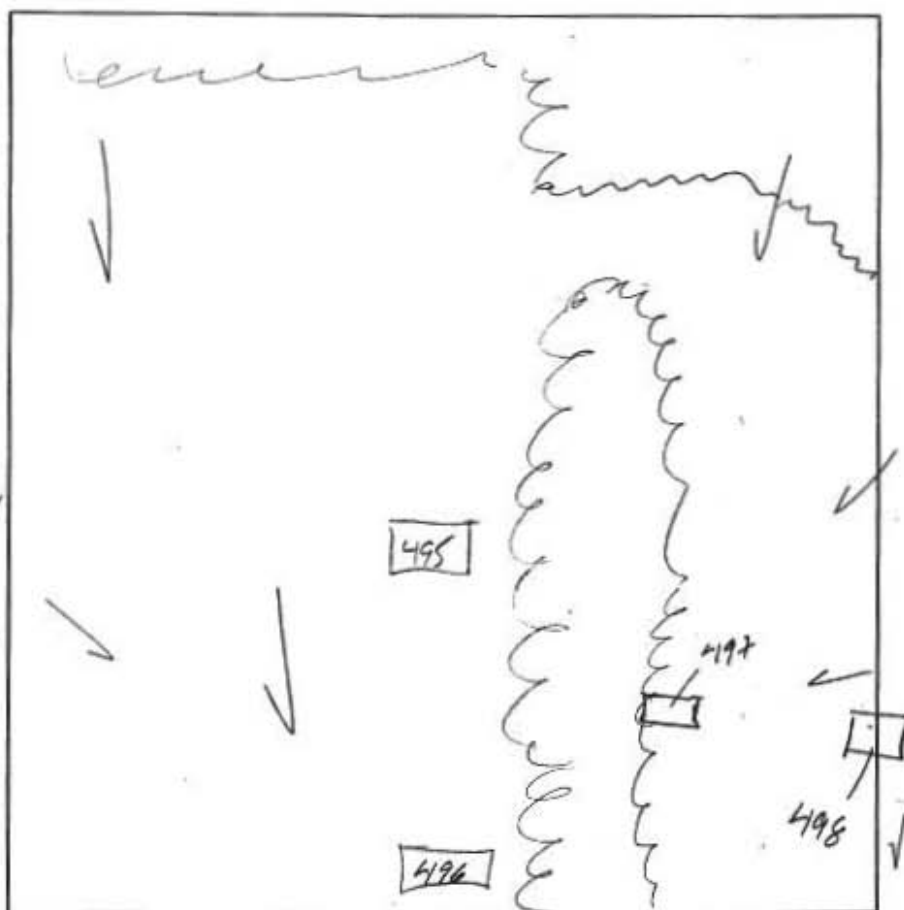

498

Brown L	1'
Brown/Orange Scl	2 1/2'
Yellow/Brown micaceous Sl	8 1/2'
Black/Brown white Sl trace Rock	11'
Water	11 1/2'

DATE	TEST #	DEPTH	START	BREAK 1" DROP	STOP 2" DROP	TIME OF 2ND INCH	P/F/H
7/15/04	495	4' 10 1/2"	2:38	2:44	2:58	14 min	P
	496	4' 8 1/2"	2:55 - Fail				F
	498	11 1/2"	3:11	3:18	3:33	15 min	P
	497	4' 8"	- Visual				F

REMARKS 496 - Poor landscape position - 497

SANITARIAN KJR BACKHOE Justin OTHERS Zack

TEST HOLES USED IN SDA _____ AVG. PERC TIME _____ SQ. FT/BR _____

TRENCH WIDTH _____ INLET DEPTH _____ MAX. BOT DEPTH _____ EFFECTIVE SW _____

AP
538
Brown L 1'
Red/Brown
Orange
Sil
w/ 20%
Qtz 4 1/2'
Yellow/Brown
micaceous
SL
w/ trace
Rock 12'

539
Brown L 1'
Red/Orange
Heavy
CL 4 1/2'
Brown/Red
micaceous
SL
w/ 20%
Platy
Serpentine 11'

B
Brown L 1'
Orange/Brown
micaceous
SL 3'
Yellow/Brown
micaceous SL
w/ 20%
Platy
Qtz 11'


529
Brown L 1'
Red/Brown
micaceous
Sil
w/ 35%
Platy
Serpentine 3'
Brown/Orange
Sil w/ 10%
Platy
Serpentine 6 1/2'
Yellow/Brown
micaceous Sil
w/ 10%
Serpentine 12'

528
Brown
Heavy CL 1'
Red/Orange
Sil 4'
Yellow/Brown
SL 4'
- Water - 4'
10'

525
Brown
CL 2'
Yellow/Brown
CL w/
25% Serpentine
Water 5'

DATE	TEST #	DEPTH	START	BREAK 1" DROP	STOP 2" DROP	TIME OF 2nd INCH	P/F/H
11/3/01	538	5' / 12'	1:52	1:57	2:07	10 min	P
	539	5' / 11'	2:06	2:08	2:10	2 min	P
	B	4' / 11'	1:37	1:39	1:42	3 min	P
	529	5' / 12'	2:44	- Polled at 3:10		Slow	F
	528	- / 10'	- Visual -			H ₂ O	F
	525	- / 5'	- Visual -			H ₂ O	F

REMARKS all holes dug per plan
 SANITARIAN KJB BACKHOE Justin B. OTHERS _____
 TEST HOLES USED IN SDA _____ AVG. PERC TIME _____ SQ. FT/BR _____
 TRENCH WIDTH _____ INLET DEPTH _____ MAX. BOT DEPTH _____ EFFECTIVE S/W _____

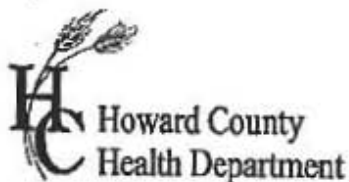

APPLICATION

FOR PERCOLATION TESTING AND SITE EVALUATION

TEST DATE(S) _____ TEST TIME _____

AGENCY REVIEW: _____

AP 520108R
DATE 4/9/04

DO NOT WRITE ABOVE THIS LINE

I HEREBY APPLY FOR THE NECESSARY TESTING/EVALUATION PRIOR TO ISSUANCE OF SEWAGE DISPOSAL SYSTEM PERMIT(S) TO:

CHECK AS NEEDED:

- ☒ CONSTRUCT NEW SEPTIC SYSTEM(S)
☐ REPAIR/ADD TO AN EXISTING SEPTIC SYSTEM
☐ REPLACE AN EXISTING SEPTIC SYSTEM

CHECK AS NEEDED:

- ☒ NEW STRUCTURE(S)
☐ ADDITION TO AN EXISTING STRUCTURE
☐ REPLACE AN EXISTING STRUCTURE

CHECK ONE:

- ☒ CREATE NEW LOT(S)
☐ BUILD ON AN EXISTING LOT IN A SUBDIVISION
☐ BUILD ON AN EXISTING PARCEL OF RECORD

IS THE PROPERTY WITHIN 2500' OF ANY RESERVOIR?

- ☐ YES
☒ NO

THE TYPE OF STRUCTURE IS:

- ☒ RESIDENTIAL WITH UNKNOWN PROPOSED BEDROOMS IN THE COMPLETED STRUCTURE (NOTE UNKNOWN IF APPROPRIATE)
☐ COMMERCIAL (PROVIDE DETAIL OF NUMBERS AND TYPES OF EMPLOYEES/ CUSTOMERS ON ACCOMPANYING PLAN)
☐ INSTITUTIONAL/GOVERNMENT (PROVIDE DETAIL OF NUMBERS AND TYPES OF EMPLOYEES/USERS ON ACCOMPANYING PLAN)

PROPERTY OWNER(S) LDG Inc. Lee Plaza

DAYTIME PHONE 301-585-7000 CELL _____ FAX _____

MAILING ADDRESS 8601 Georgia Ave. Silver Spring MD 20910
STREET CITY/TOWN STATE ZIP

APPLICANT VanMar Associates Inc.

DAYTIME PHONE 301-829-2890 CELL _____ FAX _____

MAILING ADDRESS 310 South Main St. Mount Airy MD 21771
STREET CITY/TOWN STATE ZIP

APPLICANT'S ROLE: DEVELOPER BUILDER BUYER RELATIVE/FRIEND REALTOR CONSULTANT

PROPERTY LOCATION

SUBDIVISION/PROPERTY NAME Schwabe Farms LOT NO. 101

PROPERTY ADDRESS MD Route 32 West Friendship 21794
STREET TOWN/POST OFFICE

TAX MAP PAGE(S) 15 GRID 5 PARCEL(S) 12 PROPOSED LOT SIZE 1 AC ±

AS APPLICANT, I UNDERSTAND THE FOLLOWING: THE SYSTEM INSTALLED SUBSEQUENT TO THIS APPLICATION IS ACCEPTABLE ONLY UNTIL PUBLIC SEWERAGE IS AVAILABLE. THIS APPLICATION IS COMPLETE WHEN ALL APPLICABLE FEES AND A SUITABLE SITE PLAN HAVE BEEN RECEIVED. I ACCEPT THE RESPONSIBILITY FOR COMPLIANCE WITH ALL M.O.S.H.A. AND "MISS UTILITY" REQUIREMENTS. APPROVAL IS BASED UPON SATISFACTORY REVIEW OF A PERC CERTIFICATION PLAN.

TEST RESULTS WILL BE MAILED TO APPLICANT.

Daniel Stout
SIGNATURE OF APPLICANT

HOWARD COUNTY HEALTH DEPARTMENT, BUREAU OF ENVIRONMENTAL HEALTH, WELL AND SEPTIC PROGRAM
3525-H ELLICOTT MILLS DRIVE, ELLICOTT CITY, MARYLAND 21043-4544 (410) 313-1771 FAX (410) 313-2648
TDD (410) 313-2323 TOLL FREE 1-877-4MD-DHMH

NP _____

493


Brown
L
1'
Orange/Brown
Red micaceous
Scl
4 1/2"
Orange/Yellow
Sl
10"
Yellow/Brown
S
-10% - micaceous
Schist
11'

492

Brown
L
1'
Orange
Red micaceous
Scl
7'
Yellow/Brown
micaceous
Sl
L 50%
micaceous
Schist
fragments
7'

494

Brown/Red L
1'
Orange/Brown
Yellow micaceous
Scl
Red/Brown
Yellow micaceous
Sl
Yellow/Brown
S
- trace
Rack
11'

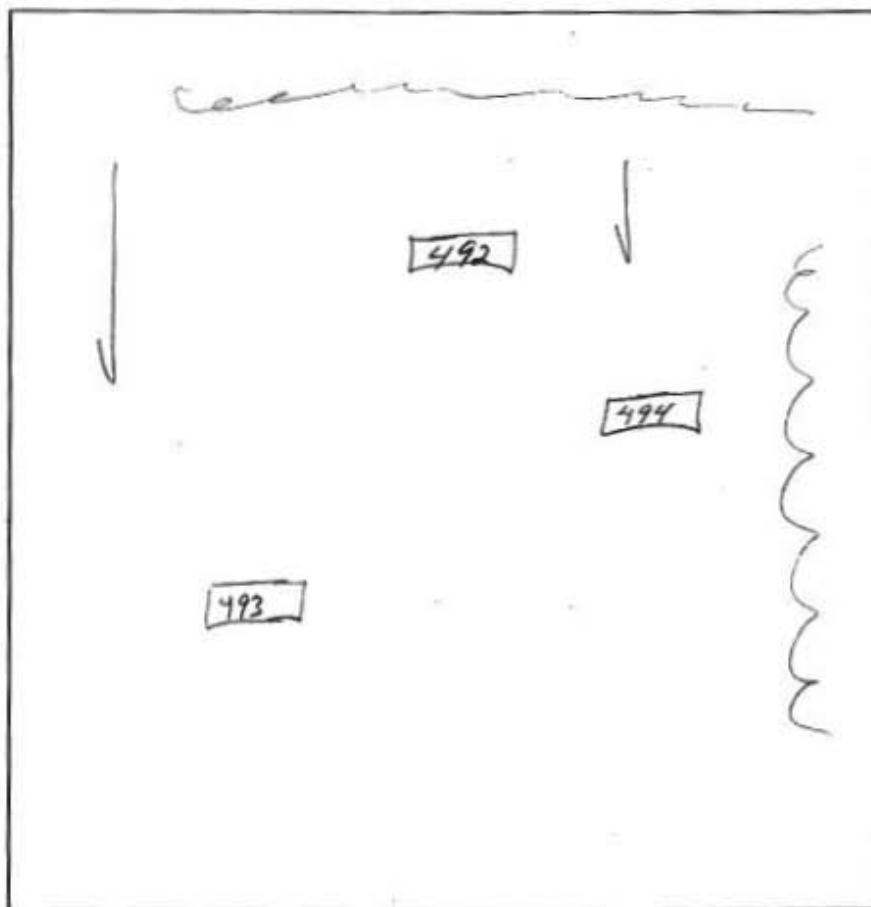

DATE	TEST #	DEPTH	START	BREAK 1" DROP	STOP 2" DROP	TIME OF 2ND INCH	P/F/H
7/15/04	493	4 1/2" / 11'	2:22	2:28	2:38	10 min	P
	492	7'	- Visual - top micaceous Rack				F
	494	5' / 11'	2:34	2:45	3:02	17 min	P

REMARKS check slopeSANITARIAN KJB BACKHOE Trotter OTHERS Zack

TEST HOLES USED IN SDA _____ AVG. PERC TIME _____ SQ. FT/BR _____

TRENCH WIDTH _____ INLET DEPTH _____ MAX. BOT DEPTH _____ EFFECTIVE S/W _____

