



80

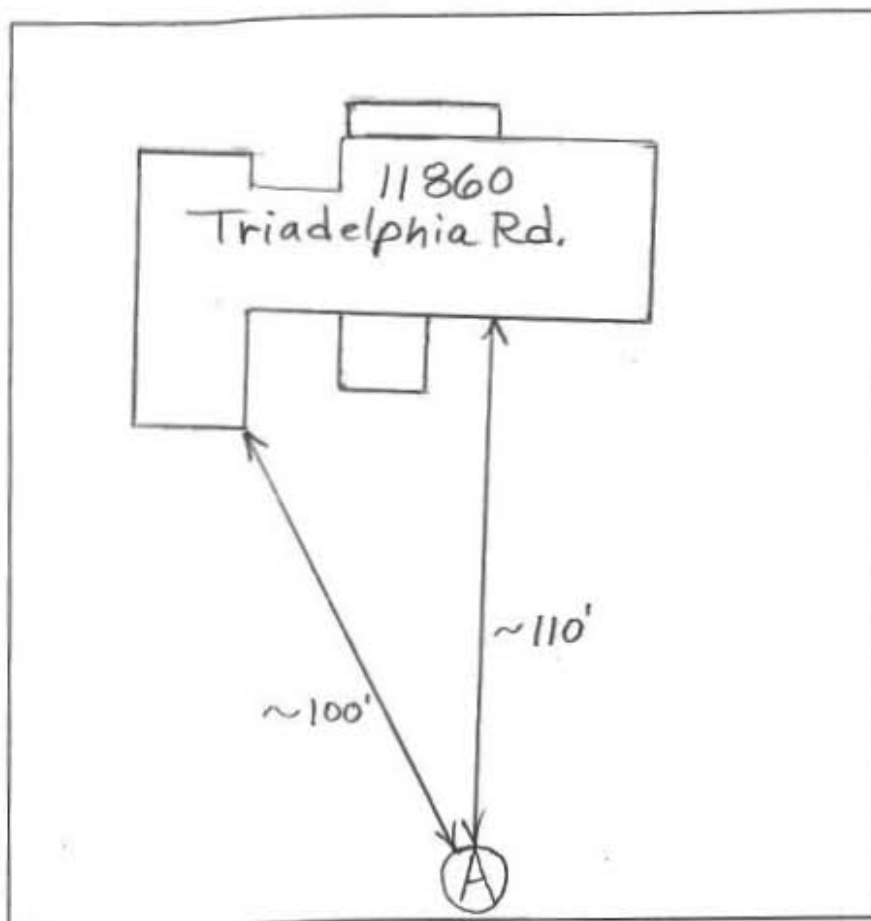
Topsoil

Mixture
of Red Br
Sa Loam,
Sa Cl Loam
+ Br Loamy
Sa

4-4.5'

Med Br
Loamy
sa
Trace
Rock

14.5'

[illegible]

REMARKS Fast Perc Rates

SANITARIAN B. Baker BACKHOE R. Heaps OTHERS _____

TEST HOLES USED IN SOA A AVG. PERC TIME 1 SQ. FT/BR _____

TRENCH WIDTH _____ INLET DEPTH _____ MAX. BOT DEPTH _____ EFFECTIVE S/W _____