



HOWARD COUNTY HEALTH DEPARTMENT

38118

DATE
11/10/12

05

Received
From

Greenfield Homes Trx. PHONE #410-481-6762

☐ CASH
☒ CHECK

NO.


10690

For Septic Permits Blended System - Wilkes
Bridge Lots 1-5One thousand nine hundred = 1900
Eighty Dollars

\$ 1980.00

Received By

NOT TO SCALE

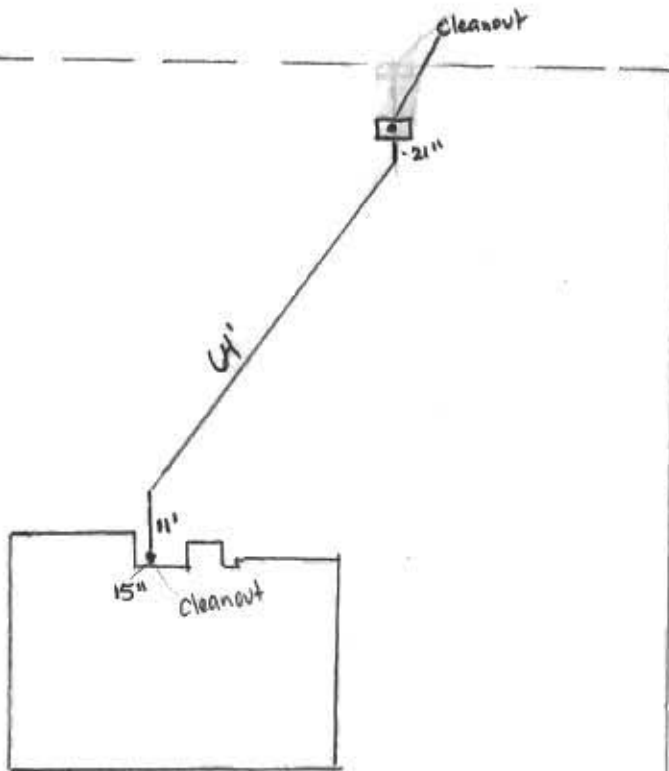

~~ROAD NAME~~

TRENCH/DRAINFIELD DATA

WIDTH	INLET	BOTTOM
_____	_____	_____
NUMBER OF TRENCHES _____		
TOTAL LENGTH _____		
ABSORPTION AREA _____		
DISTRIBUTION BOX LEVEL _____		
DISTRIBUTION BOX BAFFLE _____		
DISTRIBUTION BOX PORT _____		

SEPTIC TANK DATA

SEPTIC TANK I LEVEL _____	
MANUFACTURER _____	
CAPACITY _____	GAL
SEAM LOC _____	
TANK LID DEPTH _____	
BAFFLES _____	
BAFFLE FILTER _____	
MANHOLE LOC _____	
6" PORT LOC _____	
WATERTIGHT TEST _____	
SLOTTED _____	
DATE ON LID _____	

No sewer house connection
 permit on file. Work
 completed by Hatfield's
 Equipment, PO Box 519,
 Annapolis Junction, MD,
 20701, (301) 854-6172.

PRE-CONSTRUCTION:

INSTALLATION: 7/14/14 - STK inspection completed, see As Built above. PVC line bedded
 w/ stone from house connection to concrete y-block w/ clean out near property
 line. Clean out located near (15") from dwelling. (RP)

FINAL INSPECTOR _____ DATE OF APPROVAL _____

MAINTENANCE EASEMENT

NON-BUILDABLE
PRESERVATION
PARCEL 'A'

36.4

POURED CONCRETE
FOUNDATION
TOP OF
WALL=543.30

52.0

N73°22'07"E 193.55
N73°22'07"E 191.99

24' PRIVATE USE-IN-COMMON
ACCESS EASEMENT FOR LOTS
1-5 & NON-BUILDABLE
PRESERVATION PARCEL 'B'

ABLE
/ATION
L 'C'

N25°44'52"E 128.04

30' PUBLIC W.
SEWER & UTIL
EASEMENT

S55°08'44"E 89.95

74.5'

50' BRL

36.4'

51.4'

S64°15'08"E 213.93

SEE DETAIL "A"

10' BRL

103.1'

LOT 1

30' BRL

1" = 30'

S32°25'55"E 141.62

10' BRL

25481
25482
25483
25484
25485

Collins, Sarah


From: Hart, Amy
Sent: Wednesday, March 07, 2018 11:46 AM
To: Collins, Sarah
Subject: U&O Release 11324 Willow Ridge Lane

On the morning of 12-13-13 the Bureau of Utilities observed the gravity sewer house connection to the Willow Ridge Shared Septic System:

Willow Ridge - Contract# 4301
Lot 1
11324 Willow Ridge Lane
Ellicott City, MD 21042

The Bureau of Utilities releases its hold on this property for U&O.

Thank you,
Amy Hart
Bureau of Utilities

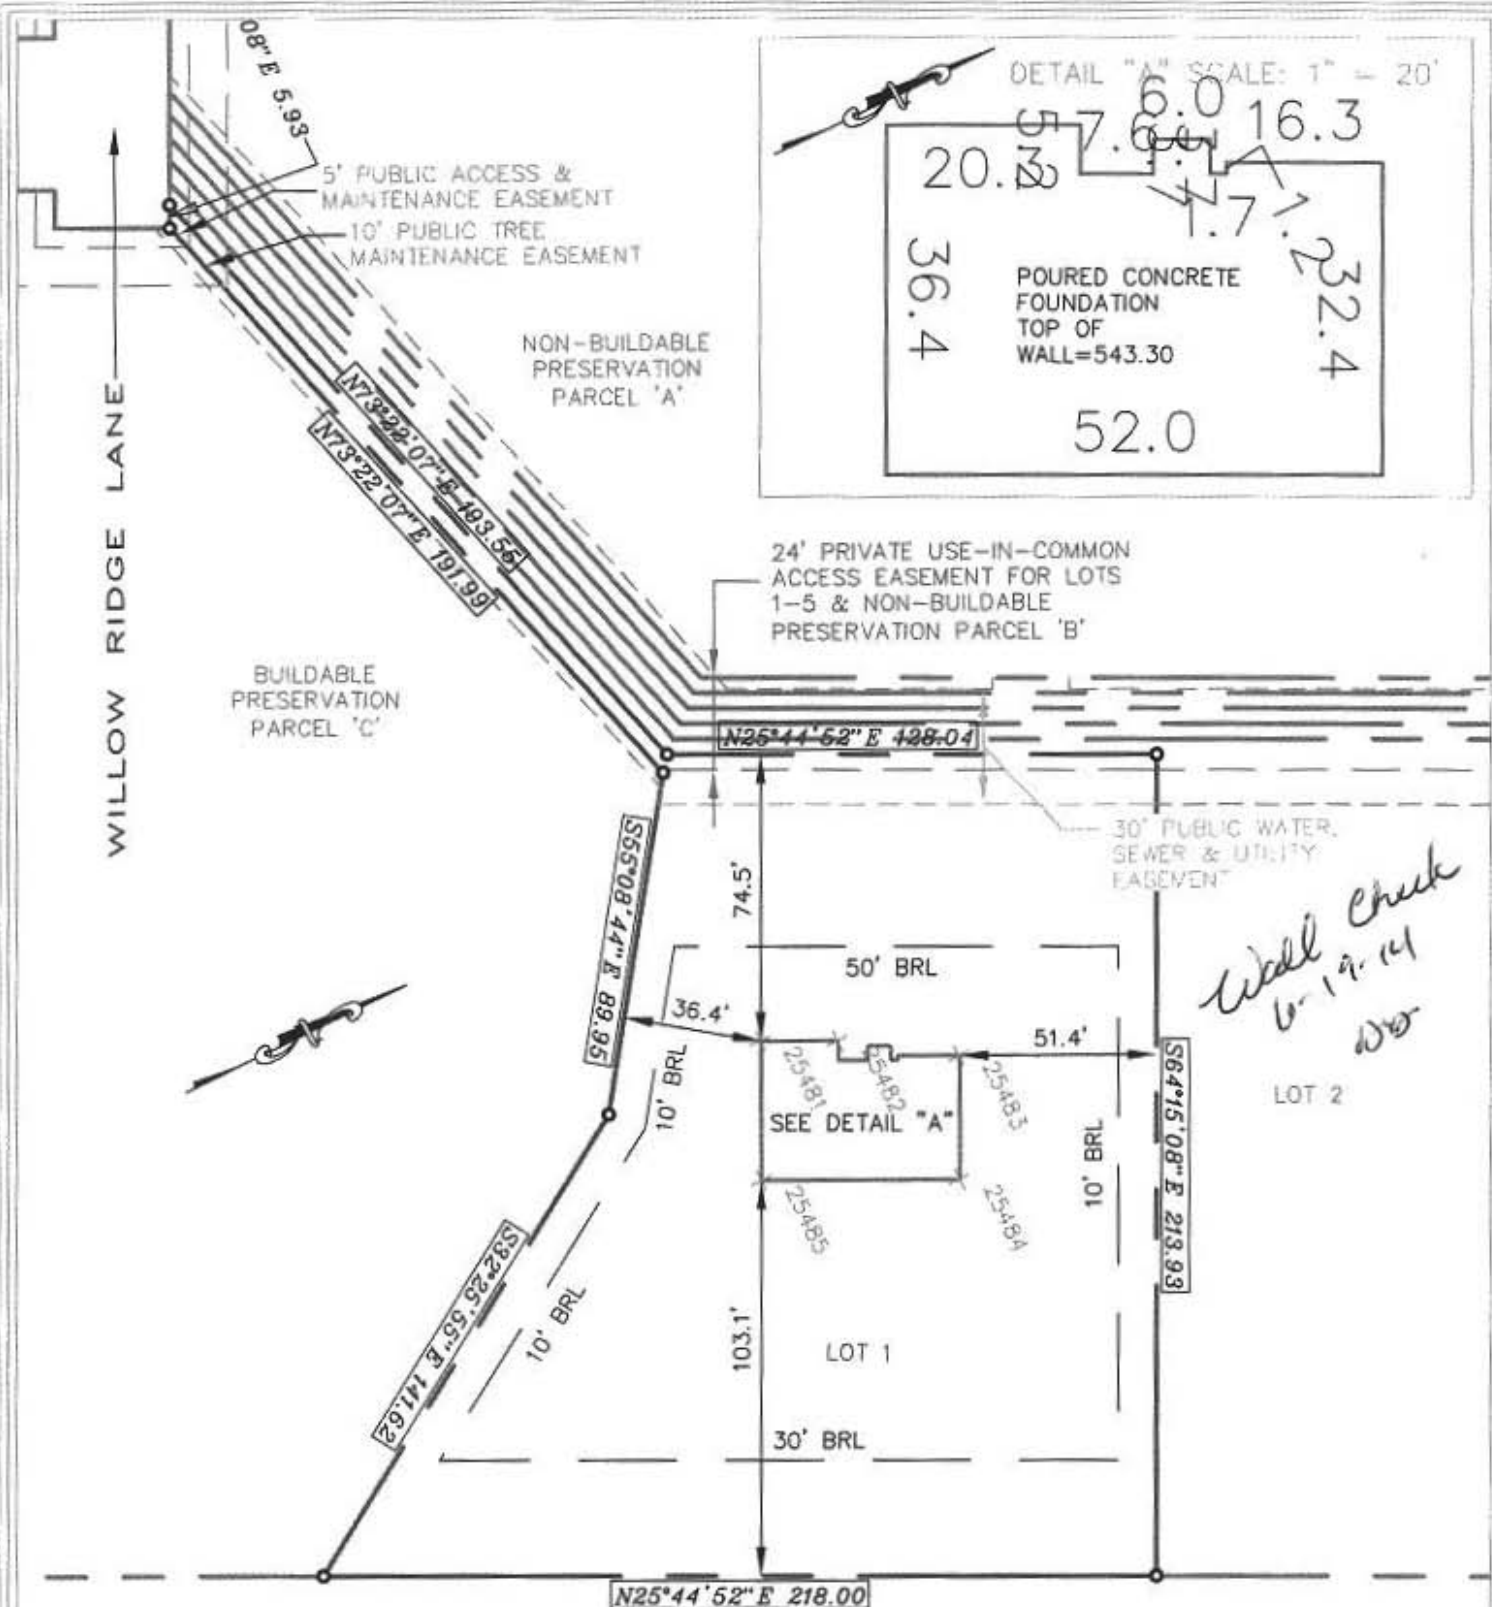

DIMENSIONS FROM FOUNDATION WALL TO PROPERTY LINE ARE +/-0.1'
 ADDRESS No: 11324 Willow Ridge Lane Lot 1 WILLOW RIDGE
 TOP OF WALL ELEV. = 543.30'
 THIS LOCATION DRAWING IS OF BENEFIT TO THE CONSUMER ONLY INsofar AS IT IS
 REQUIRED BY A LENDER OR A TITLE INSURANCE COMPANY OR ITS AGENT IN
 CONNECTION WITH CONTEMPLATED TRANSFER, FINANCING OR REFINANCING
 THIS LOCATION DRAWING IS NOT TO BE RELIED UPON FOR THE ESTABLISHMENT OR
 LOCATION OF FENCES, GARAGES, BUILDINGS, OR OTHER EXISTING OR FUTURE
 IMPROVEMENTS.
 THIS LOCATION DRAWING DOES NOT PROVIDE FOR THE ACCURATE IDENTIFICATION
 OF PROPERTY BOUNDARY LINES, BUT SUCH IDENTIFICATION MAY NOT BE REQUIRED
 FOR THE TRANSFER OF TITLE OR SECURING FINANCING OR REFINANCING.

FSH Associates

Engineers Planners Surveyors
 6339 Howard Lane, Elkridge, MD 21075
 Tel: 410-567-5200 Fax: 410-796-1562
 E-mail: FSHERI.COM

Professional Certification. I hereby certify that these documents were prepared by
 me or under my responsible charge, and that I am a duly licensed property line
 surveyor under the laws of the State of Maryland, License No. 135, Expiration
 Date: April 12, 2014.

WALL CHECK

FOUNDATION	Date: 02/19/14
FINAL	Date:
DRAWN BY:	KJB
SCALE:	1"=50'
W.D. No.:	3807



LOT 1
 WILLOW RIDGE
 #11324 WILLOW RIDGE LANE
 MDR PLAT No. 22032
 TAX MAP 16 GRID 15
 PARCEL NOS. 89, 91, P/O 183 & 201
 3rd ELECTION DISTRICT
 HOWARD COUNTY, MARYLAND