

APPLICATION

SEWAGE DISPOSAL TESTING

MARYLAND STATE DEPARTMENT OF HEALTH

HOWARD COUNTY

ELLICOTT CITY

DISTRICT 4

DATE 8/2/72

A 17294

P

TO: THE COUNTY HEALTH OFFICER
ELLICOTT CITY, MARYLAND

I, HEREBY, APPLY FOR THE NECESSARY TESTS IN ORDER TO CONSTRUCT (OR RECONSTRUCT) A SEWAGE DISPOSAL SYSTEM.

PROPERTY OWNER Harry W. Dove

ADDRESS Rt. #1, Prospect Rd., Mt. Airy, Md. PHONE 829-0214

PROPERTY LOCATION:

SUBDIVISION Nursery View

LOT NO. 2

ROAD AND DESCRIPTION off Watersville Road

OCCUPANT _____ PHONE _____

PERSON TO CONSTRUCT SYSTEM _____

ADDRESS _____ PHONE _____

SIZE OF LOT 5.0 acres

TYPE BLDG. 3 or 4 x bedrooms
NUMBER OF BEDROOMS

IF NOT SINGLE RESIDENCE DESCRIBE _____

SIGNATURE OF APPLICANT /s/ Harry W. Dove

APPROVED BY _____ FOR _____ DATE _____

(KIND OF SYSTEM)

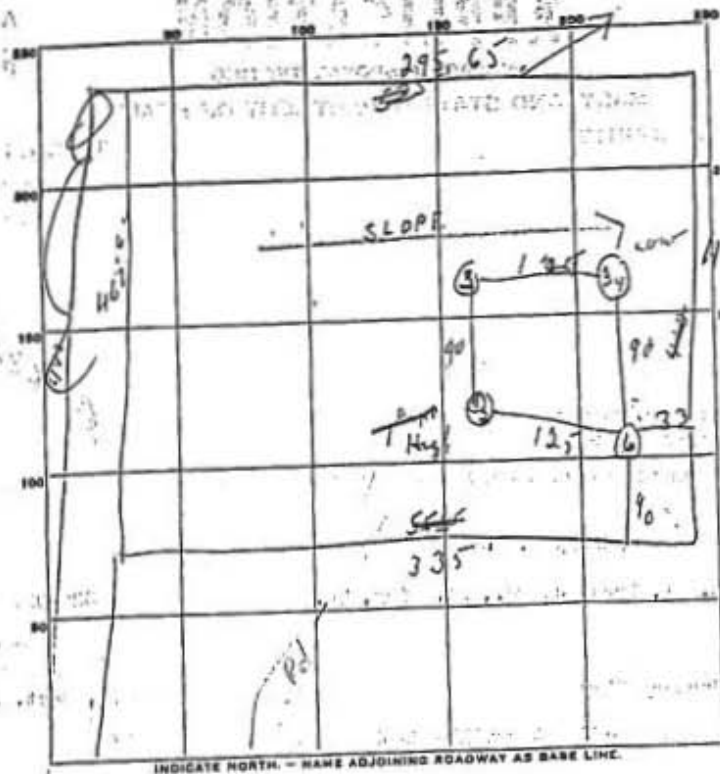
REJECTED BY _____ FOR _____ DATE _____

(KIND OF SYSTEM)

HOLD PENDING FURTHER TESTS _____ DATE _____

REASONS FOR REJECTION OR HOLDING _____

THIS IS NOT A PERMIT

[illegible]

SOIL AUGER FINDING

TESTED BY.

REMARKS