

Tax ID-03-306178

PERMIT

SEWAGE DISPOSAL SYSTEM

MARYLAND STATE DEPARTMENT OF HEALTH

HOWARD COUNTY

BUREAU OF ENVIRONMENTAL HEALTH

461-9933

INDEXED

P 43919

A Repair

2nd

DISTRICT

DATE

4-3-89

DATE SYSTEM APPROVED

4/5/89

INSPECTOR

B. H.

John Goodman IS PERMITTED TO INSTALL ALTER ☒

ADDRESS PHONE 825-2517

SUBDIVISION ROAD 2580 Sand Hill Rd LOT 2

PROPERTY OWNER Richard Weinknecht PHONE: 379-0929 WORK
2580 Sand Hill Road

ADDRESS

IF GARBAGE GRINDER IS USED INCREASE SEPTIC TANK CAPACITY BY 50% AND ABSORPTION AREA BY 22%.

GARBAGE GRINDER? YES NO ☒

SEPTIC TANK CAPACITY 1000 GALLONS NUMBER OF BEDROOMS 3

REPAIR - CALL FOR INSPECTION WHEN GROUND IS OPENED UP SO SANITARIAN CAN RECOMMEND REPAIR.

4/4/89 - REPLACE ROPEVING STEEL TANK
 540 SFE SIDEWALL AREA 10 FT DEEP 7 FT STONE
 INLET 3 FT 2 FT WIDE 7 FT LONG
 RUN TRENCH NEAR POLE HOLE ①

PLANS APPROVED BY C. Williams DATE 3/31/89

COVER NO WORK UNTIL INSPECTED AND APPROVED

NEITHER THE HOWARD COUNTY COUNCIL NOR THE HEALTH DEPARTMENT IS RESPONSIBLE FOR THE SUCCESSFUL OPERATION OF ANY SYSTEM

NOTE: CLEANOUT REQUIRED EVERY 70 FEET OF SEWER LINE AND/OR AT 90° SWEEPS IN LINES FROM HOUSE TO DRAIN FIELDS

NOTE: ALL PARTS OF SEPTIC SYSTEMS (I.E. TANK, DISTRIBUTION BOX, TRENCHES) TO BE 100 FEET FROM WELL (UNLESS OTHERWISE SPECIFICALLY AUTHORIZED)

NOTE: IF DEEP TRENCHES ARE USED CALL FOR INSPECTION BEFORE AND AFTER PLACING GRAVEL IN TRENCHES

NOTE: NO DRY WELL SHALL EXCEED 15 FOOT IN DIAMETER NO ABSORPTION TRENCH TO EXCEED 100 FEET IN LENGTH

NOTE: ALL PIPE FROM HOUSE TO SEPTIC TANK MUST BE CAST IRON OR SCHEDULE 40 PVC OR ABS

PERMIT VOID AFTER TWO YEARS

NOTE: INSTALL STAND PIPE ON SEPTIC TANK AND DRY WELL. STAND PIPES MUST BE 6 INCHES IN DIAMETER. CAST IRON, CONCRETE OR TERRA COTTA OR PVC OR ABS ACCEPTED. IF TOP OF SEPTIC TANK IS DEEPER THAN 3 FEET, MANHOLE TO GRADE REQUIRED

NOTE: DISTRIBUTION BOXES MUST HAVE BAFFLES

*INSTALLER IS RESPONSIBLE FOR OBTAINING FINAL APPROVAL ON THIS PERMIT

*CALL 461-9933 FOR INSPECTION OF SEPTIC SYSTEMS.

P 43919

HOWARD COUNTY HEALTH DEPARTMENT

PERMIT-SEWAGE DISPOSAL SYSTEM

INDEXED

Permit No. A131 P00095

District 5

Date 9-29-58

Donald Morgan

is permitted to

Install ☒

Alter ☐

a sewage disposal system located: Sand Hill Rd. 2,200 ft. on Sand Hill Rd. from
Rt. 40

Property Owner Ernest Snow

Address Ellicott City 3 Paul Snow

Location _____

SPECIFICATIONS:

TILE FIELDS ☒ Length ☐ Width ☐ Depth ☐ Bottom area ☐ 261 sq. ft.

SEEPAGE PITS ☐ Number ☐ Inside Diam. ☐ Depth below inlet ☐

Absorbent area ☐

SEPTIC TANK CAPACITY ☐ 600 gallon

OTHER:

Based on a 10 minute percolation test.

Fee \$1.00


PLANS APPROVED BY: James E. Hennigan, Sanitarian

Fill septic tank and distribution box with water before calling for inspection.

No work is to be covered until inspected and approved.

Neither the Howard County Commissioners nor the Health Department is responsible for the successful operation of any installation.

A131

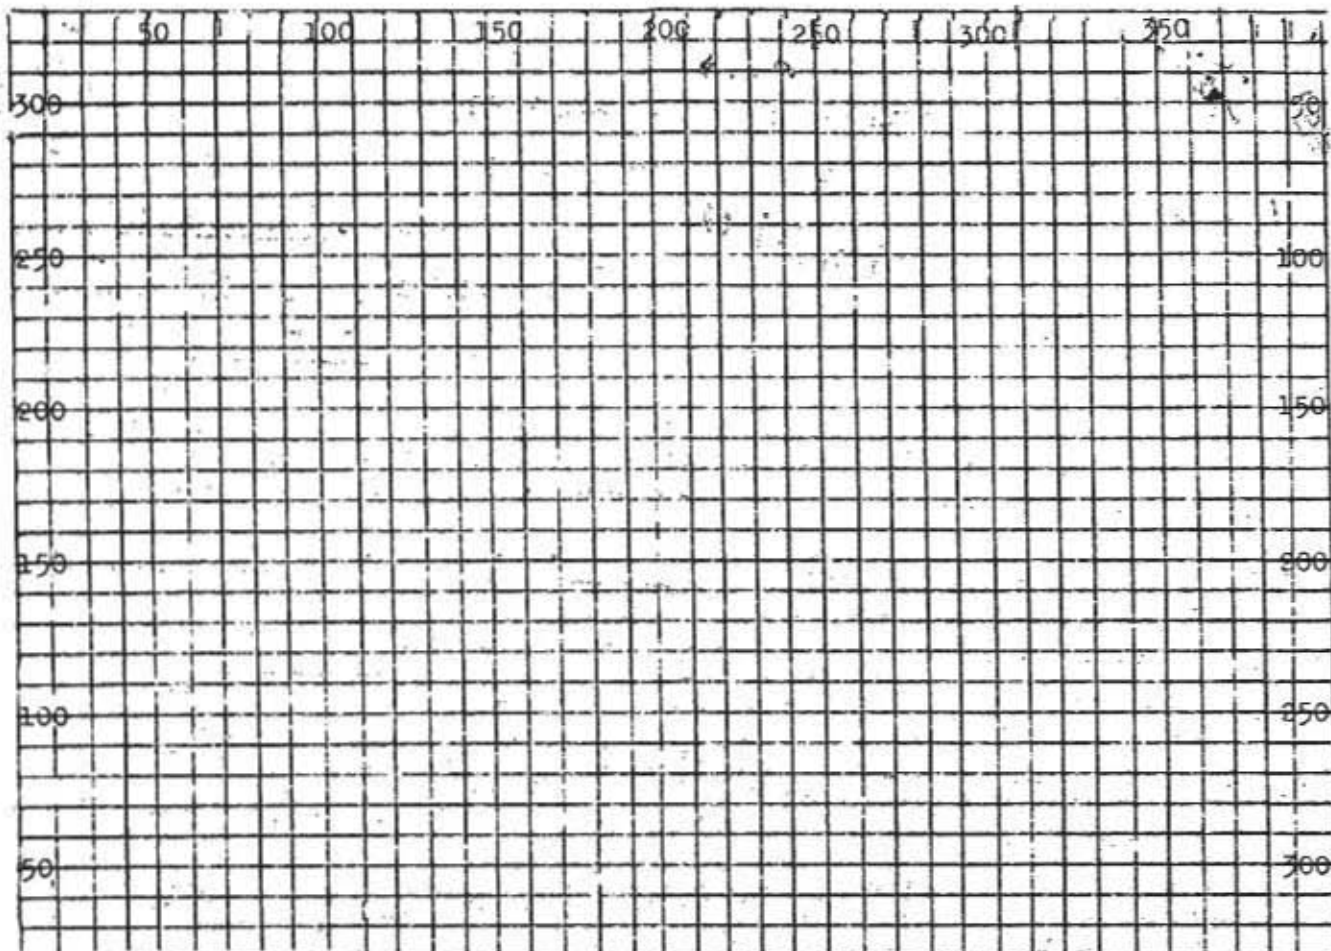

Each square = 10 feet.

Locate system with reference to house and adjoining properties & Perc. Tests.

PERMIT CARD ☐

Septic Tank ☒ Distance from Ground Surface 3 ft. Filled ☐

750 gal. Level ☐ Cleanouts (one)

Distribution Box: Filled ☐ Level ☐

Tile Field:

Depth of Tile ☒ 3 ft. Width of Trenches ☒ 2 ft.
 Grade Board ☒ 1 in x 2 ft Total Length ☒ 150 linear ft.
 Gravel Depth ☐ 18 in under Fall ☒ 2 in in 5 ft.
 No. of Trenches ☒ 3 Backfill on Hand ☒ OK.

Seepage Pit:

Inside Diameter ☐ Depth below inlet ☐

Remarks:

Satisfactory installation at inspection
300 sq. ft. of tile

Date System Approved and
 Ready for Covering

October 3, 1958

Inspector

J. Hennigan

HOWARD COUNTY HEALTH DEPARTMENT

APPLICATION-SEWAGE DISPOSAL TESTING

Application No. A131

District 3

Date 8-26-58

TO: THE COUNTY HEALTH OFFICER
Ellicott City, Maryland

contact either
Mr. Murphy
of Mr. Holbrook

Mr. Snow is out of town while this is being constructed.

I, hereby, apply for the necessary tests in order to construct (or re-construct) a sewage disposal system.

PROPERTY OWNER Snow, Ernest Builder - Norman Holbrook Phone - Frank Murphy Windsor 4-4400

Builder's address: 3509 Chatham Rd. Randallstown
Address %Paul Snow who is in care of L. Manners Phone Globe 526 J 1
Ellicott City

LOCATION OF PROPERTY: Subdivision _____ Lot No. _____

Road Sand Hill Rd. 2200 ft. on Sand Hill Rd. from Rt. 40. Northwest Side of Sand Hill Rd.

OCCUPANT OF PROPERTY Above

Address _____ Phone _____

PERSON TO CONSTRUCT PLANT Parkhill Construction Corp.

Address 4902 Liberty Heights Ave. Balto. 7 Phone Liberty 2-2410

SIZE OF LOT 60 acres

TYPE OF BUILDING TO BE SERVED Residence

SYSTEM TO SERVE 4 PEOPLE NO. OF BEDROOMS 2

PERMIT NUMBER _____ FEE _____

SIGNATURE OF APPLICANT Norman Holbrook


APPROVED BY James E. Hemminger for tele field DATE 8/27/58

REJECTED BY _____ DATE _____

REASONS FOR REJECTION _____

FOR TEST FINDINGS, SEE OTHER SIDE.

4131

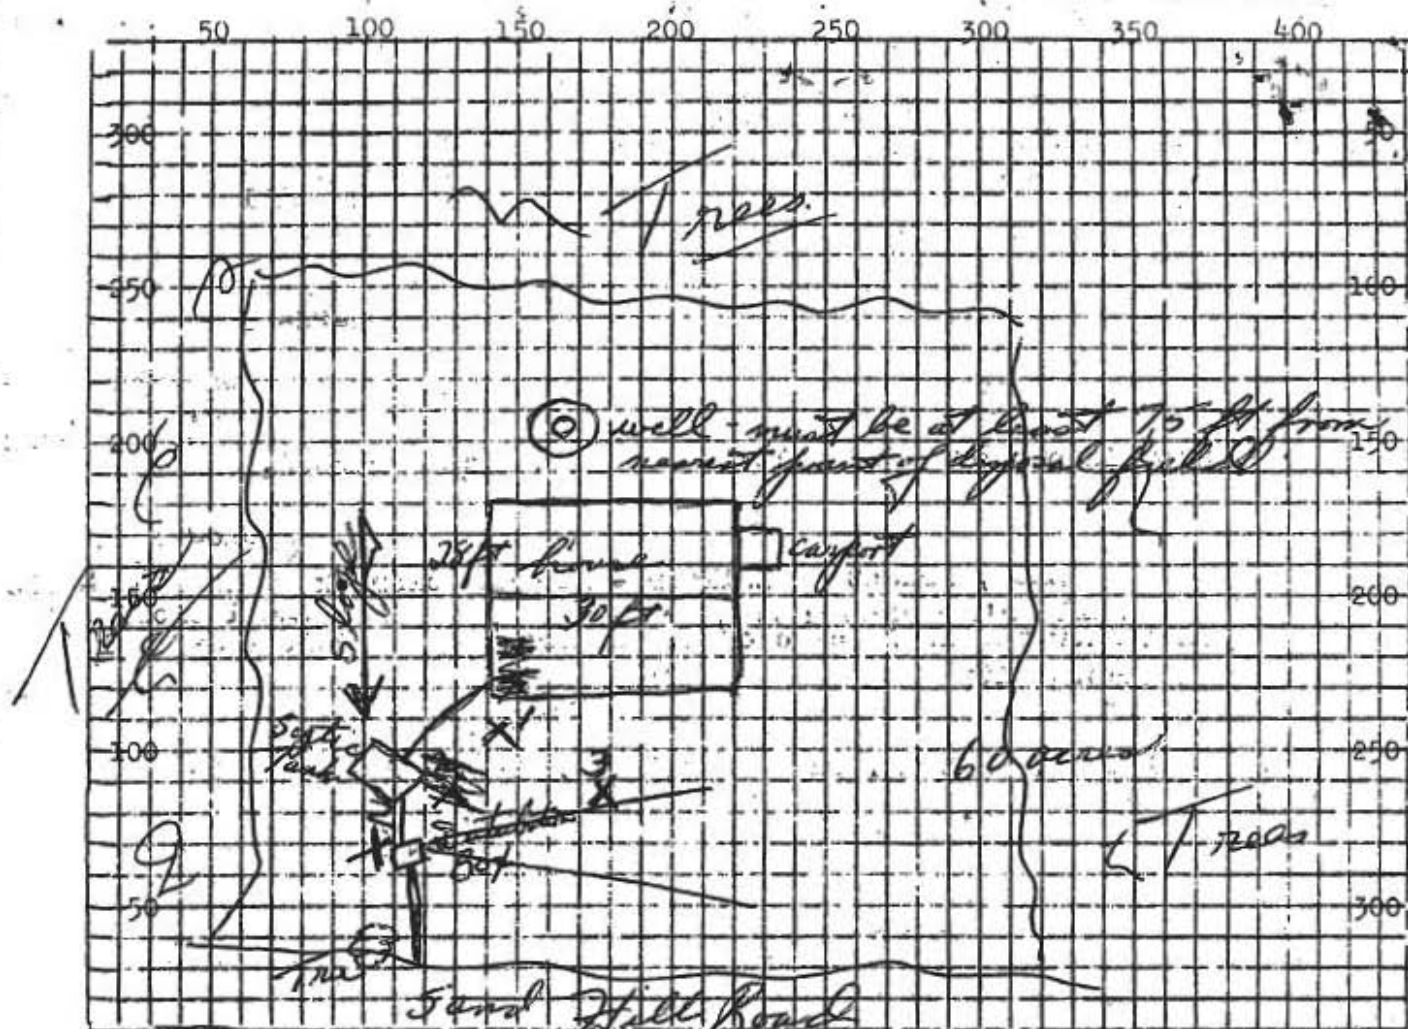

Above: Sketch property showing dimensions, location and numbers of test holes distance to adjoining wells and slope of ground. Each square = 10 ft.

LAST PREVIOUS RAIN _____

RAINFALL FOR YEAR _____

DATE	TEST NO.	TEST DEPTH	PRE-WET 6"		START	STOP	TIME START	TIME STOP	TOTAL TIME
8/27/58	1	3 ft	1:28	1:31	1:31	1:35			4 Minutes
8/27/58	2	3 ft	1:45	1:47	1:47	1:52			5 Minutes
8/27/58	3	3 ft	1:49	1:50	1:50	1:53			3 Minutes
									3 1/2
									4 Minutes
									aver Time

SOIL AUGER FINDING: _____

TEST CONDUCTED BY _____


DATE _____

ALSO, PRESENT _____

SIGNATURE _____

REMARKS: _____

TITLE _____

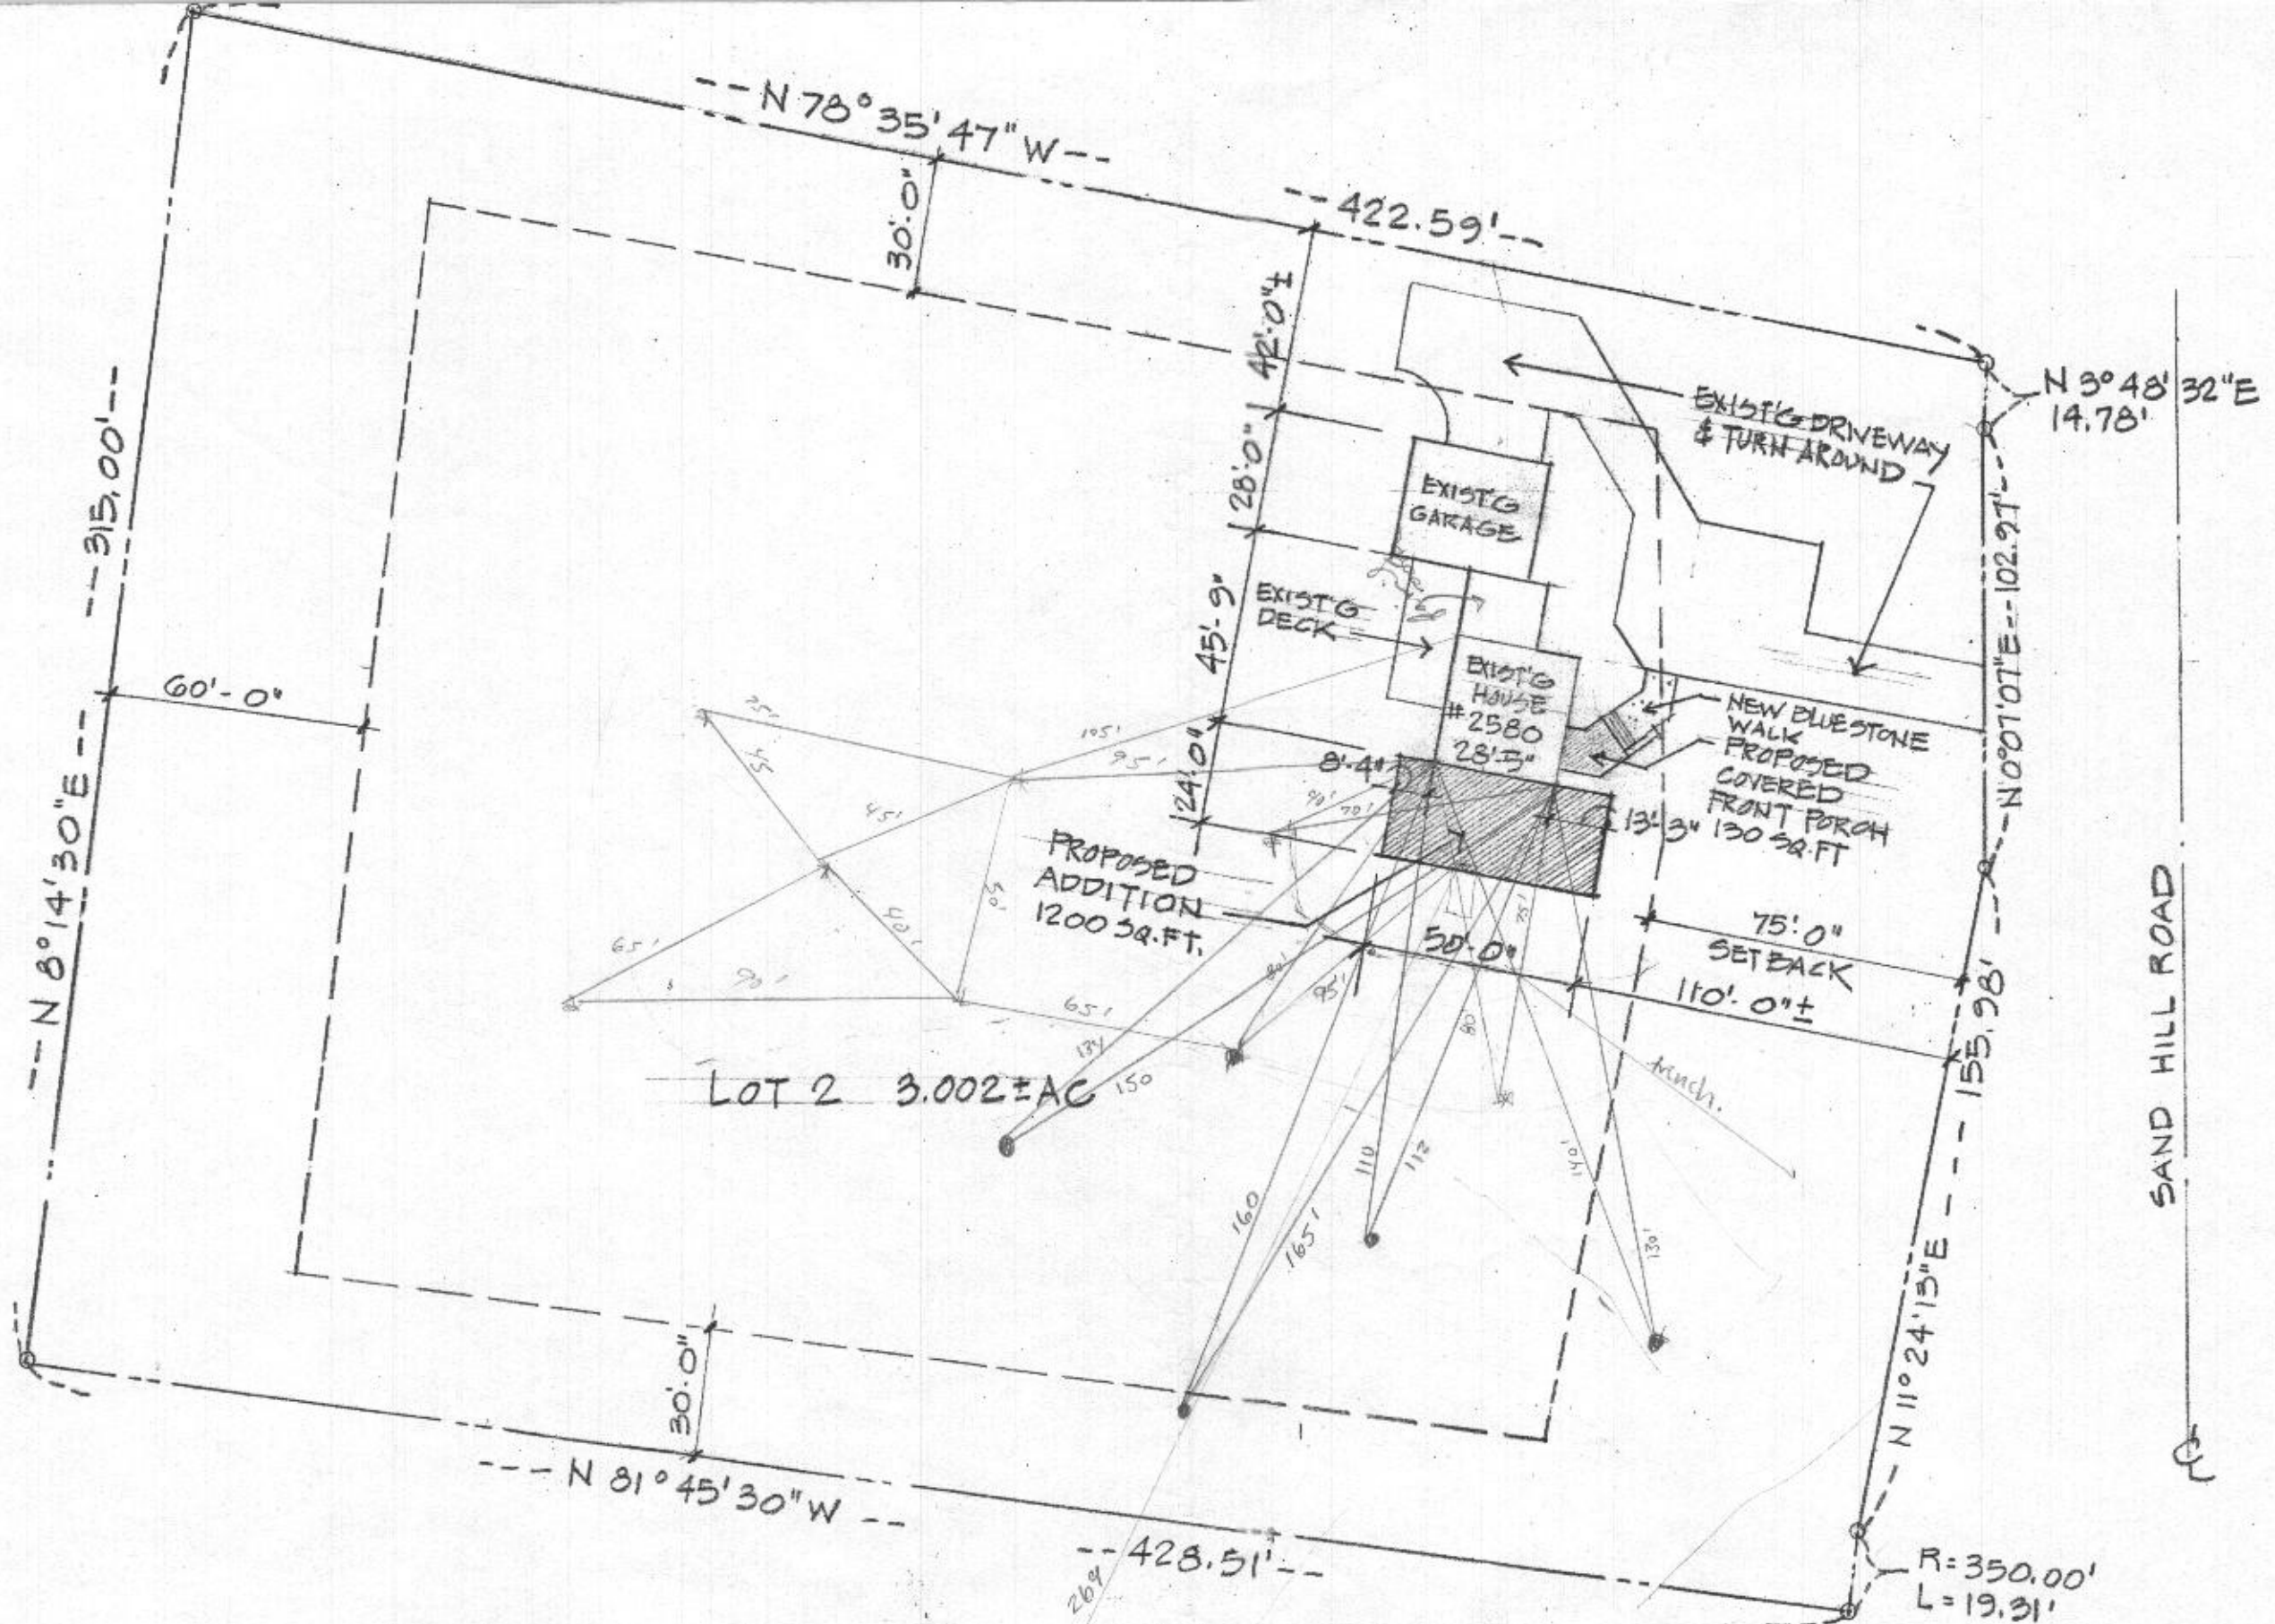

PLOT PLAN SCALE 1"=40'-0"

WEINKNECHT RESIDENCE
2580 SAND HILL ROAD
ELLICOTT CITY, MARYLAND 21042

AUG 14 2007