

APPLICATION

FOR PERCOLATION TESTING AND SITE EVALUATION

TEST DATE(S) _____ TEST TIME _____ (AP) 5 31920

AGENCY REVIEW: _____ DATE 9/16/09

DO NOT WRITE ABOVE THIS LINE

I HEREBY APPLY FOR THE NECESSARY TESTING/EVALUATION PRIOR TO ISSUANCE OF SEWAGE DISPOSAL SYSTEM PERMIT(S) TO:

CHECK AS NEEDED:

- ☐ CONSTRUCT NEW SEPTIC SYSTEM(S)
☒ REPAIR/ADD TO AN EXISTING SEPTIC SYSTEM
☐ REPLACE AN EXISTING SEPTIC SYSTEM

CHECK AS NEEDED:

- ☐ NEW STRUCTURE(S)
☐ ADDITION TO AN EXISTING STRUCTURE
☐ REPLACE AN EXISTING STRUCTURE

CHECK ONE:

- ☐ CREATE NEW LOT(S)
☐ BUILD ON AN EXISTING LOT IN A SUBDIVISION
☐ BUILD ON AN EXISTING PARCEL OF RECORD

IS THE PROPERTY WITHIN 2500' OF ANY RESERVOIR?

- ☐ YES
☐ NO

THE TYPE OF STRUCTURE IS:

- ☒ RESIDENTIAL WITH _____ PROPOSED BEDROOMS IN THE COMPLETED STRUCTURE (NOTE **UNKNOWN** IF APPROPRIATE)
☐ COMMERCIAL (PROVIDE DETAIL OF NUMBERS AND TYPES OF EMPLOYEES/ CUSTOMERS ON ACCOMPANYING PLAN)
☐ INSTITUTIONAL/GOVERNMENT (PROVIDE DETAIL OF NUMBERS AND TYPES OF EMPLOYEES/USERS ON ACCOMPANYING PLAN)

PROPERTY OWNER(S) Chris Hayes

DAYTIME PHONE _____ CELL _____ FAX _____

MAILING ADDRESS 2555 Sand Hill Road Elkott City MO 21042
STREET CITY/TOWN STATE ZIP

APPLICANT Freedom Septic Service Inc

DAYTIME PHONE 410 795-2947 CELL _____ FAX _____

MAILING ADDRESS 2809 Liberty Road Sylversville MD 21784
STREET CITY/TOWN STATE ZIP

APPLICANT'S ROLE: DEVELOPER BUILDER BUYER RELATIVE/FRIEND REALTOR CONSULTANT

PROPERTY LOCATION
SUBDIVISION/PROPERTY NAME _____ LOT NO. _____

PROPERTY ADDRESS 2555 Sand Hill Road
STREET TOWN/POST OFFICE

TAX MAP PAGE(S) _____ GRID _____ PARCEL(S) _____ PROPOSED LOT SIZE _____


AS APPLICANT, I UNDERSTAND THE FOLLOWING: THE SYSTEM INSTALLED SUBSEQUENT TO THIS APPLICATION IS ACCEPTABLE ONLY UNTIL PUBLIC SEWERAGE IS AVAILABLE. THIS APPLICATION IS COMPLETE WHEN ALL APPLICABLE FEES AND A SUITABLE SITE PLAN HAVE BEEN RECEIVED. I ACCEPT THE RESPONSIBILITY FOR COMPLIANCE WITH ALL M.O.S.H.A. AND MISS UTILITY* REQUIREMENTS. APPROVAL IS BASED UPON SATISFACTORY REVIEW OF A PERC CERTIFICATION PLAN.

TEST RESULTS WILL BE MAILED TO APPLICANT.

Bruce / (VF)
SIGNATURE OF APPLICANT

HOWARD COUNTY HEALTH DEPARTMENT, BUREAU OF ENVIRONMENTAL HEALTH, WELL AND SEPTIC PROGRAM
7178 COLUMBIA GATEWAY DRIVE COLUMBIA, MARYLAND 21046 (410) 313-1771 FAX (410) 313-2648
TDD (410) 313-2323 TOLL FREE 1-877-4MD-DHMH

Public H₂O

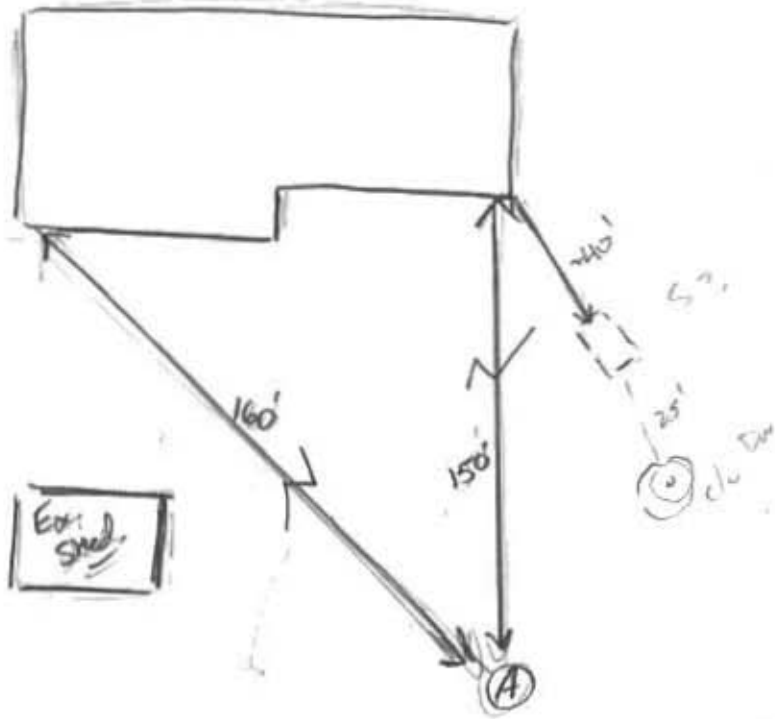

B" (A)
 Top Soil
 Silt. m. r. roots
 10 YR 4/4, SCL
 MSBK,
 very friable,
 20% schist chnrs
 10 YR 4H SL
 Friable,
 platy structure
 from bedding
 Plures, roots
 5-10% schist
 angular schist chnrs
 ↓
 cherty SL
 getting harder.
 large size
 11.5' mica schist

| DATE | TEST # | DEPTH | START | BREAK 1" DROP | STOP 2" DROP | TIME OF 2ND INCH | P/F/H |
|---------|--------|----------|-------|------------------|-----------------|---------------------|-------|
| 9/29/09 | (A) | 4' 11.5" | 11:45 | 11:47 | 11:50 | 3 | P |
| | | | | | | | |
| | | | | | | | |
* Paved H₂O bottom hole (A) ~ 10 min.
 REMARKS 3BR, near soil 1 sec
 SANITARIAN K. Wolf BACKHOE Jante OTHERS _____
 TEST HOLES USED IN SDA 1 AVG. PERC TIME 3 SQ. FT/BR _____
 TRENCH WIDTH 2' INLET DEPTH 2' MAX. BOT DEPTH 6' EFFECTIVE SW 4'

$$\frac{450}{1.2} = 375 \div 2' = 187.5 = 107.5 \text{ LF}$$

-78°55'45"

39°18'3."



39°18'3."



Disclaimer: Howard County, Maryland assumes no responsibility for the accuracy of this report or the information contained herein or derived therefrom. The user assumes all risks and liabilities whatsoever resulting from or arising out of the use of this information. There are no oral agreements or warranties relating to the use of this report.

-78°55'45"

150455

Howard County

M A R Y L A N D

By:
Office:
Map Width: 910.00 ft.
Print Date: 8/29/2009
Scale: 1 in. = 100 ft.