

C1 1158

SEQUENCE NO.
(MDE USE ONLY)STATE OF MARYLAND
WELL COMPLETION REPORT
FILL IN THIS FORM COMPLETELY
PLEASE TYPETHIS REPORT MUST BE SUBMITTED WITHIN
45 DAYS AFTER WELL IS COMPLETED.COUNTY
NUMBER

P 511573

1 2 3 6
(THIS NUMBER IS TO BE PUNCHED
IN COLS. 3-6 ON ALL CARDS)ST/CO USE ONLY
DATE Received

DATE WELL COMPLETED

Depth of Well

PERMIT NO.
FROM "PERMIT TO DRILL WELL"

MM DO YY

MM DO YY

22 400' 26
(TO NEAREST FOOT)5/18/05
OK BB28 29 30 31 32 33 34 35 36 37
Ho 94-4161

OWNER

STREET OR RFD

SUBDIVISION

SECTION

LOT

WELL LOG

Not required for driven wells

STATE THE KIND OF FORMATIONS PENETRATED, THEIR
COLOR, DEPTH, THICKNESS AND IF WATER BEARINGDESCRIPTION (Use
additional sheets if needed)

FEET

check
if water
bearing

FROM TO

Brown Shale 0 37

Blue Rock 37 400

GROUTING RECORD

WELL HAS BEEN GROUTED
(Circle Appropriate Box)yes no
Y N
44 44

TYPE OF GROUTING MATERIAL (Circle one)

CEMENT CM BENTONITE CLAY BC

NO. OF BAGS 11 NO. OF POUNDS 4034

GALLONS OF WATER 66

DEPTH OF GROUT SEAL (to nearest foot)

from 48 TOP 0 ft. to 54 BOTTOM 38 ft.
(enter 0 if from surface)

CASING RECORD

casing
types
insert
appropriate
code
below

ST

CO

STEEL

CONCRETE

PL

OT

PLASTIC

OTHER

MAIN
CASING
TYPENominal diameter
top (main) casing
(nearest inch)Total depth
of main casing
(nearest foot)

PL

6

41

60 61

63 64

66 67

OTHER CASING (if used)

diameter depth (feet)

inch from to

E
A
C
H
C
A
S
I
N
G

SCREEN RECORD

screen type
or open hole(insert
appropriate
code
below)

ST

BR

HO

STEEL

BRASS

OPEN

BRONZE

HOLE

PL

OT

PLASTIC

OTHER

NUMBER OF UNSUCCESSFUL WELLS: 0

WELL HYDROFRACTURED

yes

no

Y

N

CIRCLE APPROPRIATE LETTER

A A WELL WAS ABANDONED AND SEALED
WHEN THIS WELL WAS COMPLETED

E ELECTRIC LOG OBTAINED

P TEST WELL CONVERTED TO PRODUCTION
WELLI HEREBY CERTIFY THAT THIS WELL HAS BEEN CONSTRUCTED IN
ACCORDANCE WITH COMAR 26.04.04 "WELL CONSTRUCTION" AND
IN CONFORMANCE WITH ALL CONDITIONS STATED IN THE ABOVE
CAPTIONED PERMIT, AND THAT THE INFORMATION PRESENTED
HEREIN IS ACCURATE AND COMPLETE TO THE BEST OF MY
KNOWLEDGE.

DRILLERS LIC. NO.: M 5 D 0 2 4

DRILLERS SIGNATURE
(MUST MATCH SIGNATURE ON APPLICATION)

LIC. NO.: D

SITE SUPERVISOR (sign. of driller or journeyman
responsible for sitework if different from permittee)

C 2 DEPTH (nearest ft.)

1 2 3 100

1 2 3 100

C 3

PUMPING TEST

HOURS PUMPED (nearest hour)

6

PUMPING RATE (gal. per min.)

1.2

METHOD USED TO

MEASURE PUMPING RATE Bucket

WATER LEVEL (distance from land surface)

BEFORE PUMPING

32 ft.

WHEN PUMPING

320 ft.

TYPE OF PUMP USED (for test)

A air

P piston

T turbine

C centrifugal

R rotary

O other (describe below)

J jet

S submersible

PUMP INSTALLED

DRILLER INSTALLED PUMP
(CIRCLE) (YES OR NO)

YES NO

IF DRILLER INSTALLS PUMP, THIS SECTION
MUST BE COMPLETED FOR ALL WELLS.TYPE OF PUMP INSTALLED
PLACE (A,C,J,P,R,S,T,O)
IN BOX 29.CAPACITY:
GALLONS PER MINUTE
(to nearest gallon)

31 35

PUMP HORSE POWER

37 41

PUMP COLUMN LENGTH
(nearest ft.)

43 47


CASING HEIGHT (circle appropriate box
and enter casing height)

+ above</

SITE INSPECTION SHEET

OWNER: Robert Goff PHONE #: _____
ADDRESS: 1348 St Michaels Road CONTRACTOR: J Mayne
WELL TAG #: _____
SUBDIVISION: _____ LOT: _____ COUNTY #: _____
PROPOSAL: _____

LOCATION DIAGRAM

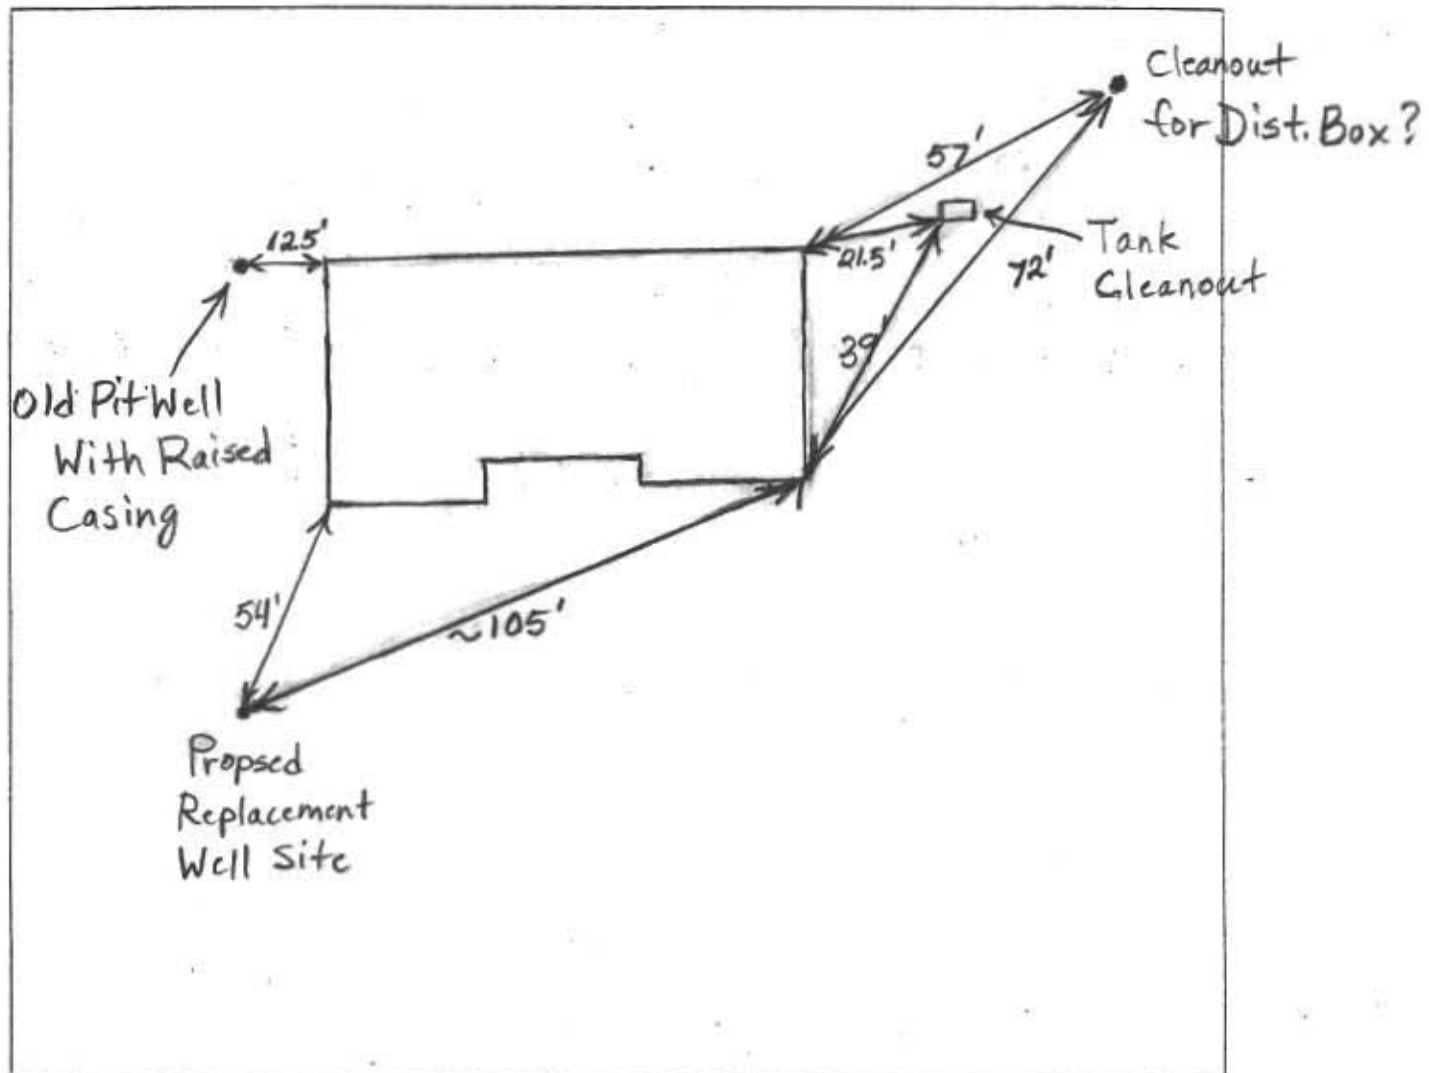

COMMENTS: 4/13/05 Limited Yield on Existing Well. Wish to
drill a new well and disionnect old well from house.
Old well supposed to be used for hose bib. (BB)

DATE: _____ INSPECTOR: _____