

APPLICATION

SEWAGE DISPOSAL TESTING

MARYLAND STATE DEPARTMENT OF HEALTH

A 17479

P

HOWARD COUNTY 3 bedrooms

4 bedrooms

ELLICOTT CITY

10/2/72

1000 gal STank

1250 gal STank

DISTRICT

4th

DATE 9-22-72

Dry Well - to have 17559 ft absorbent sidewall area per bedroom below inlet. Inlet to be 6' below original grade + maximum depth 12' below original grade. Location 85' in front of row of cedar trees and 98' to right of fence + 525 ft in from front property line as seen when facing lot from St Michael's Road - Note - all pipe from house to septic tank to be cast iron

I. HEREBY, APPLY FOR THE NECESSARY TESTS IN ORDER TO CONSTRUCT (OR RECONSTRUCT) A SEWAGE DISPOSAL SYSTEM.

PROPERTY OWNER Albert V. Schulze

ADDRESS 1685 St. Michael's Rd., Woodbine, Md. 21797 PHONE 489-4422

PROPERTY LOCATION:

SUBDIVISION LOT NO.

ROAD AND DESCRIPTION St. Michael's Road - Come Route 144 to St. Michael's, turn left, 1 1/2 miles in on left hand side.

OCCUPANT PHONE

PERSON TO CONSTRUCT SYSTEM

ADDRESS PHONE

SIZE OF LOT 79 acres (Use house as landmark) TYPE BLDG. Farm Trailer

NUMBER OF BEDROOMS

IF NOT SINGLE RESIDENCE DESCRIBE

SIGNATURE OF APPLICANT

APPROVED BY

FOR

(KIND OF SYSTEM)

DATE

REJECTED BY

FOR

(KIND OF SYSTEM)


DATE

HOLD PENDING FURTHER TESTS

DATE

REASONS FOR REJECTION OR HOLDING

THIS IS NOT A PERMIT

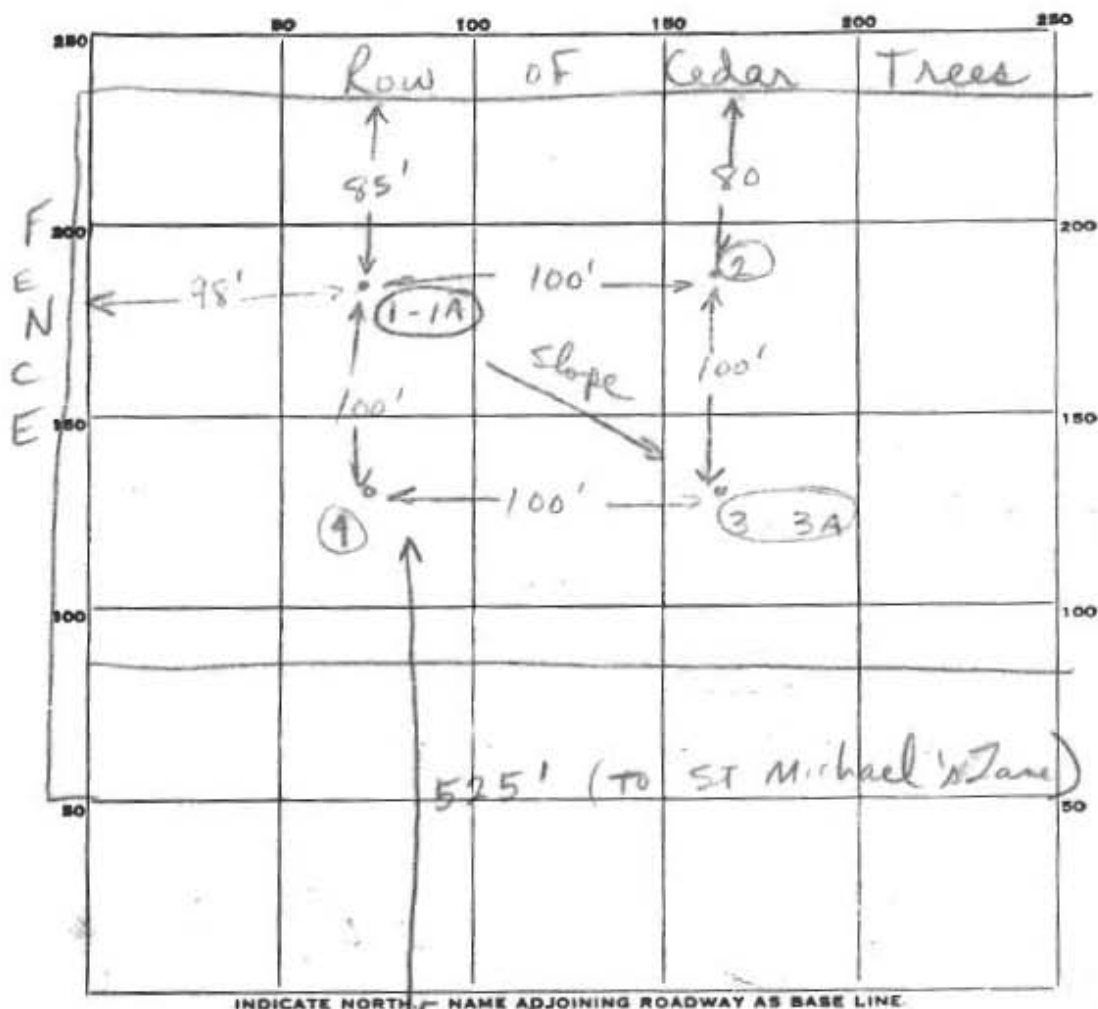

DATE	TEST NO.	DEPTH	PRE-WET		TEST - 1" DROP		TIME
			START	STOP	START	STOP	
9/29	1	6'	10:00	10:10	10:10	10:20	10 min
	1A	12'	10:00	10:10	10:10	10:20	10 min
	2	6' 12' deep [6' (top clay) Bottom 6' Good Soil - Dry]					
	3	6'	10:20	10:30	10:30	10:55	25 min
	3A	13'	10:20	10:30	10:30	10:58	28 min 18 min
	4	top 6' - clay Bottom 6' Good Soil) Dry					air T.M.

SOIL AUGER FINDING

TESTED BY

REMARKS

Dry Well at 1-1A
Inlet 6'
Max Depth 12'

APPLICATION

SEWAGE DISPOSAL TESTING

MARYLAND STATE DEPARTMENT OF HEALTH

HOWARD COUNTY

ELLICOTT CITY

DISTRICT 4th

DATE 9-22-72

TO: THE COUNTY HEALTH OFFICER
ELLICOTT CITY, MARYLAND

I, HEREBY, APPLY FOR THE NECESSARY TESTS IN ORDER TO CONSTRUCT (OR RECONSTRUCT) A SEWAGE DISPOSAL SYSTEM.

PROPERTY OWNER Albert V. Schulze

ADDRESS 1685 St. Michael's Rd., Woodbine, Md. 21797 PHONE 489-4422

PROPERTY LOCATION:

SUBDIVISION _____ LOT NO. _____

ROAD AND DESCRIPTION St. Michael's Road - Come Route 144 to St. Michael's, turn left, 1½ miles in on left hand side.

OCCUPANT _____ PHONE _____

PERSON TO CONSTRUCT SYSTEM _____

ADDRESS _____ PHONE _____

SIZE OF LOT 79 acres (Use house as landmark) TYPE BLDG. Farm Trailer

NUMBER OF BEDROOMS _____

IF NOT SINGLE RESIDENCE DESCRIBE _____

SIGNATURE OF APPLICANT Albert V. Schulze

APPROVED BY H. Snyder

FOR

(KIND OF SYSTEM) dry well

DATE 10/2/72

REJECTED BY _____

FOR

(KIND OF SYSTEM)

DATE _____


HOLD PENDING FURTHER TESTS _____

DATE _____

REASONS FOR REJECTION OR HOLDING _____

THIS IS NOT A PERMIT

175
3
525

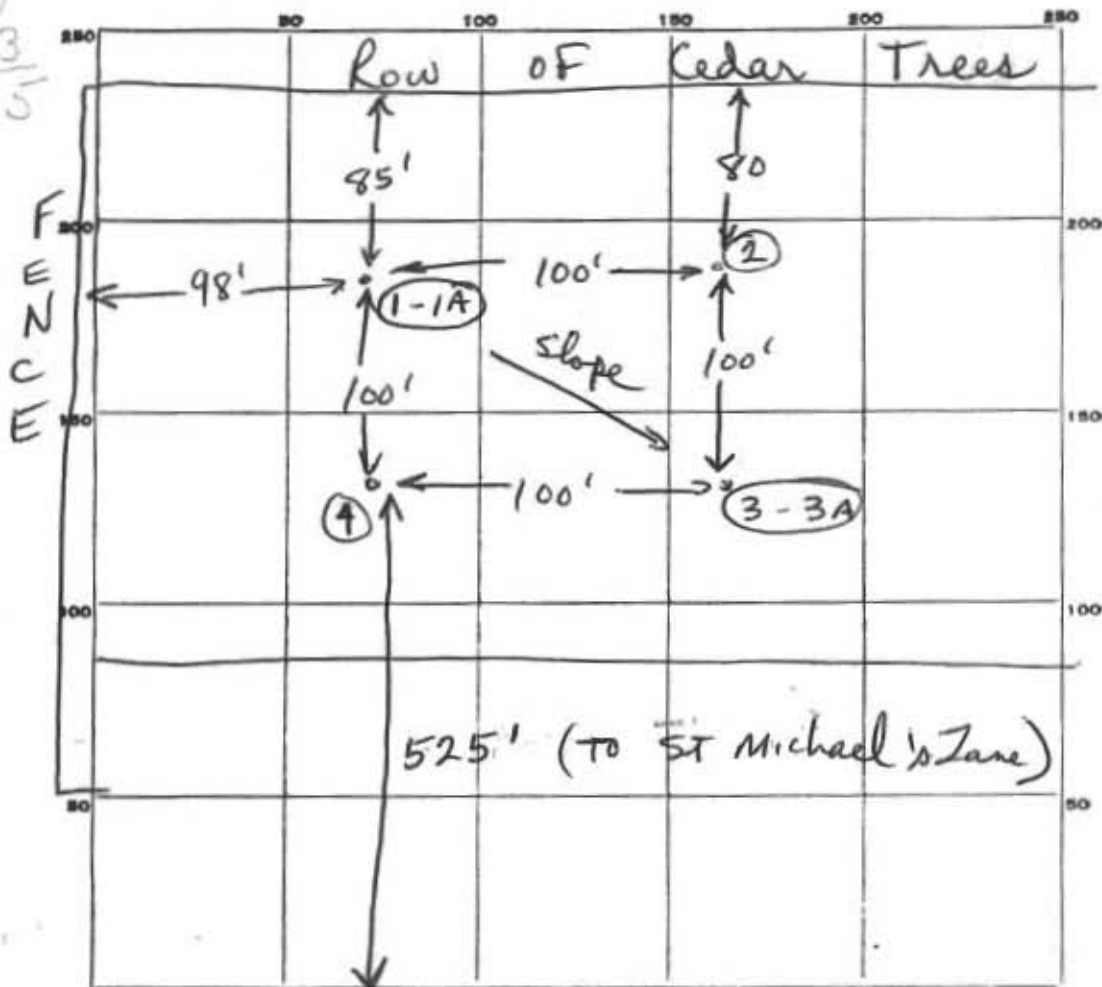

INDICATE NORTH. - NAME ADJOINING ROADWAY AS BASE LINE.

ST Michael's Lane

DATE	TEST NO.	DEPTH	PRE-WET		TEST - 1" DROP		TIME
			START	STOP	START	STOP	
9/29	1	6'	10:00	10:10	10:10	10:20	10 min
	1A	12'	10:00	10:10	10:10	10:20	10 min
	2	6' 12' deep [6' (top) clay]					Bottom 6' Good Soil - Dry
	3	6'	10:20	10:30	10:30	10:55	25 min
	3A	13'	10:20	10:30	10:30	10:58	28 min
	4	top 6' - clay Bottom 6' - Good Soil					Dry

18 min
ar Time

SOIL AUGER FINDING

TESTED BY

REMARKS

H28

Dry Well at 1-1A
Inlet 6'
Max Depth 12'