

PERMIT

SEWAGE DISPOSAL SYSTEM

MARYLAND STATE DEPARTMENT OF HEALTH

HOWARD COUNTY

ELLICOTT CITY

INDEXED

DISTRICT 4th

DATE 10/2/72

Herman Sirk

IS PERMITTED TO INSTALL X ALTER

ADDRESS Florence Road, Woodbine, Maryland

PHONE 489-4724

A SEWAGE DISPOSAL SYSTEM LOCATED AT

SUBDIVISION

1685-A
ROAD St. Michael's Road

LOT

PROPERTY OWNER Albert V. Schulze

trailer

ADDRESS 1685 St. Michael's Road, Woodbine, Md. 21797

SPECIFICATIONS 3 bedrooms

DRAIN FIELD DEPTH FEET, BOTTOM AREA SQ. FT.

SEEPAGE PITS ABSORBENT SIDE-WALL AREA SQ. FT.

SEPTIC TANK CAPACITY 1000 GALLONS

FOR GARBAGE GRINDER, INCREASE DISPOSAL AREA 22% & TANK CAPACITY 50%.

OTHER DRY WELL - To have 175 sq. ft. absorbent sidewall area per bedroom below inlet. Inlet to be 6 ft. below original grade and maximum depth 12 ft. below original grade. Location 85 ft. in front of row of cedar trees and 98 ft. to right of fence and 525 ft. in from front property line as seen when facing lot from St. Michael's Road. System must be installed and ~~xxxx~~ approved before building permit is signed.

NOTE: ALL PIPE FROM HOUSE TO SEPTIC TANK MUST BE CAST IRON.
PERMIT VOID AFTER THREE YEARS.

NOTE: INSTALL STAND PIPE ON SEPTIC TANK AND DRY WELL.

PLANS APPROVED BY Howard L. Snyder

DATE 9/29/72 72

FILL SEPTIC TANK AND DISTRIBUTION BOX WITH WATER BEFORE CALLING FOR AN INSPECTION. COVER NO WORK UNTIL INSPECTED AND APPROVED.


NEITHER THE HOWARD COUNTY COMMISSIONERS NOR THE HEALTH DEPARTMENT IS RESPONSIBLE FOR THE SUCCESSFUL OPERATION OF ANY SYSTEM.

A 516508-B
A 1979

16 1/2
16 1/2
16 1/2
16 1/2
6 1/2

66 5 1/2

33
330

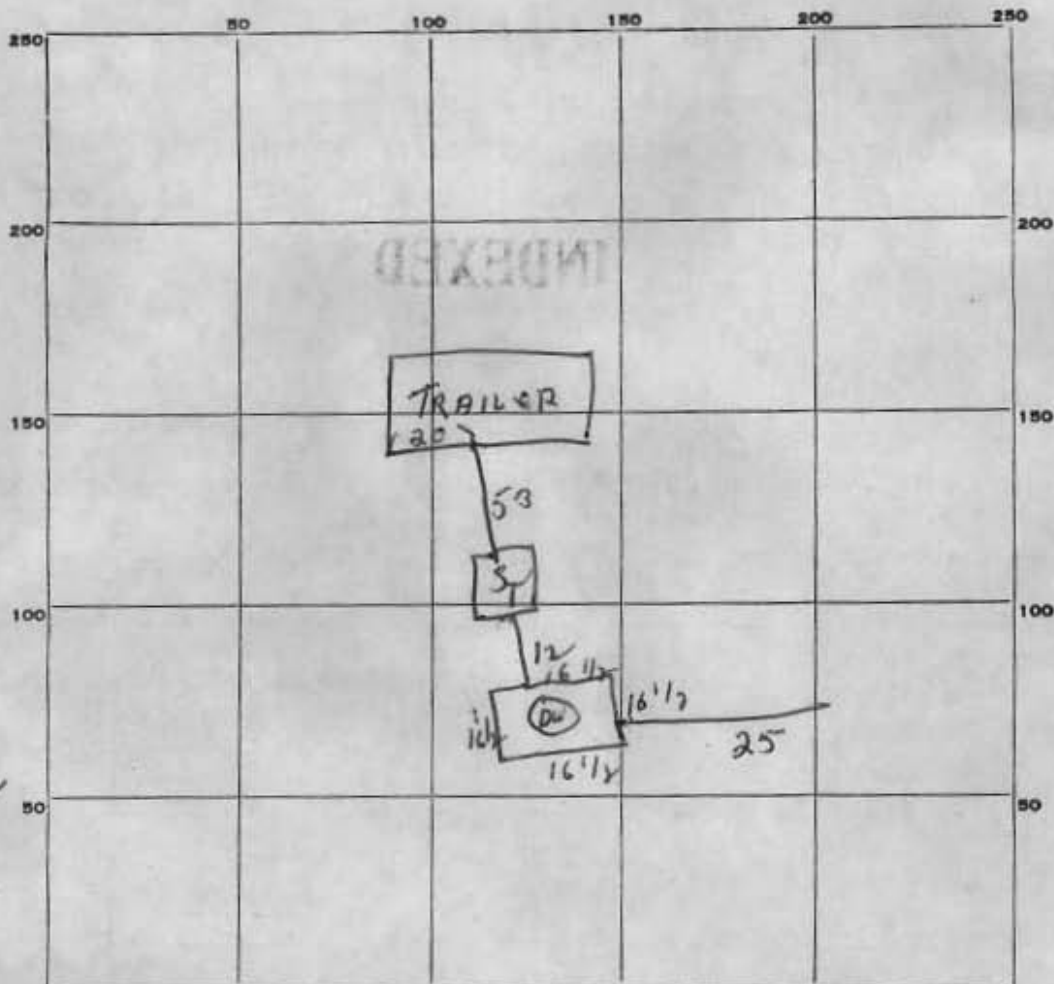

INDICATE NORTH. - NAME ADJOINING ROADWAY AS BASE LINE.

PERMIT CARD 012

SEPTIC TANK, LEVEL 012

CLEANOUTS 012

DISTRIBUTION BOX, LEVEL _____

TILE FIELD, DEPTH _____ FT. TRENCH WIDTH _____ FT.

GRAVEL DEPTH _____ IN. TOTAL LENGTH _____ FT.

NUMBER OF TRENCHES _____ TOTAL BOTTOM AREA _____

SEEPAGE PITS, ^{Perimeter} INSIDE DIAMETER 66 FT. DEPTH BELOW INLET 5 1/2 FT.

ABSORBENT AREA 363 SQ. FT.

REMARKS Trench - 25 ft long 6 ft gravel under pipe = 300 sq ft } 66 ft
363 sq ft } sq ft

DATE SYSTEM APPROVED 10/12/72 INSPECTOR [Signature]