

ok out
7/25/61

PERMIT

SEWAGE DISPOSAL SYSTEM

MARYLAND STATE DEPARTMENT OF HEALTH

HOWARD COUNTY

ELLICOTT CITY

DISTRICT 4

DATE 7-24-61

INDEXED

Herman Sirk

IS PERMITTED TO INSTALL X ALTER

ADDRESS Woodbine, Maryland PHONE

A SEWAGE DISPOSAL SYSTEM LOCATED AT Saint Micheal's Road between Old Annapolis Road
and Florence Road on east side of road

SUBDIVISION ROAD 1685 St. Michael's Rd LOT

PROPERTY OWNER Schulze, Albert A. main house

ADDRESS Adelphi, Maryland

SPECIFICATIONS

DRAIN FIELD DEPTH FEET, BOTTOM AREA SQ. FT.

SEEPAGE PITS 2 ABSORBENT SIDE-WALL AREA SQ. FT.

SEPTIC TANK CAPACITY 1000 GALLONS

FOR GARBAGE GRINDER, INCREASE DISPOSAL AREA 22% & TANK CAPACITY 50%.


OTHER 2 dry wells, each 10' diameter 6' deep below the inlet, the first 4'
of ground not be counted as side wall area

PLANS APPROVED BY James E. Hennigan DATE 4-20-61

FILL SEPTIC TANK AND DISTRIBUTION BOX WITH WATER BEFORE CALLING FOR AN INSPECTION. COVER NO WORK UNTIL INSPECTED AND APPROVED.

NEITHER THE HOWARD COUNTY COMMISSIONERS NOR THE HEALTH DEPARTMENT IS RESPONSIBLE FOR THE SUCCESSFUL OPERATION OF ANY SYSTEM.

003576

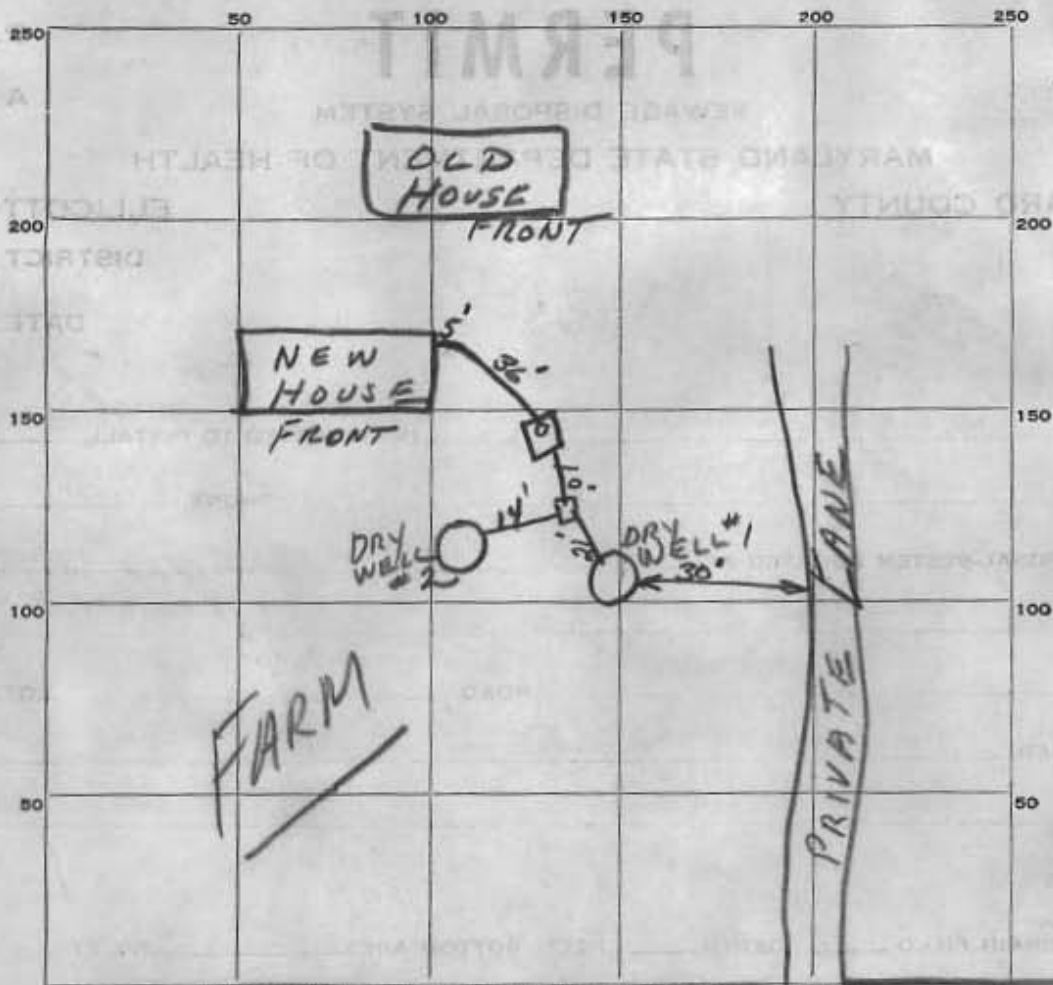

INDICATE NORTH - NAME ADJOINING ROADWAY AS BASE LINE.

ST. MICHAELS ROAD

PERMIT CARD

yes

SEPTIC TANK, LEVEL

OK concrete

CLEANOUTS

yes - standpipe

DISTRIBUTION BOX, LEVEL

OK

TILE FIELD, DEPTH

FT.

TRENCH WIDTH

FT.

GRAVEL DEPTH

IN.

TOTAL LENGTH

FT.

NUMBER OF TRENCHES

TOTAL BOTTOM AREA

DRY WELL #1 - 12 FT

8 FT. 3 in

SEEPAGE PITS, INSIDE DIAMETER

#2 - 11 FT.

8 FT. 8 in

ABSORBENT AREA

OK (over)

SQ. FT.

REMARKS

DATE SYSTEM APPROVED

7-25-61

INSPECTOR

J. Hennigan