

11/7/61 or 11/8/61
- P.M. or A.M.

Approved *See* 4/7/61

PERMIT

SEWAGE DISPOSAL SYSTEM

P. 0116

A. 0173

INDEXED

MARYLAND STATE DEPARTMENT OF HEALTH

HOWARD COUNTY

INDEXED

ELLCOTT CITY

DISTRICT 1

DATE 10/31/61

Howard Pickett

IS PERMITTED TO INSTALL ☒ ALTER

ADDRESS Route 2 Ft. Airy

PHONE MD. Airy 11301

A SEWAGE DISPOSAL SYSTEM LOCATED AT $\frac{1}{4}$ mile southeast of Hard Rd. on St. Michael's Rd.

First wooded lot past St. Michael's Ch. Co. lower end of lot has rock pile

SUBDIVISION

ROAD

LOT

PROPERTY OWNER Paul H. Pickett

ADDRESS Route 3 Mt. Airy

SPECIFICATIONS

DRAIN FIELD DEPTH FEET. BOTTOM AREA 90. FT.

SEEPAGE PITS ☒ ABSORBENT SIDE-WALL AREA 300 SQ. FT. below the inlet

SEPTIC TANK CAPACITY 750 GALLONS

FOR GARBAGE GRINDER, INCREASE DISPOSAL AREA 25% & TANK CAPACITY 50%.

OTHER To be installed at the best site.


Septic tank cannot be installed more than 3 feet below original grad e.

PLANS APPROVED BY Walton T. Loevy/dma DATE 6/1/61

FILL SEPTIC TANK AND DISTRIBUTION BOX WITH WATER BEFORE CALLING FOR AN INSPECTION. COVER NO WORK UNTIL INSPECTED AND APPROVED.

NEITHER THE HOWARD COUNTY COMMISSIONERS NOR THE HEALTH DEPARTMENT IS RESPONSIBLE FOR THE SUCCESSFUL OPERATION OF ANY SYSTEM.

108132

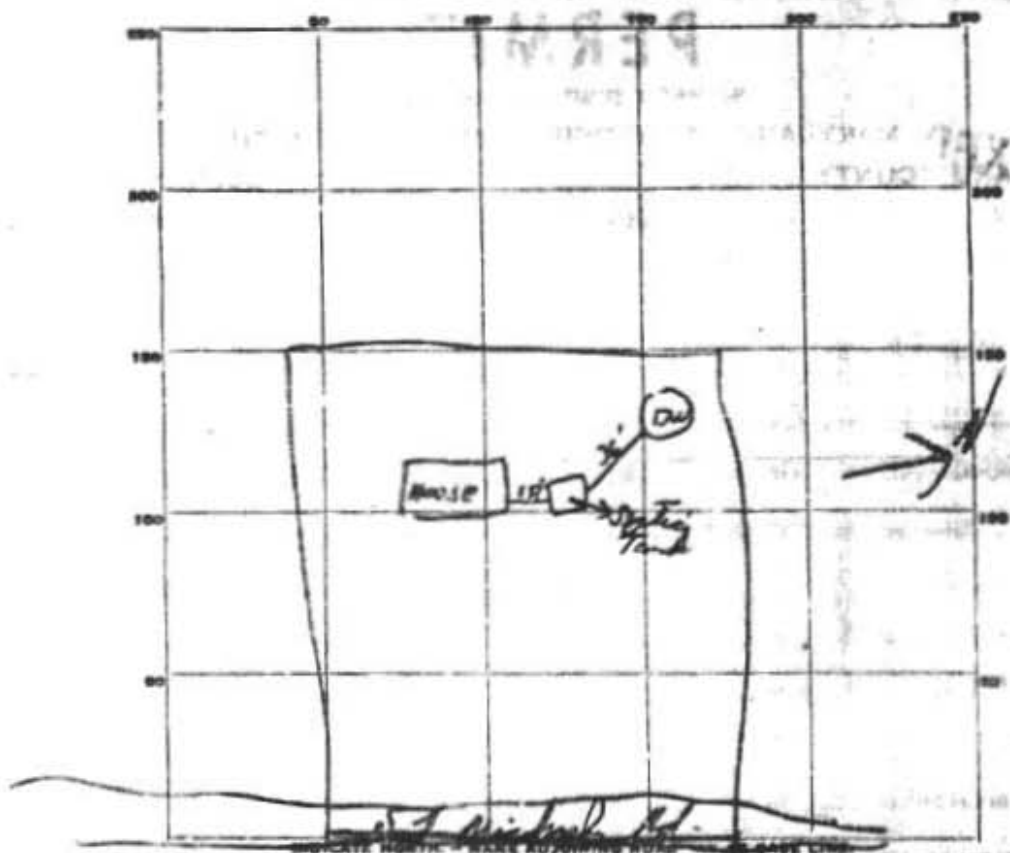

PERMIT CARD none

SEPTIC TANK, LEVEL ✓

CLEANOUT ✓

DISTRIBUTION BOX, LEVEL

TILE FIELD, DEPTH FT. TRENCH WIDTH FT.

GRAVEL DEPTH IN. TOTAL LENGTH FT.

NUMBER OF TRENCHES TOTAL BOTTOM AREA

SEEPAGE PITS, INSIDE DIAMETER 10' FT. DEPTH BELOW INLET 9 1/2 FT.

ABSORBENT AREA 298 SQ. FT.

REMARKS no permit card on premises, Cleanout not visible in
region Test 11/7/61

DATE SYSTEM APPROVED 11/7/61

INSPECTOR D.W. Monaghan