




Hi Jeff -

Please find the revised Perc Cert.

Plan enclosed. Thanks again for all your help!

Regards,
Abbey

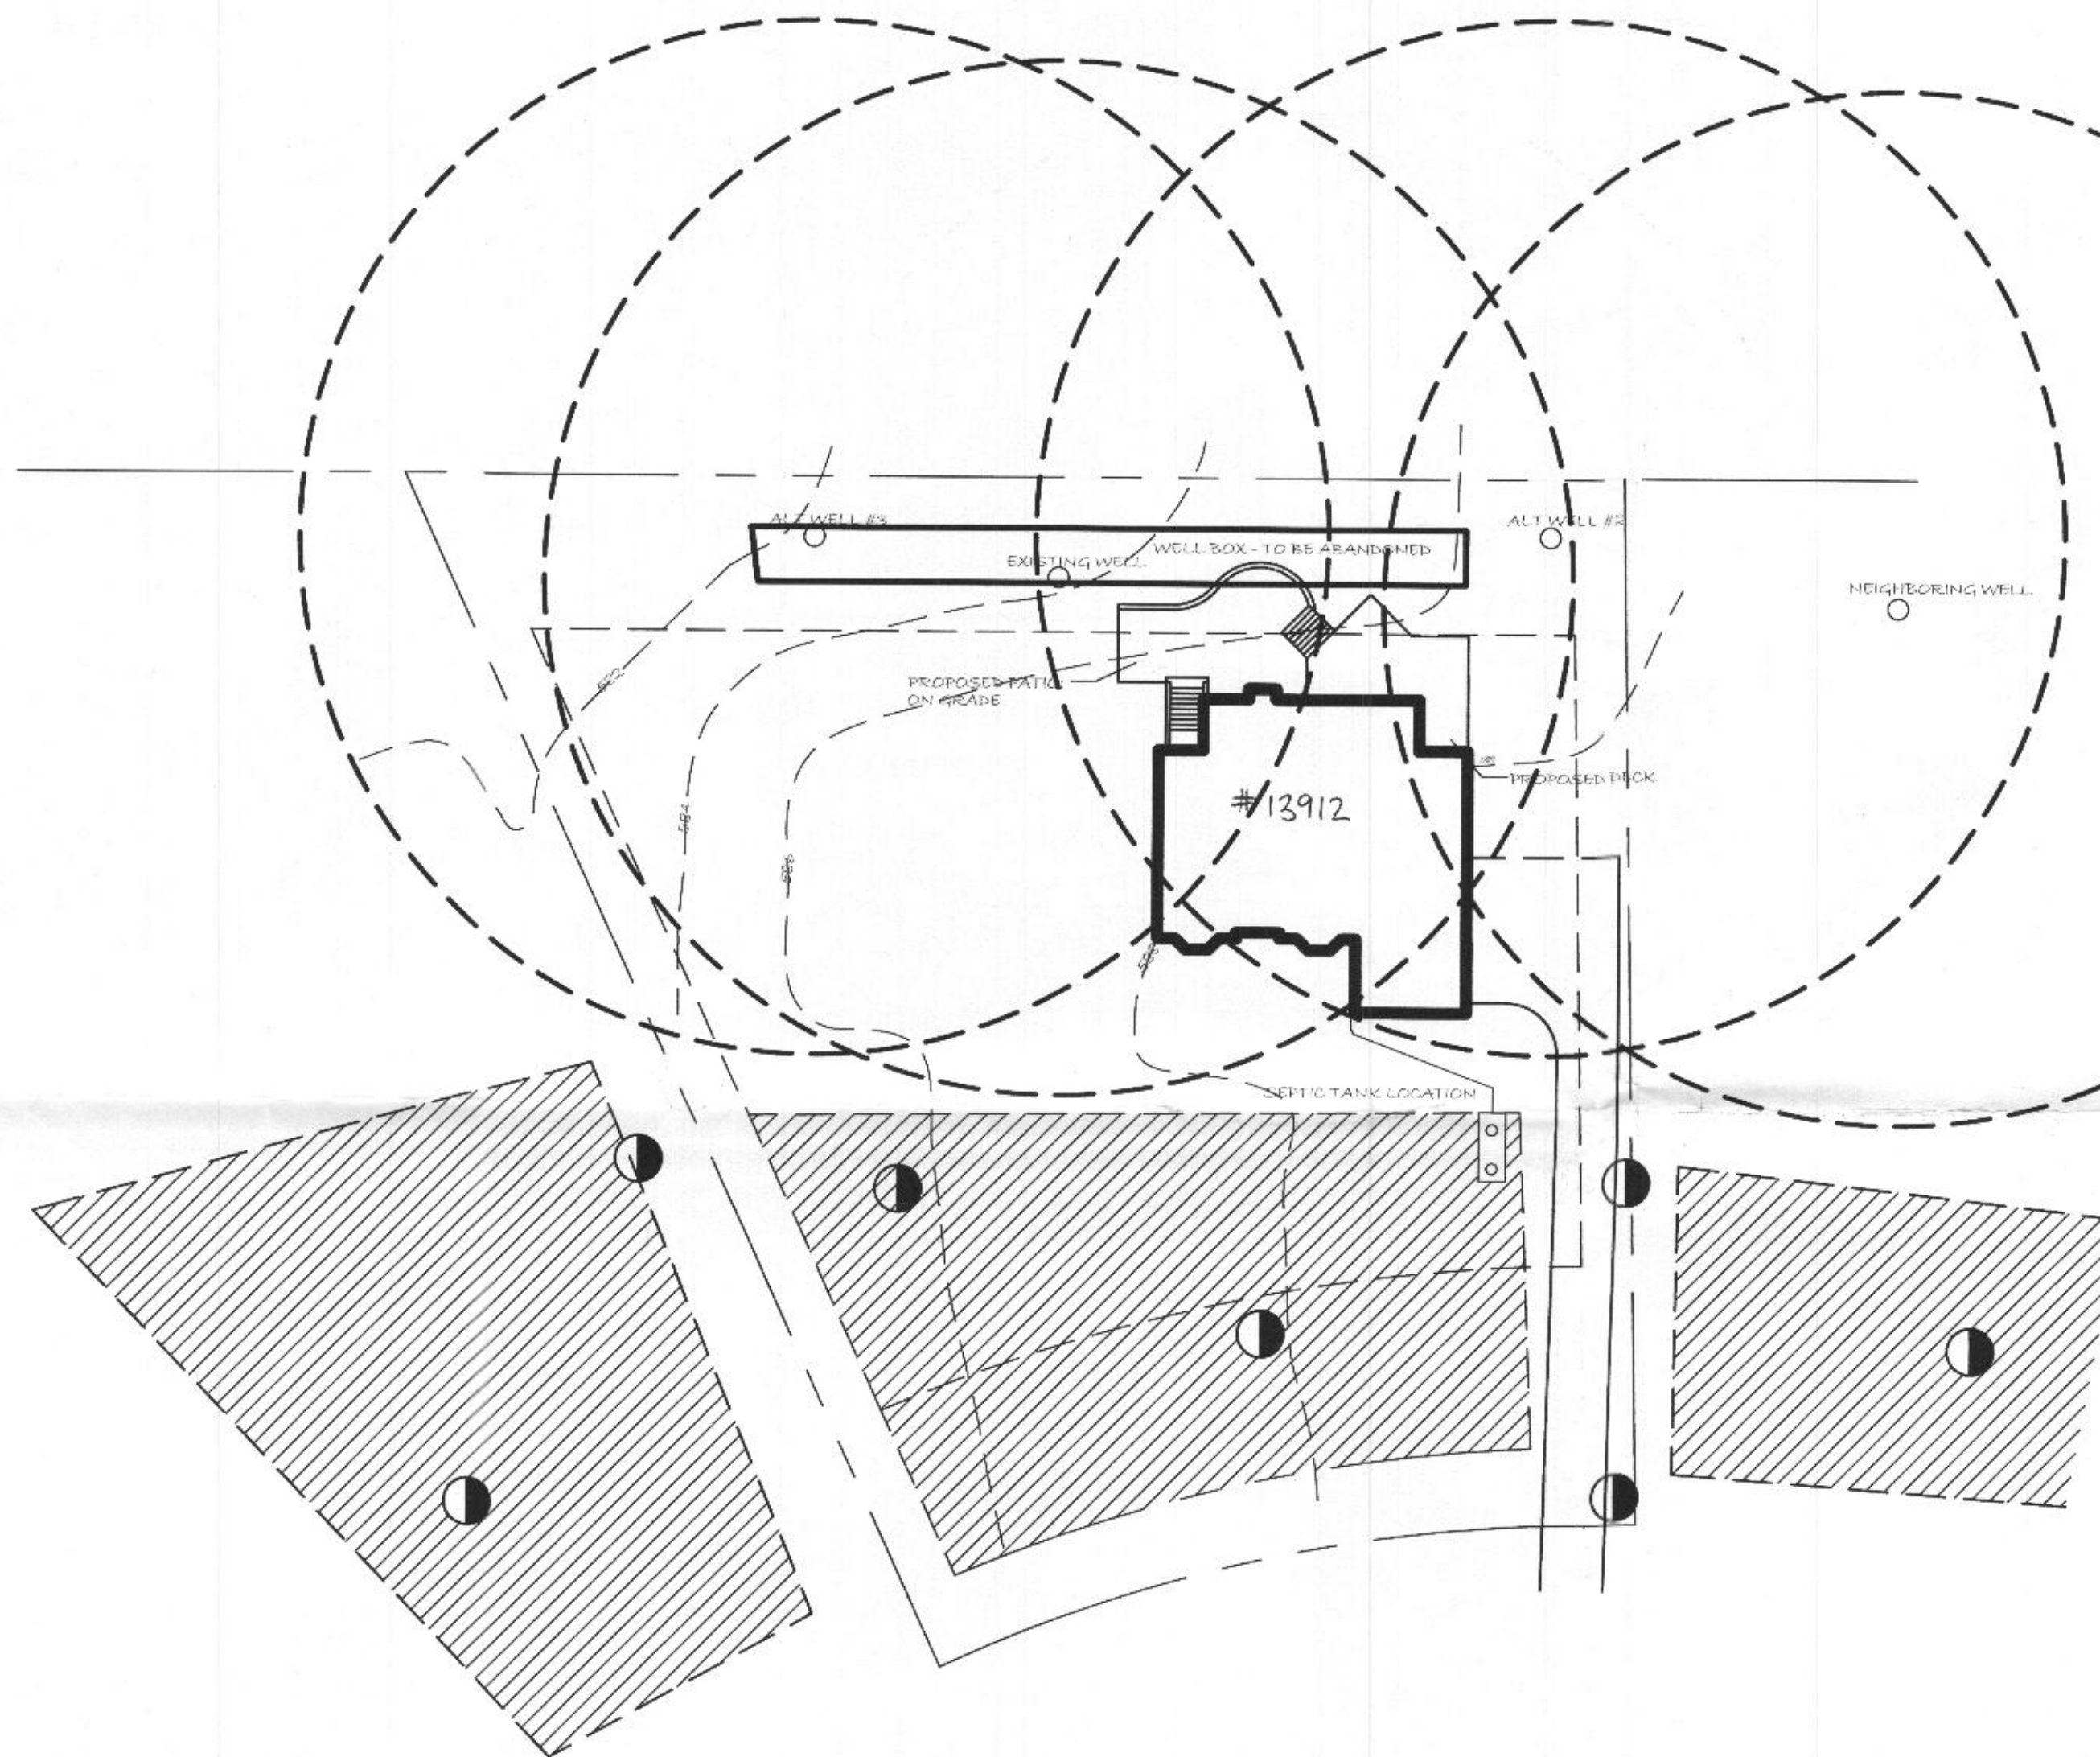

Purpose Statement:

The purpose of this plan is to revise the well box area in order to accommodate the installation of a deck and patio in the rear yard.

"I certify that the information shown hereon is based on field work performed by me or under my direct supervision, and is correct, to the best of my knowledge and belief."

Abbey Workman
Date

5-1-2013

Notes:

- Any changes to a private sewage easement shall require a revised percolation certification plan.
- The topography of this plat is taken from property plat dated 4-17-2012 and is verified to accurately represent the relative changes on the subject property.
- All wells and septic systems located within 100' of the property boundaries and 200' down gradient of any wells and/or septic systems have been shown.
- The lot shown hereon complies/comply with the minimum ownership width and lot area as required by the Maryland Department of Environment.



Passed Perc Holes



This area designates a private sewage disposal area of at least 20,000 sq. ft. as required by Maryland Department of Environment for individual sewage disposal. Improvements of any nature in this area are restricted. This sewage disposal area shall become null and void upon connection to a public sewerage system. The County Health Officer shall have authority to grant adjustments to the private sewage easement of a revised sewage easement shall not be necessary.

13912 Ryon Drive | Glenelg, MD
Community: Glenelg Estates
Property Owners: Heather Alsopp & Alex Figueroa

Approved For Private Water and Private Sewerage Systems

Mauro Rossman
Health Officer, Howard County Health Dept.

5/5/2013

Date



CLEARWATER
Landscape & Nursery

9585 Doctor Perry Road
Ijamsville, Maryland 21754

301.607.4480 (phone)
301.607.4481 (fax)

www.clearwaterlandscape.com

Revised Percolation Certification Plan 13912 Ryon Drive | Glenelg, MD

This drawing, the original landscape design, specifications, & details, depicted herein as instruments of service, are the sole & exclusive property of Clearwater Landscape & Nursery.

No reproductions or use of this drawing, specifications, &/or details depicted herein shall be made without the expressed written permission of Clearwater Landscape & Nursery.

REVISIONS		
#	Changes	Date


Designer: A. Workman

Date: 4-30-13

Scale: 1"=30'

Sheet #: 1 of 1

Drawing: 021312R4

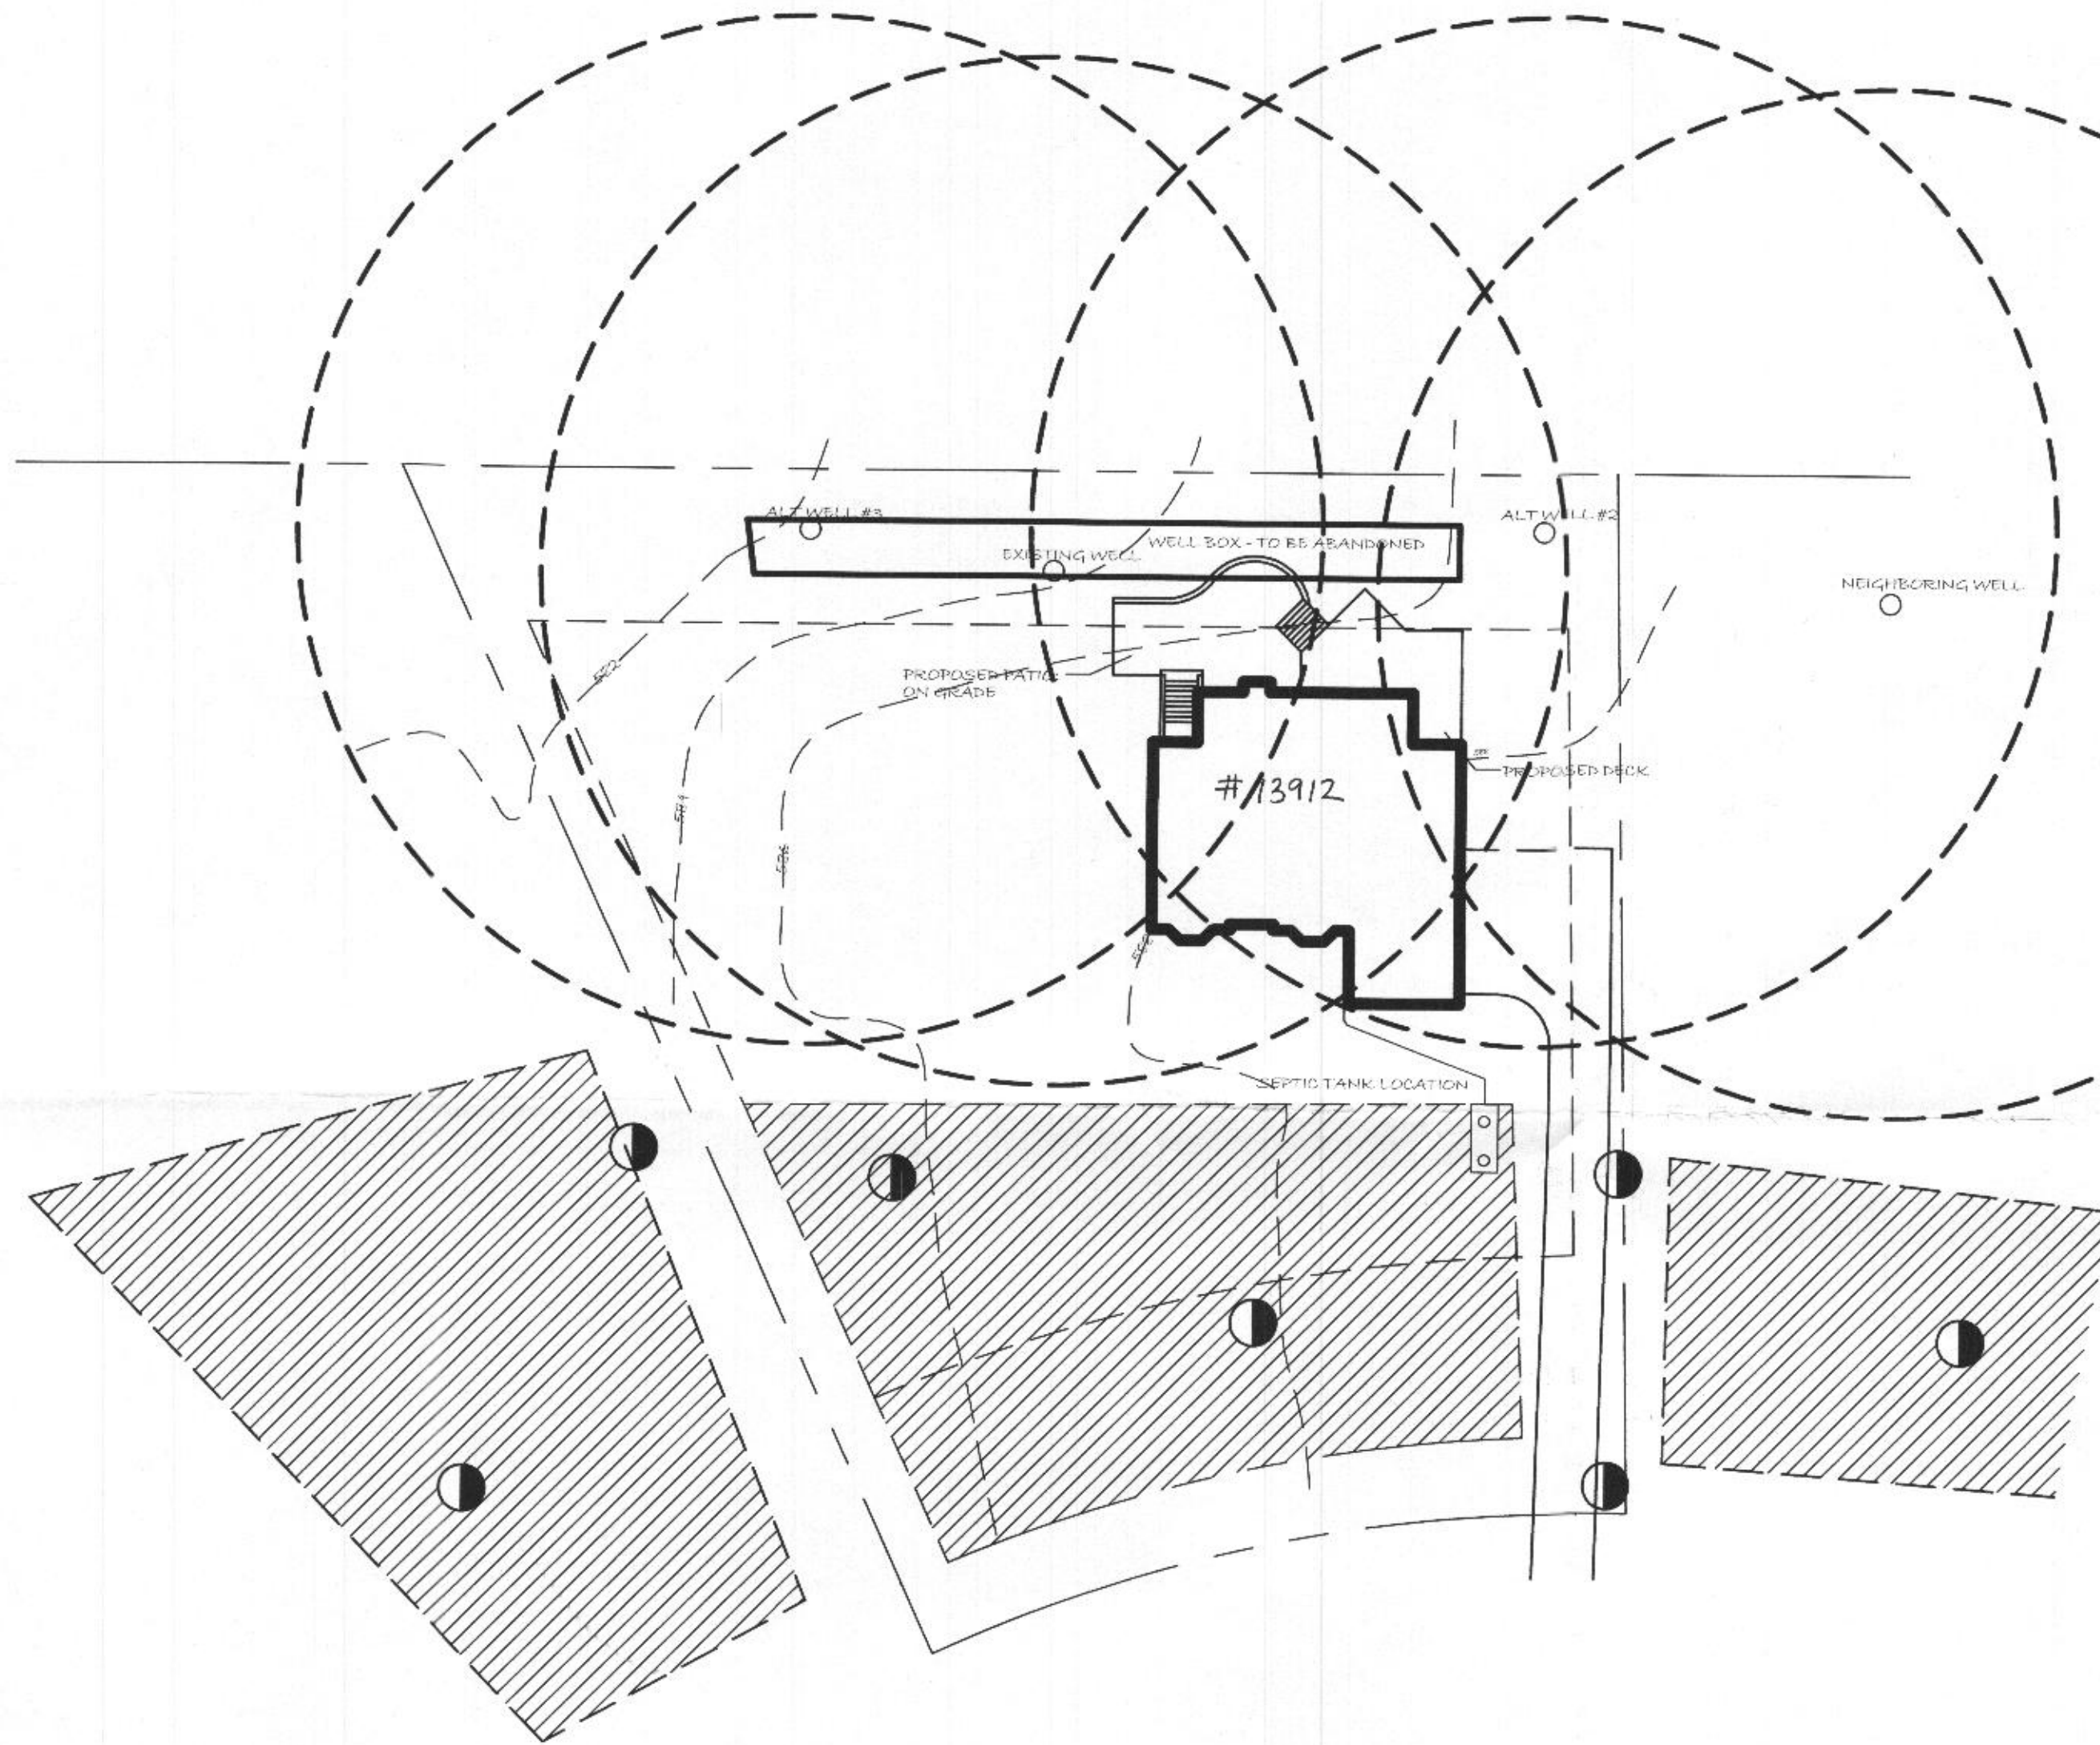

Purpose Statement:

The purpose of this plan is to revise the well box area in order to accommodate the installation of a deck and patio in the rear yard.

"I certify that the information shown hereon is based on field work performed by me or under my direct supervision, and is correct, to the best of my knowledge and belief."

Abbey Workman
AW

5-1-2013

Date

Notes:

- Any changes to a private sewage easement shall require a revised percolation certification plan.
- The topography of this plat is taken from property plat dated 4-17-2012 and is verified to accurately represent the relative changes on the subject property.
- All wells and septic systems located within 100' of the property boundaries and 200' down gradient of any wells and/or septic systems have been shown.
- The lot shown hereon complies/comply with the minimum ownership width and lot area as required by the Maryland Department of Environment



Passed Perc Holes



This area designates a private sewage disposal area of at least 10,000 sq. ft. as required by Maryland Department of Environment for individual sewage disposal. Improvements of any nature in this area are restricted. This sewage disposal area shall become null and void upon connection to a public sewerage system. The County Health Officer shall have authority to grant adjustments to the private sewage easement of a revised sewage easement shall not be necessary.

13912 Ryon Drive | Glenelg, MD
Community: Glenelg Estates
Property Owners: Heather Alsopp & Alex Figueroa

Approved For Private Water and Private Sewerage Systems
Barbara M. Mason 5/15/2013
Health Officer, Howard County Health Dept. #5 Date 1790



CLEARWATER
Landscape & Nursery

9585 Doctor Perry Road
Ijamsville, Maryland 21754

301.607.4480 (phone)
301.607.4481 (fax)

www.clearwaterlandscape.com

Revised Percolation Certification Plan 13912 Ryon Drive | Glenelg, MD

This drawing, the original landscape design, specifications, & details, depicted herein as instruments of service, are the sole & exclusive property of Clearwater Landscape & Nursery.

No reproductions or use of this drawing, specifications, &/or details depicted herein shall be made without the expressed written permission of Clearwater Landscape & Nursery.

REVISIONS		
#	Changes	Date

Designer: A. Workman
Date: 4-30-13
Scale: 1"=30'
Sheet #: 1 of 1
Drawing: 021312R4