

APPLICATION

PERCOLATION TESTING

HOWARD COUNTY HEALTH DEPARTMENT
BUREAU OF ENVIRONMENTAL HEALTH
P.O. BOX 476 ELLICOTT CITY, MARYLAND 21043
TELEPHONE: 461-9933

A 43029

P _____

DISTRICT 571

DATE 9-20-88

TO: THE COUNTY HEALTH OFFICER
ELLICOTT CITY, MARYLAND

I HEREBY APPLY FOR THE NECESSARY TEST IN ORDER TO CONSTRUCT (OR RECONSTRUCT) A SEWAGE DISPOSAL SYSTEM.

PROPERTY OWNER RUSSELL ZEPP LESLEY & DEBORAH BARKER

ADDRESS 13790 HIGHLAND RD PHONE 854-2797

PROSPECTIVE BUYER HENRY L. BLEVINS

ADDRESS 3600 WATERSVILLE RD PHONE 795-2337

MT. AIRY, MD. 21771

PROPERTY LOCATION: ZEPP SUBDIVISION

SUBDIVISION ZEPP SUBDIVISION LOT NO. 8 SFD-4Bms.

ROAD AND DESCRIPTION HIGHLAND ROAD HOWARD CO

ZIP: 21029 (13841 Russell Zepp Drive)

TAX MAP 34 PARCEL # 7

SIZE OF LOT 3.70 AC ± TYPE BLDG. SINGLE FAMILY

(SINGLE FAMILY DWELLING OR COMMERCIAL)

THE SYSTEM INSTALLED UNDER THIS APPLICATION IS ACCEPTABLE ONLY UNTIL PUBLIC FACILITIES BECOME AVAILABLE. I FULLY UNDERSTAND THE FEE CONNECTED WITH THE FILING OF THIS PERC TEST APPLICATION IS NON-REFUNDABLE UNDER ANY CIRCUMSTANCES. I ALSO AGREE TO COMPLY WITH ALL M.O.S.H.A. REQUIREMENTS IN TESTING THIS LOT.

(SIGNATURE OF APPLICANT)

APPROVED BY _____ FOR _____ DATE _____

REJECTED BY _____ FOR _____ DATE _____

HOLD PENDING FURTHER TESTS _____ DATE _____


REASONS FOR REJECTION OR HOLDING 5-8-89 Regs. Satisfactory - Hold for Repl. 800

HD-216

THIS IS NOT A PERMIT

SOIL PROFILE

	AD
6"	Yellow Red Clay loam 10-15% Fraps
4"	Red Brown Silt loam Slightly sandy 10-20% Fraps
12.5"	

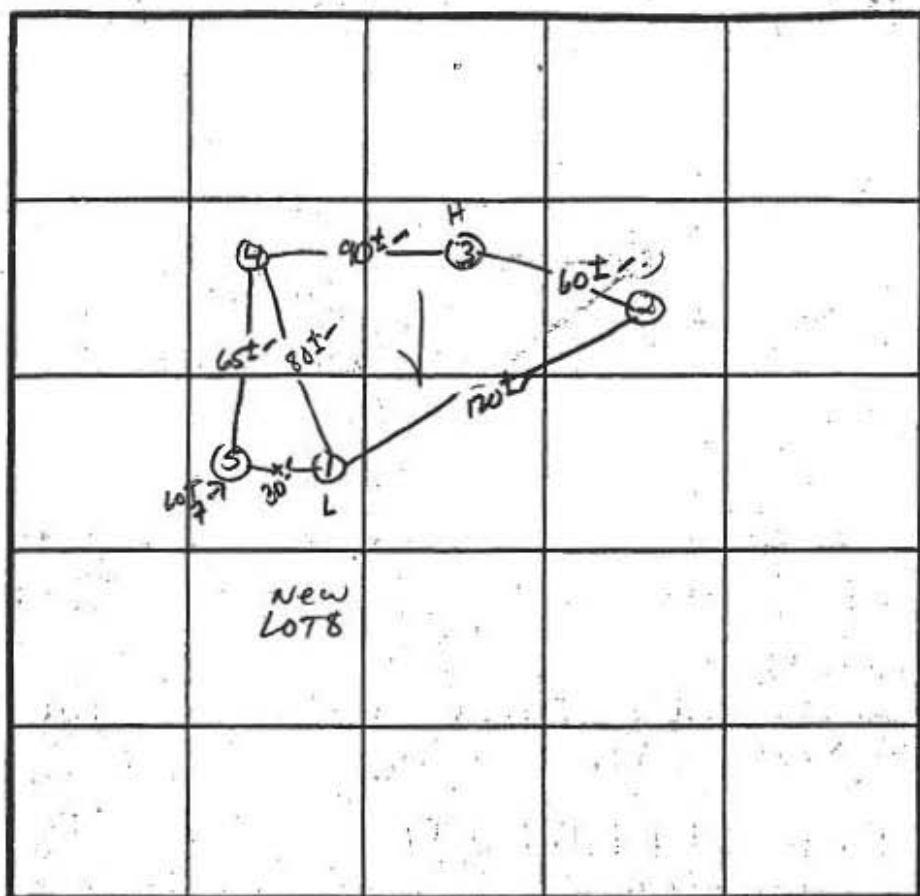

$\overline{X}$ 10 MIN
 210 ~~4~~
 INERT 4
 BOTTOM 7

1 Highland Red.

[illegible]

REMARKS Holes diff than last.

TYPE OF SOIL Cherty mazon

TESTED BY Smel ALSO PRESENT _____

APPLICATION

PERCOLATION TESTING

HOWARD COUNTY HEALTH DEPARTMENT
BUREAU OF ENVIRONMENTAL HEALTH
P.O. BOX 476 ELLICOTT CITY, MARYLAND 21043
TELEPHONE: 461-9933

A 43079

P _____

DISTRICT 5TH

DATE 9-20-88

TO: THE COUNTY HEALTH OFFICER
ELLICOTT CITY, MARYLAND

I HEREBY APPLY FOR THE NECESSARY TEST IN ORDER TO CONSTRUCT OR RECONSTRUCT A SEWAGE DISPOSAL SYSTEM.

PROPERTY OWNER RUSSELL ZEPP

ADDRESS 13790 HIGHLAND RD PHONE 854-2797

PROSPECTIVE BUYER HENRY L. BLEVINS

ADDRESS 3600 WATERSVILLE RD PHONE 795-2337
MT. AIRY, MD. 21771

PROPERTY LOCATION:

SUBDIVISION ZEPP SUBDIVISION LOT NO. 8

ROAD AND DESCRIPTION HIGHLAND ROAD HOWARD CO

ZIP: 21029

TAX MAP 34 PARCEL # 7

SIZE OF LOT 3.70 AC ± TYPE BLDG. SINGLE FAMILY
(SINGLE FAMILY DWELLING OR COMMERCIAL)

THE SYSTEM INSTALLED UNDER THIS APPLICATION IS ACCEPTABLE ONLY UNTIL PUBLIC FACILITIES BECOME AVAILABLE. I FULLY UNDERSTAND THE

FEE CONNECTED WITH THE FILING OF THIS PERC TEST APPLICATION IS NON-REFUNDABLE UNDER ANY CIRCUMSTANCES. I ALSO AGREE TO COMPLY

WITH ALL M.O.S.H.A. REQUIREMENTS IN TESTING THIS LOT. [Signature]
(SIGNATURE OF APPLICANT)

APPROVED BY _____ FOR _____ DATE _____

REJECTED BY _____ FOR _____ DATE _____

HOLD PENDING FURTHER TESTS _____ DATE _____

REASONS FOR REJECTION OR HOLDING perc UNSAT, hold pending review


HD-216

THIS IS NOT A PERMIT

LOT 8
A43079

SOIL PROFILE

6" topsoil
deep
orange
clay
to
w/some
lt. grey
sand
at bottom
10% frags
no mica

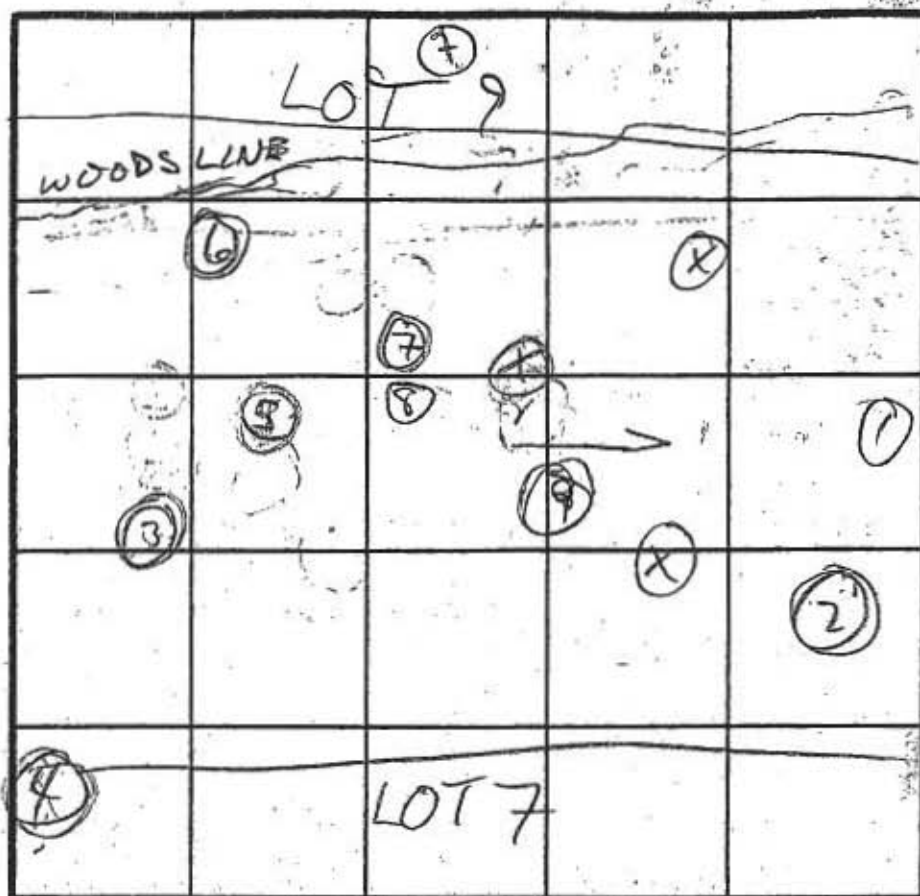

(X) = STAKED
BUT NOT
DUG

INDICATE NORTH - NAME ADJOINING ROADWAY AS BASE LINE

DATE	TEST NO	DEPTH	PRE-WET		TEST - 1" DROP		TIME
			START	STOP	START	STOP	
3/2/89	1	9					
1/1	(2)	9	clay to bottom w/some sand + large frags no mica				
	(3)	8½	clay to bottom 10% frags no mica				
	(4)	9½	clay to bottom < 5% frags no mica				
	(5)	8½	pink/org/yel clay to bottom 5% frags no mica				
	(6)	9	org/pink clay to bottom 10% frags no mica				
3/10/89	(7)	8½	org/yel/bw clay to bottom 10% frags no mica				
1/1	8	6½	12:31 NOT COMPLETED				
	(9)		<u>WATER AT 7½</u>				

REMARKS: HOLE 1 PER PLAT, OTHERS NOT PER PLAT
INSUF AREA REMAINING FOR ADD'L TESTING

TYPE OF SOIL

TESTED BY

M. Rifkin

ALSO PRESENT

D. Hopkins