



HOWARD COUNTY HEALTH DEPARTMENT

63018

DATE 10/8/1

Received From

Tyler Septic Cloaca

PHONE #

AS
410-795-5670

☐ CASH

☒ CHECK

NO.

01047

For

POUC Repair / 12182
Tweed Delphia KE.

\$

330.00

Dollars

Received By

A King



Bureau of Environmental Health

8930 Stanford Boulevard, Columbia, MD 21045

Main: 410-313-2640 | Fax: 410-313-2648

TDD 410-313-2323 | Toll Free 1-866-313-6300

www.hchealth.org

Facebook: www.facebook.com/hocohealth

Twitter: HowardCoHealthDep

Maura J. Rossman, M.D., Health Officer

APPLICATION

FOR PERCOLATION TESTING AND SITE EVALUATION

A 563018

PROPERTY LOCATION

SUBDIVISION/PROPERTY NAME

PROPERTY ADDRESS

12182 Triadelphia Rd

Ellicott City

21042

STREET

TOWN

ZIP

TAX ACCOUNT #

284689

TAX MAP

116

GRID

19

PARCEL

239

LOT NO.

PROPOSED LOT

SIZE (ACRES)

.745 AC

ZONING CATEGORY

TIER

PROPERTY OWNER(S)

Nadine & Jerome Warman

DAYTIME PHONE

443-546-8867

CELL

EMAIL

MAILING ADDRESS

12182 Triadelphia Rd

Ellicott City

21042

STREET

CITY, STATE

ZIP

APPLICANT

Fogle's Septic Clean

RELATIONSHIP TO OWNER:

Contractor

DAYTIME PHONE

410-795-5670

CELL

EMAIL

MAILING ADDRESS

580 Obrecht Rd

Sparksville Md

21784

STREET

CITY, STATE

ZIP

I HEREBY APPLY FOR THE NECESSARY TESTING/EVALUATION PRIOR TO ISSUANCE OF SEWAGE DISPOSAL SYSTEM PERMIT(S):

PROPERTY:

- ☐ SUBDIVISION: NUMBER OF LOTS INCLUDING RESIDUE: _____
SUBDIVISION CLASSIFICATION (PER DEPT. OF PLANNING AND ZONING) ☐ MAJOR ☐ MINOR
- ☐ CONSTRUCT NEW OSDS ON UNDEVELOPED LOT
- ☒ REPAIR OR REPLACE FAILING OSDS
- ☐ UPGRADE EXISTING OSDS

BUILDING:

- ☒ RESIDENTIAL WITH 3 EXISTING OR PROPOSED BEDROOMS IN THE COMPLETED STRUCTURE
- ☐ COMMERCIAL (PROVIDE DETAIL OF TYPE OF USE AND NUMBERS OF EMPLOYEES/CUSTOMERS ON ACCOMPANYING PLAN)

IS THE PROPERTY WITHIN 2500 FEET OF ANY RESERVOIR?

- ☐ YES
- ☒ NO

AS APPLICANT, I UNDERSTAND THE FOLLOWING:


- THIS APPLICATION IS VALID FOR TWO(2) YEARS FROM DATE OF FEE PAYMENT AND APPROVAL IS BASED UPON HEALTH OFFICER SIGNATURE OF A PERC CERTIFICATION PLAN PRIOR TO EXPIRATION OF THIS PERMIT.
- THE APPLICATION FEE IS NON-REFUNDABLE
- THIS APPLICATION MUST BE ACCOMPANIED BY ALL APPLICABLE FEES AND A SUITABLE SITE PLAN IN ORDER TO BE PROCESSED
- THIS IS A PUBLIC DOCUMENT

I declare and affirm that to the best of my knowledge, the information contained herein is correct. I declare that I am the owner of the property or duly authorized to make this application on behalf of the owner. I agree to comply with all applicable state and county regulations.

By signature of this application, I hereby grant Howard County Health Department officials the right to enter onto the property for the purpose of inspecting the property as directly related to the requested permit/service.

SIGNATURE OF APPLICANT

DATE

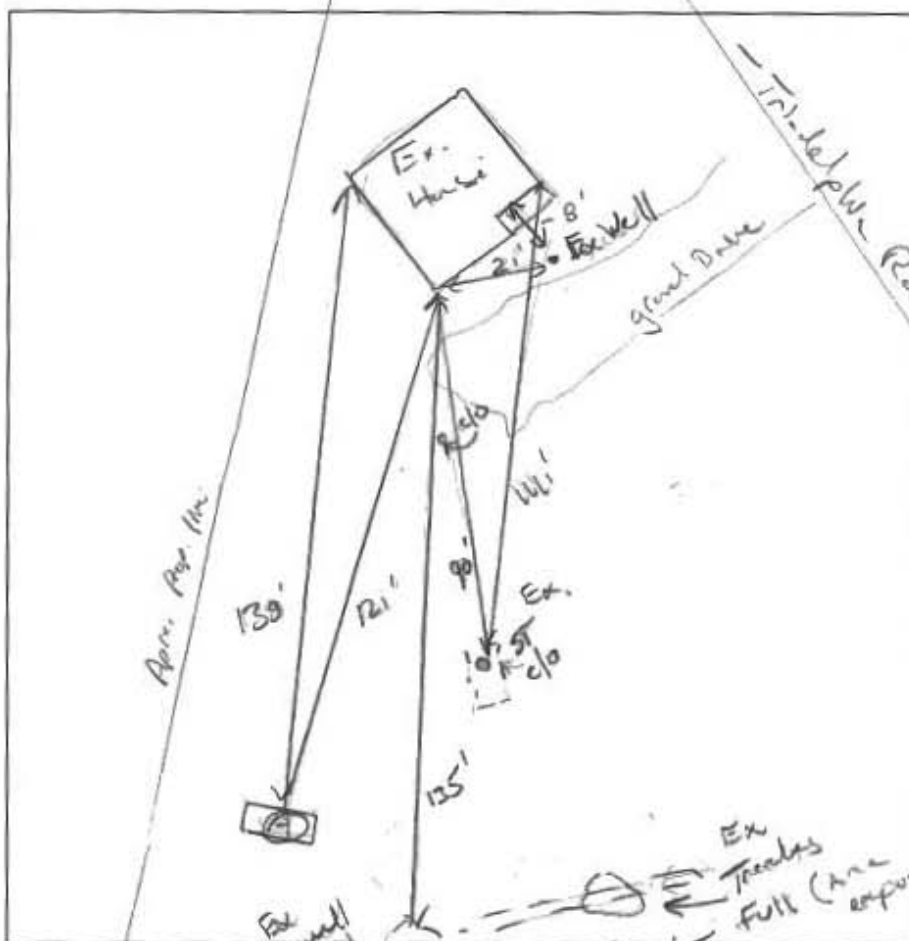

2' 1/2" CL, Dr.
lasts m 25 BK
Br CL
WK GSSBK
Frickle,
10% siltstone channels

4' Y/Ar. L.
m Co thick PL
- m SSK
Frickle,
clay folms

6' Br/Y L,
channeling,
10% siltstone channels
Roots gravel
WK Co SSK - WK TH PL

9' 1/2" CL,
WK Co PL
20% red siltstone channels
highly porous

14'

[illegible]

REMARKS Soil below trenches high H₂O
SANITARIAN K. Wolf BACKHOE Take OTHERS 141/2
TEST HOLES USED IN SDA 1 AVG. PERC TIME _____ SQ. FT/BR _____
TRENCH WIDTH 2 INLET DEPTH 4' MAX. BOT DEPTH 9.5' EFFECTIVE SW 6 (40)

$$\frac{41.5^\circ}{0.8} = 562.5 \div 2 = 281.25 (.40) = \underline{113 \text{ LF}} \quad 3 \times 38$$



Bureau of Environmental Health

2930 Stanford Boulevard, Columbia, MD 21045

Main: 410-313-2540 | Fax: 410-313-2548

TDD 410-313-2323 | Toll Free 1-866-313-5300

www.hchealth.org

Facebook: www.facebook.com/hchealth

Twitter: HowardCoHealthDep

Dr. Maura J. Rossman, M.D., Health Officer

INFORMATION FORM - SEPTIC SYSTEM REPAIR/UPGRADE

Reason for Request:

- ☒ Failing System
☐ System relocation for proposed addition
☐ System upgrade for proposed addition
☐ Inadequate treatment zone
☐ Collapsed septic tank
☐ Collapsed drywell

Existing system design

- ☐ Drywell
☒ Trench
☐ Mound
☐ Unknown
☐ Other: _____

Is discharge surfacing on the ground?

- ☒ Yes
☐ No

Has the septic tank been pumped within the last month?

- ☐ Yes Date pumped: _____
☒ No

Was a visual inspection of the septic tank and/or drain fields conducted?

- ☐ Yes Explain observations: Septic inspection done
☒ No By home land

Was a visual inspection of the sewage line conducted?

- ☐ Yes
Blockage leading to the tank:
☐ Yes. Explain: _____
☐ No
Blockage leading to the field:
☐ Yes. Explain: _____
☒ No

☐ No
Additional Comments: _____

*For REPAIRS, are the owners proposing, or do they plan to add in the future, any additions or modifications to the property, i.e. pools, living space additions, garages, etc? This information must be disclosed at the time of this application. The Health Department will not be able to accommodate requests in the field for property modifications unrelated to the repair request. Such requests may require an additional fee, testing, and submittal of a Percolation Certification Plan, if the property does not meet current Code and Regulation.

Septic Contractor: Fogle's Septic Contractor's Phone: 410.795-5670

Contractor's Address: 500 Obrecht Rd Salisbury, Md 21784

Property Address: 12182 Triadelphia Rd County file: _____

Subdivision: N/A Lot: _____ Year Built: _____

Owner's Name: Nedine Warman Owner's Phone: 443.546.8867 SON Jaron

Name of previous owners: N/A Existing bedrooms: 3

Proposed bedrooms: _____

Has this request been previously discussed with a Sanitarian? (Name): _____

Public Sewer available/nearby: _____

*A Sanitarian will be in contact within three business days, depending upon the urgency of the situation, to coordinate the scheduling/review of the repair or upgrade.

Prior to scheduling inspections, scaled plans should be submitted to clarify the nature of the addition.

Print out a copy of Real Property Data via Dept. of Taxation website _____ Indexed file found _____

If public sewer may be nearby, verify whether sewer is technically "available" through the Bureau of Engineering.

If sewer is available and the property is within the Metropolitan District, connection to sewer is required. If the owner believes reason for exemption exists, the owner should justify the request in writing.

If soil/site conditions are limited and sewer and/or Metro District status is not conducive to connection, the Sanitarian may recommend pursuit of Emergency Sewer Extension or Emergency Metro District Inclusion. The Owner should contact the Bureau of Utilities for details.

No permit is to be issued nor inspection to be scheduled without prior fee collection at the office unless an emergency situation exists. The contractor is to notify office of the emergency situation as soon as possible.