

41.0 17.58
PERMIT

SEWAGE DISPOSAL SYSTEM

MARYLAND STATE DEPARTMENT OF HEALTH

HOWARD COUNTY

ELLICOTT CITY

DISTRICT 5

DATE 4/23/69

INDEXED

Otto Jewell, Jr. IS PERMITTED TO INSTALL ALTER X

ADDRESS 10850 Green Mt. Cir., Apt. 2-1 PHONE 373-9133
Columbia, Maryland
A SEWAGE DISPOSAL SYSTEM LOCATED AT _____

SUBDIVISION _____ ROAD 17000 Corner of Rt. 216 LOT _____

PROPERTY OWNER same as above

ADDRESS _____

SPECIFICATIONS

DRAIN FIELD _____ DEPTH _____ FEET. BOTTOM AREA _____ SQ. FT.

SEEPAGE PITS _____ ABSORBENT SIDE-WALL AREA _____ SQ. FT.

SEPTIC TANK CAPACITY _____ GALLONS

FOR GARBAGE GRINDER, INCREASE DISPOSAL AREA 22% & TANK CAPACITY 80%.

OTHER. REPAID - Long deep narrow ditch - 2 ft. wide - 50 ft. long - 10 ft.

deep filled with at least 4 ft. of stone. Two inspections necessary


one when ditch is completed and another after ditch is filled with 4 ft.

of stone.

PLANS APPROVED BY Raymond Hedges DATE 4/23/69

FILL SEPTIC TANK AND DISTRIBUTION BOX WITH WATER BEFORE CALLING FOR AN INSPECTION. COVER NO WORK UNTIL INSPECTED AND APPROVED.

NEITHER THE HOWARD COUNTY COMMISSIONERS NOR THE HEALTH DEPARTMENT IS RESPONSIBLE FOR THE SUCCESSFUL OPERATION OF ANY SYSTEM.

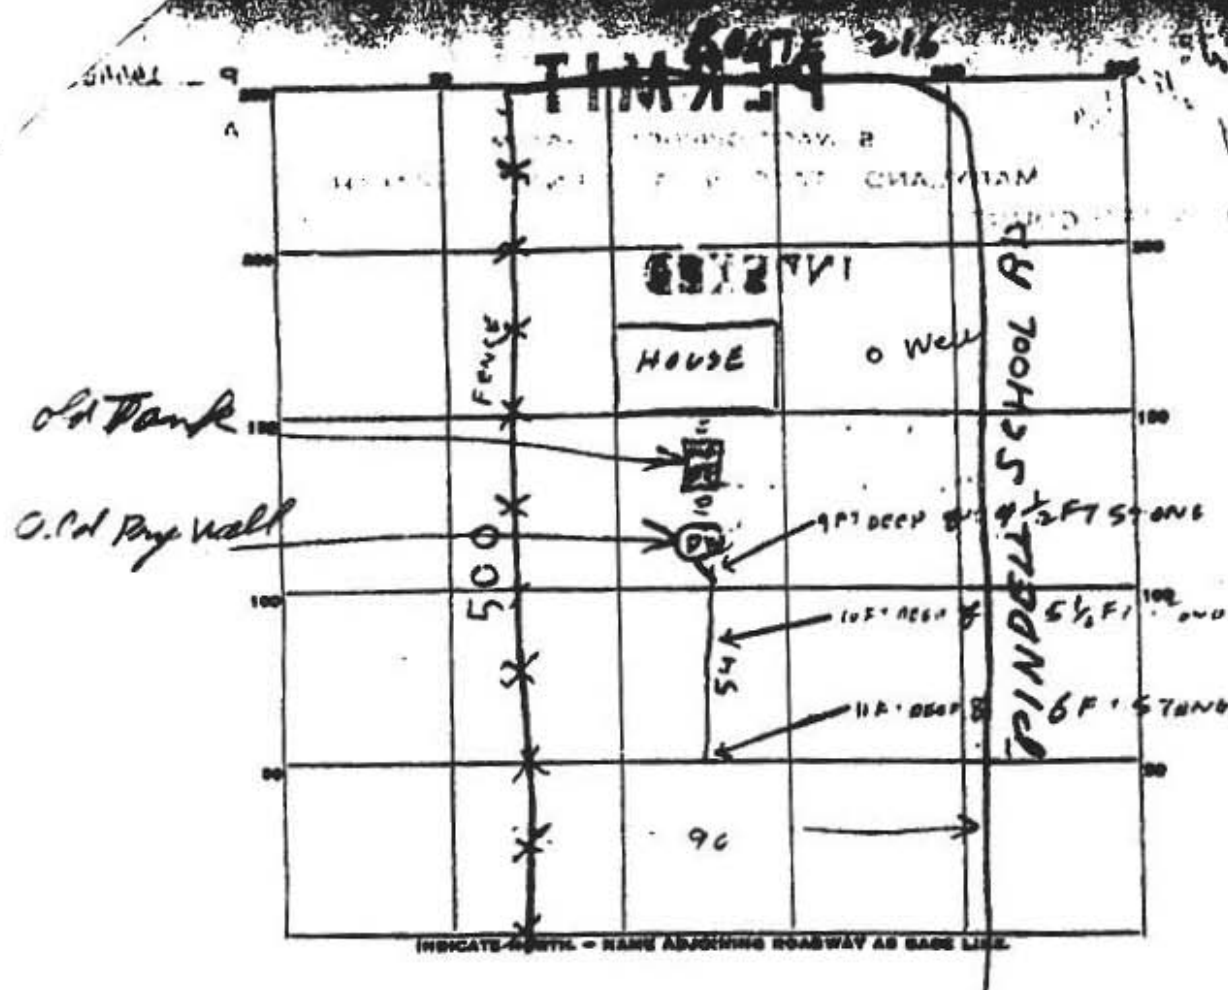

PERMIT CARD _____

SEPTIC TANK, LEVEL old Tank

CLEANOUTS _____

DISTRIBUTION BOX, LEVEL _____

SEPTIC DITCH THE FIELD, DEPTH 9-11 FT. TRENCH WIDTH 2 FT.

GRAVEL DEPTH 4 1/2 - 6 FT IN. TOTAL LENGTH 54 FT.

NUMBER OF TRENCHES _____ TOTAL BOTTOM AREA 108 SQ. FT.

TOTAL SIDEWALL AREA 540 SQ. FT.

SEEPAGE PITS, INSIDE DIAMETER _____ FT. DEPTH BELOW INLET _____ FT.

ABSORBENT AREA _____ SQ. FT.

REMARKS _____

DATE SYSTEM APPROVED 11/24/07

INSPECTOR Raymond J. Torres