


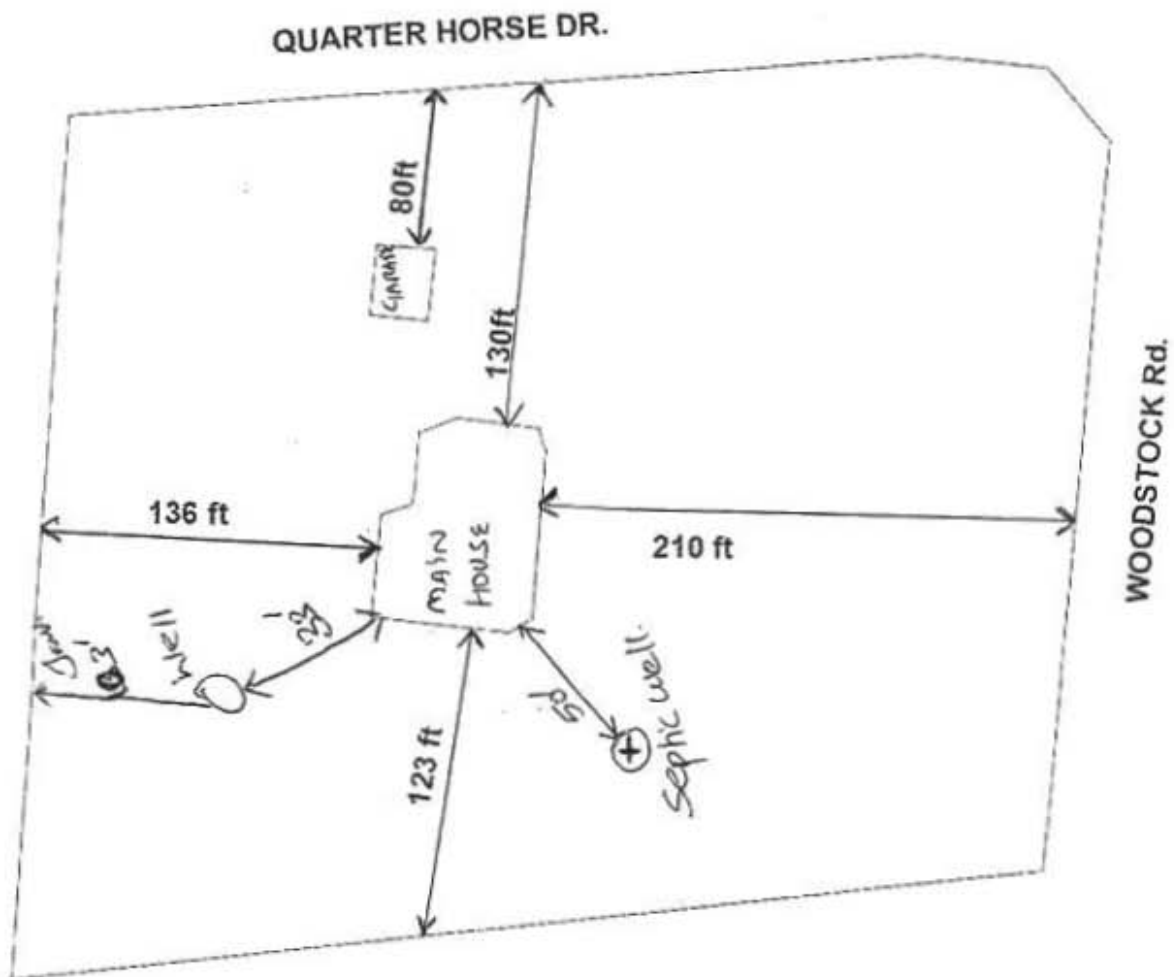

1801 QUARTER HORSE Dr, WOODSTOCK MD.21163

PARCEL- 03310442

LOT - 173.066 A.

LOT SIZE - 3 Acres


APPROVED

WALK-THRU BUILDING PERMIT


BP# _____ A# _____

APP. SAN H. Oswald DATE: 6/27/15


DESC. OF WORK: Replace damaged
part of roof on garage and add
approx. 300 sq ft to garage.

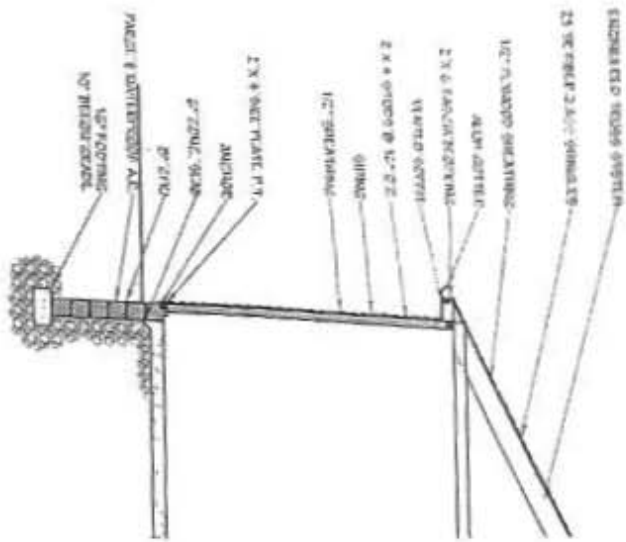

WALL SECTION

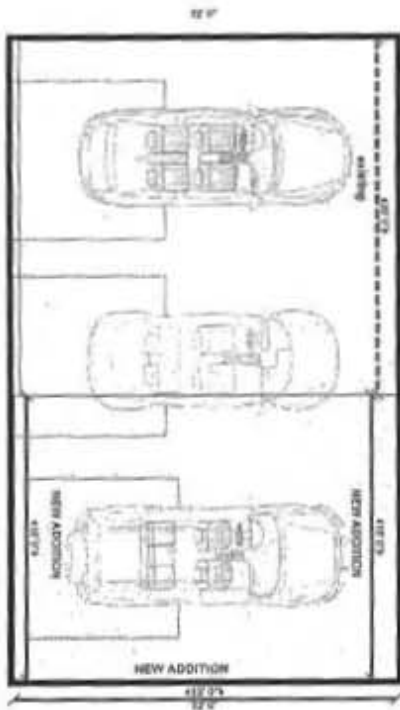


☐ EXISTING **FLOOR PLAN** ☐ NEW ADDITION
 SCALE = 1/8" = 1'-0"

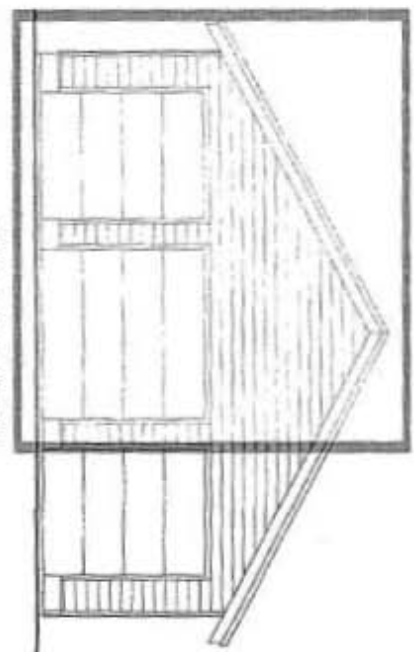


FRONT ELEVATION

☐ EXISTING
☐ NEW ADDITION

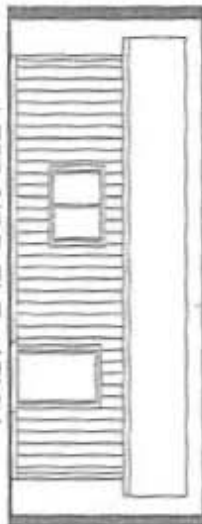

LEFT SIDE ELEVATION

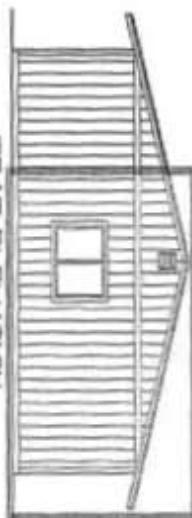

REAR ELEVATION



RIGHT SIDE ELEVATION

ADDITION TO DETACHED GARAGE
1801 QUARTER HORSE Dr. WOODSTOCK MD 21163

Google Maps 1801 Quarter Horse Dr



Map data ©2018 Google 50 ft



1801 Quarter Horse Dr
Woodstock, MD 21163

