


SCHOTT RESIDENCE 4/15/18 APPROX. 1,300 SQ.FT. (FILLISMED)

Colom 1851 172. Rosconnes 3249

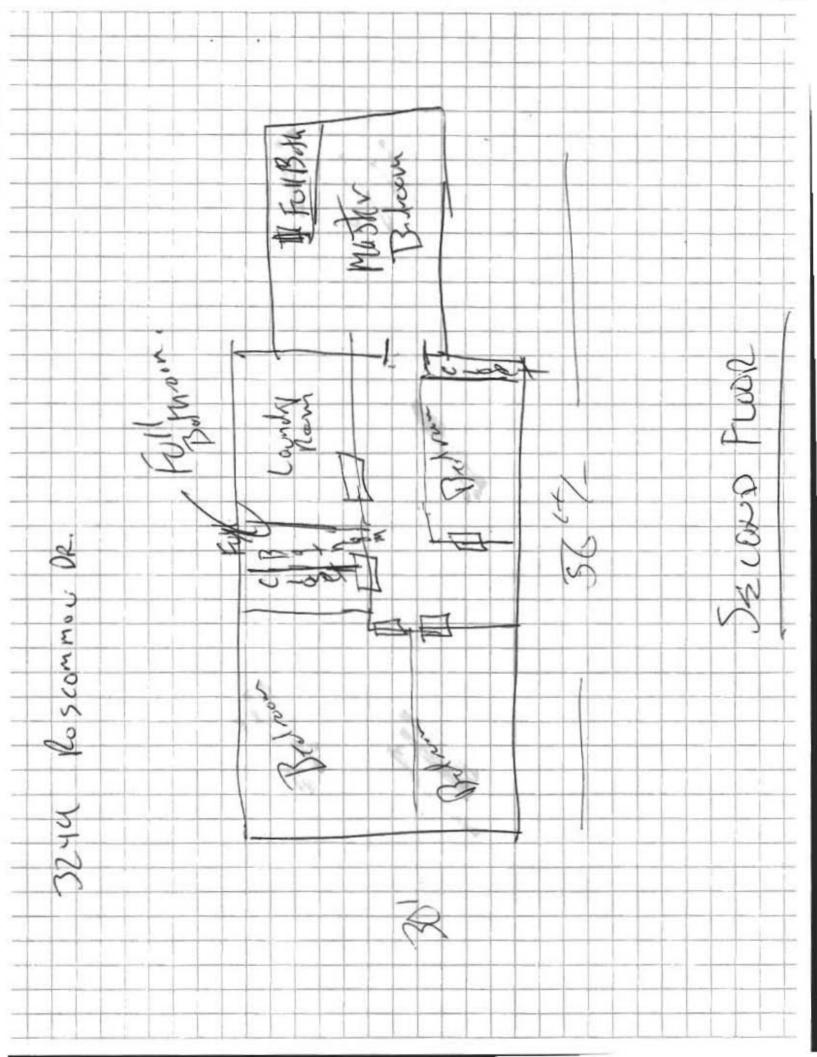

9/28/89 2016 M 03-314065

PERMIT

SEWAGE DISPOSAL SYSTEM

44706

A 40586

MARYLAND STATE DEPARTMENT OF HEALTH*

DISTRICT_6th

HOWARD COUNTY

BUREAU OF ENVIRONMENTAL HEALTH 461-9933 INDEXED

DATE SYSTEM APPROVED ----

Paul Schissler/South Carroll Backhoe, Inc.	IS PER	MITTED TO INSTALL X	ALTER
ADDRESS 4410 Salem Bottom Road, Westminster	, Maryland	PHONE875-4197	1
SUBDIVISION Roscommon Estates RO	AD 3249 Roscommon	Drive LOT 10	<u> </u>
THOTERTY OTHER	F. Contractors		1
ADDRESS DONALD	E. JARY	11'5	1.2
IF GARBAGE GRINDER IS USED INCREASE SEPTIC TANK CAPACITY	BY 50% AND ABSORPTIO	N AREA BY 22% . 1 94	w g
GARBAGE GRINDER? YES NO _X	5	720	
SEPTIC TANK CAPACITY 1250 GALLONS NUMBE	R OF BEDROOMS4_	- ' '	
TRENCHES - 180 sq. ft. per bedroom. Trend grade. Bottom maximum depth 7 at 3 feet below original grade	feet below origi	nal grade. Effect:	ive area begins
LOCATION - Start the first trench 225 feet right lot line. Run trench(s)	from the front	lot line and 140 fe	et from the
NOTE - No trench to exceed 100 feet in cap to grade or above on seption	n length. Provid	le 6" - 8" diameter	cleanout and
PLANS APPROVED BY C. Williams		DATE 10/17/	/88
COVER NO WORK UNTIL INSPECTED AND APPROVED			*1
NEITHER THE HOWARD COUNTY COUNCIL NOR THE HEALTH DEPARTMENT IS RE	SPONSIBLE FOR THE SUCCESSF	UL OPERATION OF ANY SYSTEM	
NOTE. CLEANOUT REQUIRED EVERY 70 FEET OF SEWER LINE AND/OR AT 90" S	WEEPS IN LINES FROM HOUSE T	O DRAIN FIELDS	10 90
NOTE ALL PARTS OF SEPTIC SYSTEMS ILE. TANK DISTRIBUTION BOX TRENCHES	TO BE 100 FEET FROM WELL (UI	NLESS OTHERWISE SPECIFICALLY AUT	HORIZEDI
NOTE IF DEEP TRENCHIES) ARE USED CALL FOR INSPECTION BEFORE AND AFT	ER PLACING GRAVEL IN TRENCH	H(ES)	
NOTE NO DRY WELL SHALL EXCEED 15 FOOT IN DIAMETER NO ABSORPTION T	RENCH TO EXCEED 100 FEET IN	LENGTH.	13.6
NOTE: ALL PIPE FROM HOUSE TO SEPTIC TANK MUST BE CAST IRON OR SCHED	ULE 40 PVC OR ABS	¥	1
PERMIT VOID AFTER TWO YEARS			>
MANY WARRANT STAND DISC ON SCORE TANK AND DOUBLE STAND SHOE MANY			

*INSTALLER IS RESPONSIBLE FOR OBTAINING FINAL APROVAL ON THIS PERMIT

ACCEPTED. IF TOP OF SEPTIC TANK IS DEEPER THAN 3 FEET, MANHOLE TO GRADE REQUIRED

*CALL 461-9933 FOR INSPECTION OF SEPTIC SYSTEMS.

NOTE DISTRIBUTION BOXES MUST HAVE BAFFLES

					<i>* /</i>	1
· .		A THE SECOND SEC	\$,	200 .
^		- -			Parameter of the control of the cont	Marketine de commente constitue de constitue d
150		ма <u>нкі</u>		Annual Control of the	A CONTRACTOR OF THE PROPERTY O	190
,			F		A Proposition of the Proposition	980-Average and a second and a
	well		35		one and the state of the state	1
: 1 00		90 				100
,	HO-88-0	242	HOUSE			Ching Afficiate Management of the China
	P.A. 4	B.G.			Transport of the Control of the Cont	
80	M/C 9/2	+4/).			**************************************
	OWNER'S	-BUT REP			The state of the s	The second district of
	INFORME			, And the second	Andrewski,	· ·
Same all the same and the same	And the second s	A MOKATE MONTH	NAME ADJOINING ROADS	AT AS BASE LIME		- Amazon and Complete Service
,	, 6		and the second s			
SEPTIC TANK LEVEL	500 GA		CLEANOUTS -	OK_		
DISTRIBUTION BOX. LEVE	OKB	AFFLE	- /N			,
DRAIN FIELD/TILE FIELD.	рертн <u>22/2</u>	FT TRENCH W		INLET DEPTH	33437	
EFFECTIVE GRAVEL DEPT	H	ГТ. Т	TOTAL LENGTH	<u> </u>	L 182,	!
NUMBE	R OF TRENCHES .	<u></u>	NE SIDEWALL/BOTT	IOM AREA 7	<u>28</u> so r	7 .
DRYWELL INSIDE DIAMETI	ER	F1 E	FFECTIVE DEPTH B	ELOW INLET		v
ABSOR	BENT AREA	50	i. FT.		410	L
REMARKS 7/28	289 7	29 KM) = TB	BNOT	#10	KTOCOVEY
1216 TRE	EACH	II K	£			
7/29/87	I GICH	<u>) </u>	<u> EEAL</u>	ENDS	OF TKE	HOLZSE
The state of the s	- WOK1	OK.	10 (CANTER	-100 1	touse:
<u> </u>			· · · · · · · · · · · · · · · · · · ·	*	_	-
4mmm - Assetssally (93ma governmente Ren Abyrgagermente Austrophien	anning of the second	onnangagagagagagagagagagagagagagagagagag	> 	**************************************		PhotoPVED

HOWARD COUNTY		Н	lealth Department	General Us	er Sign Out		
		Se	earch	٩			
Home Inspections People	Properties Glo	oal Search	Email Communica	tions GIS	i		
User Info 🍇 🔔 🗆	Record				ø _ =		
⇒ Health Department	Menu F	Refine Searc	ch GIS	Help	Data Filter: I		
DPZ, Health and SHA Bi Permit Review HOWARD COUNTY, ME	H < 1 + H						
	Permit#	Status	Record Type Alias	Street #	Street Nam		
Howard Count	B18000899	Review In Process	Residential Interior Alteration Single Far Dwelling Permit	3249 mily	ROSCOMN		
<>	H + 1 + H						
	<				>		
	Building Peri	nit ID: B18	000899				
	Help						
	1	ication Acce	ptance [In Possessi		9 hrs]		
	1 -	Custo a recount of	[In Possession Time: 1	and controlled the street			
	⊞ Zoning [In Possession Time: 7.37 hrs]						
	Building Permit Issuance [In Possession Time: 0 hrs]						
	🖽 🗀 Fina	Up dispelling and account.					
	⊞ 🗀 C of	С					
	There currently a	are no ad ho	c tasks defined.				

My Navigation 🗞 🕳 🗆	My Tasks				0 - D
CAP Detail/Summary Application Comments	➤ My Task Se	➤ My Task Searching			
Licensed Professionals Workflow Workflow History		Assign	Help	My Filters Seli	ect
App Spec Info Contacts Hierarchy CAP Conditions	Date 0 record(s)			Alt ID	Permi
Assess/Invoice Fees Payment Summary Attachments Assign Tasks Address Info	•				>
Parcel Info Sets Inspections Email Notification					