

Building Permit Application
Howard County Maryland
Department of Inspections, Licenses and Permits
3430 Court House Drive
Permits: 410-313-2455

Date F	Received: _		
		_	

_ Zip Code: 20759	Applicant's Name & Mailing Address, (If oth Applicant's Name: Michelle Ch. Address: Po Box 310 City: Porcy Harl State: MD Phone: 443-610-7514 Fax: Email: Michelle (DAppliedand) Contractor Company: The Deck Fe	zip Code: 20799 er than stated herein) Zip Code: 2428	
Parcel: 294	City: 40(40) State: MB Phone: Fax Email: 301-370-2016 Applicant's Name & Mailing Address, (If oth Applicant's Name: Michelle Cla. Address: Po Box 310 City: Porcy Harl State: MB Phone: 403-610-7514 Fax: Email: Michelle (D'Appliedand) Contractor Company: The Dock Fe	er than stated herein) Comparison Zip Code: 2428	
Parcel: 294	Applicant's Name & Mailing Address, (If oth Applicant's Name: Michelle Ch., Address: Po Box 310 City: Porcy Hall State: MD Phone: 443-610-7514 Fax: Email: Michelle (DAppliedand) Contractor Company: The Deck Fe	er than stated herein) OCCO Zip Code: 2428	
Parcel: 479	Applicant's Name & Mailing Address, (If oth Applicant's Name: Michelle Ch., Address: Po Box 310 City: Porcy Hall State: MD Phone: 443-610-7514 Fax: Email: Michelle (DAppliedand) Contractor Company: The Deck Fe	2ip Code: 2428	
Parcel: 479	Applicant's Name: MICHELLE CK. Address: Po Box 310 City: Pcry Hall State: MD Phone: 443-610-7514 Fax: Email: MICHELLE (DApplied and	2ip Code: 2428	
y shx TO	Address: PO BOX 310 City: Pory Hall State: MD Phone: 443-610-7514 Fax: Email: MICHELLE (DApplied and	Zip Code: 2428	
y shx TO	Email: MICHELLE (3 Applied and Contractor Company: THE DECK FE	App Code: 2428	
y shx TO	Email: MICHELLE (3 Applied and Contractor Company: THE DECK FE	Anatoural Gom	
y shx TO	Contractor Company: THE DECK - FE		
y sta to	Contractor Company: THE DECK 'FC		
Y STIX TO		nulo	
	Contact Person: W RICHARD DAW		
ecking = vinel	Address: 408 Head ounters D	or stel	
receing = vine	City: Millusulle State: MD	Zip Code: 21108	
3	License No. :125/36		
50	Phone: 416-84C . 5210 Fax:		
	Email:		
	W. Charles (1980) W. Physic		
□Yes □No	Engineer/Architect Company:		
	Responsible Design Prof.:		
	Address: COTTE-L		
	THE CONTRACT OF THE PARTY OF TH		
	City: State: Z	p Code:	
	Phone:Fax:		
	Email:		
/			
	<u>Utilities</u>		
100000000000000000000000000000000000000			
- AND AND ASSESSMENT ASSESSMENT AND ASSESSMENT ASSESSMEN	Gas: ☐ Yes ☐ No		
r.			
	Water Supply		
or:			
or: ent:	Water Supply		
or: ent: shed Basement	Water Supply ☐ Public ☐ Private		
or: ent: shed Basement inished Basement	Water Supply ☐ Public ☐ Private Sewage Disposal		
or: ent: shed Basement inished Basement wl Space	Water Supply □ Public □ Private Sewage Disposal □ Public		
or: ent: shed Basement inished Basement wl Space on Grade	Water Supply ☐ Public Sewage Disposal ☐ Public ☐ Private		
or: ent: shed Basement inished Basement wl Space	Water Supply Public Sewage Disposal Public Private Heating System		
or: ent: shed Basement inished Basement vI Space on Grade Bedrooms:	Water Supply ☐ Public Sewage Disposal ☐ Public ☐ Private		
or: ent: shed Basement inished Basement wl Space on Grade Bedrooms: Multi-family Dwelling	Water Supply Public Sewage Disposal Public Private Heating System		
or: ent: shed Basement inished Basement w/I Space on Grade Bedrooms: Multi-family Dwelling efficiency units:	Water Supply Private Sewage Disposal Public Private Heating System Electric OII		
or: ent: shed Basement inished Basement wl Space on Grade Bedrooms: Multi-family Dwelling efficiency units: 1 BR units:	Water Supply Private Sewage Disposal Public Private Heating System Electric Oil Natural Gas Propane Gas		
or: ent: shed Basement inished Basement wi Space on Grade Bedrooms: Multi-family Dwelling efficiency units: 1 BR units: 2 BR units: 3 BR units: Structure:	Water Supply Public Sewage Disposal Public Private Heating System Electric OII Natural Gas Propane Gas Other:		
or: ent: shed Basement inished Basement wl Space on Grade Bedrooms: Multi-family Dwelling efficiency units: 1 BR units: 2 BR units: 3 BR units: Structure: sions:	Water Supply Public Sewage Disposal Public Private Heating System Electric OII Natural Gas Propane Gas Other: Sprinkler System:		
or: ent: shed Basement inished Basement wi Space on Grade Bedrooms: Multi-family Dwelling efficiency units: 1 BR units: 2 BR units: 3 BR units: Structure:	Water Supply Private Sewage Disposal Public Private Heating System Electric Oil Natural Gas Propane Gas Other: Sprinkler System: Yes No		
or: ent: shed Basement inished Basement wl Space on Grade Bedrooms: Multi-family Dwelling efficiency units: 1 BR units: 2 BR units: 3 BR units: 5tructure: sions: gs:	Water Supply Public Sewage Disposal Public Private Heating System Electric OII Natural Gas Propane Gas Other: Sprinkler System:		
or: ent: shed Basement inished Basement wl Space on Grade Bedrooms: Multi-family Dwelling efficiency units: 1 BR units: 2 BR units: 3 BR units: Structure: sions:	Water Supply Private Sewage Disposal Public Private Heating System Electric Oil Natural Gas Propane Gas Other: Sprinkler System: Yes No		
	□Yes □No Zip Code: ential Building Characteristics welling □ SF Townhouse Depth Width	Phone: 410-840-5310 Fax: Email: Phone: 410-840-5310 Fax: Email:	

Checks Payable to: DIRECTOR OF FINANCE OF HOWARD COUNTY

PLEASE WRITE NEATLY & LEGIBLY

-FOR OFFICE USE ONLY-

AGENCY	DATE	SIGNATURE OF APPROVAL
State Highways		
Bullding Officials		
PSZA (Zoning)		
PSZA (Engineering)	- /	1 0
Health	8/22	BEBURG.

DPZ SETBACK INFORMATION		
Front:		
Rear:		
Side:		
Side St.:		
All minimum setbacks met?	☐ Yes	□No
Is Entrance Permit Required?	☐ Yes	□No
Historic District?	☐ Yes	□Nó
Lot Coverage for New Town Z	one:	
SDP/Red-line approval date:		

Filing Fee	\$
Permit Fee	\$
Tech Fee	\$
Excise Tax	\$
PSFS	\$
Guaranty Fund	5
Add'l per Fee	\$
Total Fees	\$
Sub- Total Paid	\$
Balance Due	\$
Check	

Distribution of Copies: White: Building Officials


Title/Company

Green: PSZA,Zoning

Yellow: PSZA,Engineering

Pink: Health

Gold: SHA

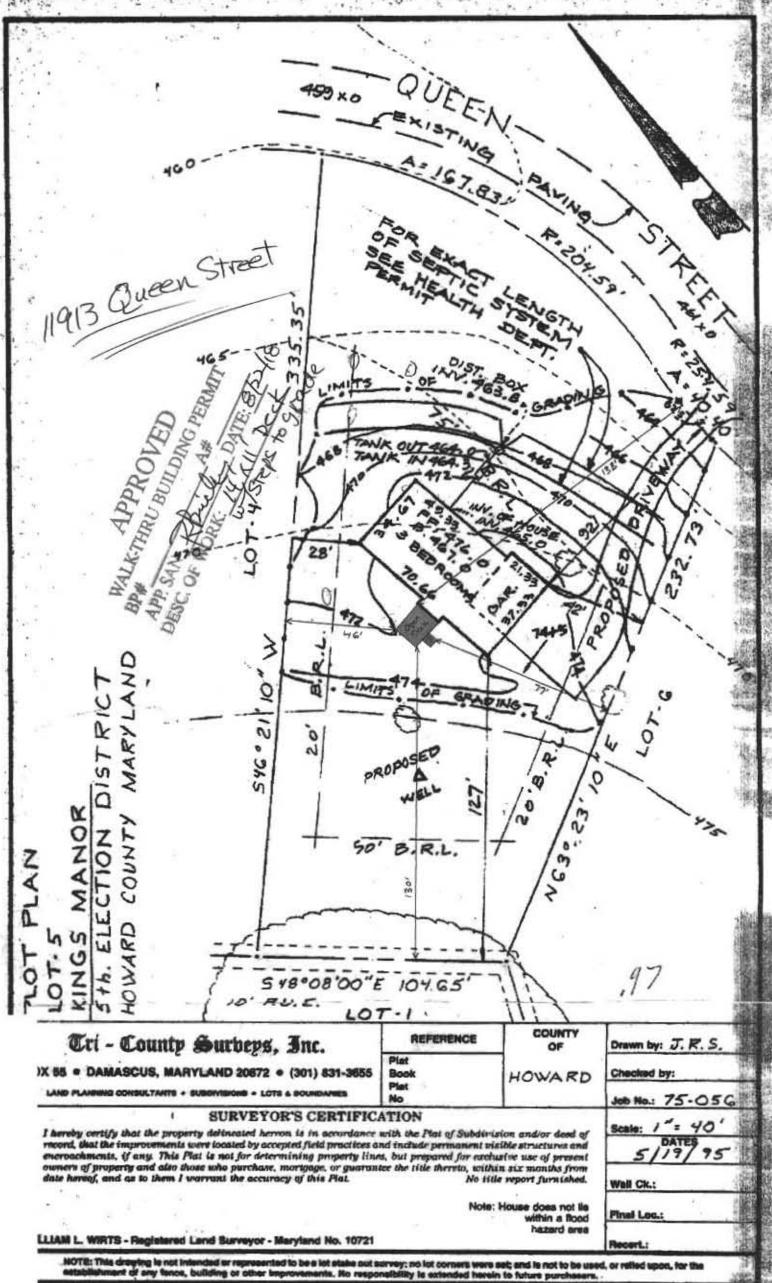

PHC 301-005-3540