

Building Permit Application
Howard County Maryland

Date Received:	

repartment of Inspections, Licenses and Permits	
3430 Court House Drive	
Permits: 410-313-2455	
www.howardcountyrnd.gov	Permit N


Jeff + Anne Brown state: MD zip Code: 21797 State: MD zip Code: 21797 g Address, (If other than stated herein) sen hume (CC Oy Lane State: MD zip Code: 21738 Fax: Prosen Howes LC 2 crosen Ly Cune State: MD zip Code: 21738 Fax: Ton Butts Incord Count State: MD zip Code: 21234 State: MD zip Code: 21234
g Address, (If other than stated herein) Sen Hume (LC Oy Love State: MD zip Code: 21738 Fax: POSENHOMES. COM Crosen Houses LLC E Crosen Edy Cune State: MD zip Code: 21738 Fax: TON Butts Incord Count State: MD zip Code: 21234
g Address, (If other than stated herein) Sen Nome (CC Oy Love State: MD zip Code: 21738 Fax: Mosenhomes. com Crosen Homes LLC E Grosen Edy Cune State: MD zip Code: 21738 Fax: Ton Butts Incord Count State: MD zip Code: 21234
g Address, (If other than stated herein) sen Nome (CC Sen Nome (CC Oy Lave State: ND zip Code: 21738 Fax: Crosen Houses LLC E crosen Ly Cune State: MD zip Code: 21738 Fax: MD zip Code: 21738 Fax: MD zip Code: 21738 Ton Butts State: MD zip Code: 21234
Erosen Howes LLC E Crosen Exp Cume State: MD zip Code: 21738 Fax: ** Ton Butts Incord Count State: MD zip Code: 21234
Erosen Howes LLC E Crosen Exp Cure State: MD zip Code: 21738 Fax: ** Ton Butts Incord Count State: MD zip Code: 21234
Erosen Howes LLC E Crosen Exp Cure State: MD zip Code: 21738 Fax: ** Ton Butts Incord Count State: MD zip Code: 21234
Erosen Howes LLC E Crosen Exp Cume State: MD zip Code: 21738 Fax: ** Ton Butts Incord Count State: MD zip Code: 21234
Erosen Howes LLC E Crosen Exp Cume State: MD zip Code: 21738 Fax: ** Ton Butts Incord Count State: MD zip Code: 21234
Erosen Howes LLC E Crosen Edy Cune State: MD zip Code: 21738 Fax: ** Ton Butts Incord Count State: MD zip Code: 21234
e crosen Loly Cune State: MD zip Code: 21738 Fax: 103264 Fax: 10 Design LLC Ton Butts Incord Count State: MD zip Code: 21234
State: MD zip Code: 21738 Fax: Design LLC Jon Butts state: MD zip Code: 21234
State: MD zip Code: 21738 Fax: ** Ton Butts Incord Count State: MD zip Code: 21234
Ton Butts State: MD zip Code: 21234
any: JB Home Design LLC Jon Butts uncond Count State: MD zip Code: 21234
Ton Butts uncoud Count State: MD zip code: 21234
Jon Butts encoud Count state: MD zip code: 21234
Jon Butts encoud Count state: MD zip code: 21234
state: MD zip code: 21234
state: MD zip code: 21234
State: MD Zip Code: 21234
1064 Fax:
BHomedesign com
DNe
□ No
□ No
ylag
posal
stem
opane Gas
rstem:
Permit Number:

State Highways **Building Officials** PSZA (Zoning) PSZA (Engineering) 8/23/18/ RBick Health

Trong transfer and	-	\sim \sim		July 1	-
Is Sediment Control app	roval rec	uired to	rissua	nce? TYe	S E No
CONTINGENCY CONS	TRUCTIO	N START			

Front:		
Rear:		
Side:		
Side St.:		
All minimum setbacks met?	☐ Yes	□No
Is Entrance Permit Required?	☐ Yes	□No
Historic District?	☐ Yes	□No
Lot Coverage for New Town Z	onei	
SDP/Red-line approval date:		

Filing Fee	\$
Permit Fee	\$
Tech Fee	\$
Excise Tax	\$
PSFS	\$
Guaranty Fund	\$
Add'I per Fee	\$
Total Fees	\$
Sub- Total Paid	\$
Balance Due	\$
Check	#

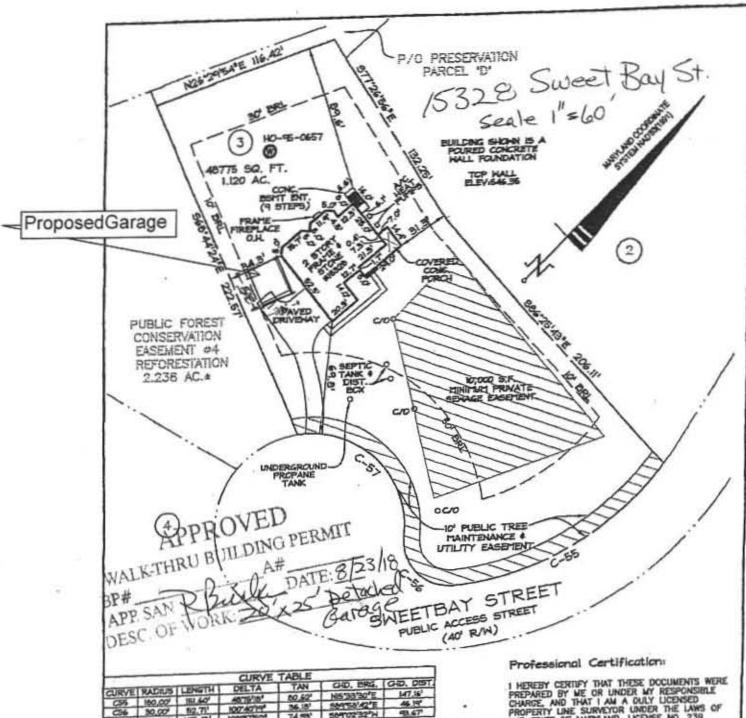

			CURVE	TABLE	DOT THE WAR	
-	-	I WANTED I	THE RESERVE OF THE PERSON NAMED IN	TAN	CHD, ERG.	CHD, DIST
CURVE	RALIND	LENGTH	constitut.	BO 52"	NIS'38'30'E	147,16
C55	160,00	181,642	AO TH' ID	25.181	GAOSSIAN'E	46.19"
C56	30,00	52,71	100740719	36.10	eagyrolagile	43.67
C57	60.00	107.46	102'37'52"	74,73	56405,35,M	

- THIS PLAT IS OF BENEFIT TO A CONSUMER ONLY INSOFAR AS IT IS REQUIRED BY A LENDER OR A TITLE INSURANCE COMPANY OR ITS AGENT IN CONNECTION WITH CONTEMPLATED TRANSFER, FINANCING OR
- THIS PLAT IS NOT TO BE RELIED UPON FOR THE ESTABLISHMENT OR LOCATION OF FENCES, DARAGES, BUILDINGS, OR OTHER EXISTING OR FUTURE IMPROVEMENTS.
- THIS PLAT DOES NOT PROMDE FOR THE ACCURATE IDENTIFICATION OF PROPERTY BOUNDARY LINES, BUT THIS IDENTIFICATION WAY NOT BE REQUIRED, FOR THE TRANSFER OF TITLE OR SECURING FINANCING OR DESCRIPTION.
- THE ACCURACY OF THE APPARENT SETBACK DIMENSIONS FROM THE PROPERTY LINES TO THE MERCUEMENTS IS WITHIN 1 FOOT OF BEING GREATER THAN OR LESS THAN THE DIMENSIONS SHOWN.
- THE SUBJECT PROPERTY LIES WITHIN FLOOD ZONE "C"
 (AREAS OF MINIMAL FLOODING) AS SHOWN ON FLOOD
 INSURANCE RATE MAP NO.240044 0014B, DATED 12-4-B6.

I HEREBY CERTIFY THAT THESE DOCUMENTS WERE PREPARED BY WE OR UNDER MY RESPONSIBLE CHARGE, AND THAT I AM A DULY LICENSED PROPERTY LINE SURVEYOR LIMBER THE LAWS OF THE STATE OF MARYLAND, LICENSE NO. 239, SYPPATION OF THE TABLE O EXPIRATION DATE 7/8/12.

SURVEYOR'S CERTIFICATE

I HEREBY CERTIFY THAT I EITHER PERSONALLY PREPARED OR WAS IN RESPONSIBLE CHARGE OVER THE PREPARATION OF THIS DRAWING AND THE SURVEYING WORK REFLECTED IN IT, AND THAT IT IS IN COMPLIANCE WITH REDULATION 52 FORTH IN REGULATION .12 OF CHAPTER 05, MINIMUM STANDARDS OF PRACTICE.





Espineers Landscape Architects

192 East Hain Street Westwisster, MD 21157 418,384,0560

LOCATION DRAWING

DDC JOB#:

06116.4