



APPLICATION

FOR PERCOLATION TESTING AND SITE EVALUATION

TEST DATE(S) _____ TEST TIME _____

AP 520108-X

AGENCY REVIEW: _____

DATE _____

DO NOT WRITE ABOVE THIS LINE

I HEREBY APPLY FOR THE NECESSARY TESTING/EVALUATION PRIOR TO ISSUANCE OF SEWAGE DISPOSAL SYSTEM PERMIT(S) TO:

CHECK AS NEEDED:

- ☒ CONSTRUCT NEW SEPTIC SYSTEM(S)
☐ REPAIR/ADD TO AN EXISTING SEPTIC SYSTEM
☐ REPLACE AN EXISTING SEPTIC SYSTEM

CHECK AS NEEDED:

- ☒ NEW STRUCTURE(S)
☐ ADDITION TO AN EXISTING STRUCTURE
☐ REPLACE AN EXISTING STRUCTURE

CHECK ONE:

- ☒ CREATE NEW LOT(S)
☐ BUILD ON AN EXISTING LOT IN A SUBDIVISION
☐ BUILD ON AN EXISTING PARCEL OF RECORD

IS THE PROPERTY WITHIN 2500' OF ANY RESERVOIR?

- ☐ YES
☒ NO

THE TYPE OF STRUCTURE IS:

- ☒ RESIDENTIAL WITH UNKNOWN PROPOSED BEDROOMS IN THE COMPLETED STRUCTURE (NOTE UNKNOWN IF APPROPRIATE)
☐ COMMERCIAL (PROVIDE DETAIL OF NUMBERS AND TYPES OF EMPLOYEES/ CUSTOMERS ON ACCOMPANYING PLAN)
☐ INSTITUTIONAL/GOVERNMENT (PROVIDE DETAIL OF NUMBERS AND TYPES OF EMPLOYEES/USERS ON ACCOMPANYING PLAN)

PROPERTY OWNER(S) LDCI Inc. J Lee Plaza

DAYTIME PHONE 301-585-7000 CELL _____ FAX _____

MAILING ADDRESS 8601 Georgia Ave. Silver Spring MD 20910
STREET CITY/TOWN STATE ZIP

APPLICANT VanMar Associates Inc.

DAYTIME PHONE 301-829-2890 CELL _____ FAX _____

MAILING ADDRESS 310 South Main St. Mount Airy MD 21771
STREET CITY/TOWN STATE ZIP

APPLICANT'S ROLE: DEVELOPER BUILDER BUYER RELATIVE/FRIEND REALTOR CONSULTANT

PROPERTY LOCATION
SUBDIVISION/PROPERTY NAME Schwabe Farms LOT NO. 25

PROPERTY ADDRESS MD Route 32 West Friendship 21794
STREET TOWN/POST OFFICE

TAX MAP PAGE(S) 15 GRID 5 PARCEL(S) 12 PROPOSED LOT SIZE 1AC±

AS APPLICANT, I UNDERSTAND THE FOLLOWING: THE SYSTEM INSTALLED SUBSEQUENT TO THIS APPLICATION IS ACCEPTABLE ONLY UNTIL PUBLIC SEWERAGE IS AVAILABLE. THIS APPLICATION IS COMPLETE WHEN ALL APPLICABLE FEES AND A SUITABLE SITE PLAN HAVE BEEN RECEIVED. I ACCEPT THE RESPONSIBILITY FOR COMPLIANCE WITH ALL M.O.S.H.A. AND "MISS UTILITY" REQUIREMENTS. APPROVAL IS BASED UPON SATISFACTORY REVIEW OF A PERC CERTIFICATION PLAN.

TEST RESULTS WILL BE MAILED TO APPLICANT.

Daniel Stolt
SIGNATURE OF APPLICANT


HOWARD COUNTY HEALTH DEPARTMENT, BUREAU OF ENVIRONMENTAL HEALTH, WELL AND SEPTIC PROGRAM
3525-H ELLICOTT MILLS DRIVE, ELLICOTT CITY, MARYLAND 21043-4544 (410) 313-1771 FAX (410) 313-2648
TDD (410) 313-2323 TOLL FREE 1-877-4MD-DHMH

AP

618
Brown L w/
gravelly Qtz 1 1/2'
Brown/orange
micaceous
Scl 4 1/2'
Red/orange
yellow micaceous
Scl w/
10% cherty Qtz 7'
Yellow/Brown
S
trace Rock 11'

619
Brown L
orange/Brown
micaceous
Scl
Brown/Red
micaceous scl
Yellow/Brown
micaceous Scl
w/ 10%
micaceous
Scl 10'

624
Brown
L
Brown/micaceous
Scl 4'
Brown/Scl
w/ trace
Rock 8'
Yellow/Brown
S
trace
Rock 10'

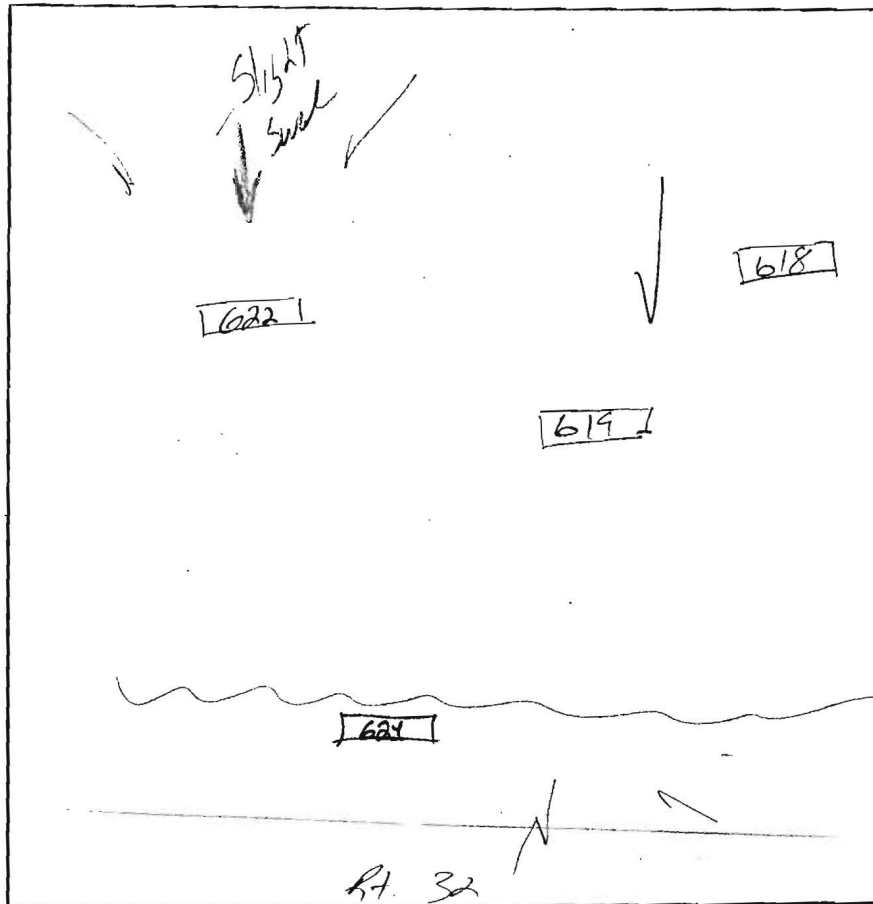

622
Brown L
Red/orange
micaceous
Scl 4'
Yellow/Brown
micaceous
Scl 9 1/2'-10'
Yellow/Brown
S
- trace
Rock - 11'

DATE	TEST #	DEPTH	START	BREAK 1" DROP	STOP 2" DROP	TIME OF 2ND INCH	P/F/H
7/16/04	618	5 1/2' / 11'	1:40	1:51	2:12	22min	P
	619	10' - Visual -					OK
	624	4 1/2' / 10'	1:45	1:49	1:56	7min	P
	622	4' / 11'	2:02	2:05	2:09	4min	P

REMARKS all holes dug per plan

SANITARIAN KJB BACKHOE Justin OTHERS Zak

TEST HOLES USED IN SDA AVG. PERC TIME SQ. FT/BR

TRENCH WIDTH INLET DEPTH MAX. BOT DEPTH EFFECTIVE SW

A/P _____

617


Brown L	1'
Brown/Orange Red micaceous Scl	3'
Red/Orange Scl	6 1/2'
Yellow/Brown gray micaceous SI	9'
Yellow/Brown S	10'
trace Red	

615

Brown L	1'
Red/brown micaceous SICI	4 1/2'
Yellow/Orange Brown SI w/ trace Red	
Water	11'

616

Brown L	1'
Red/Brown micaceous Scl	4 1/4'
Brown/Yellow Orange micaceous SI	9'
Yellow/Brown S w/ trace Red	11'

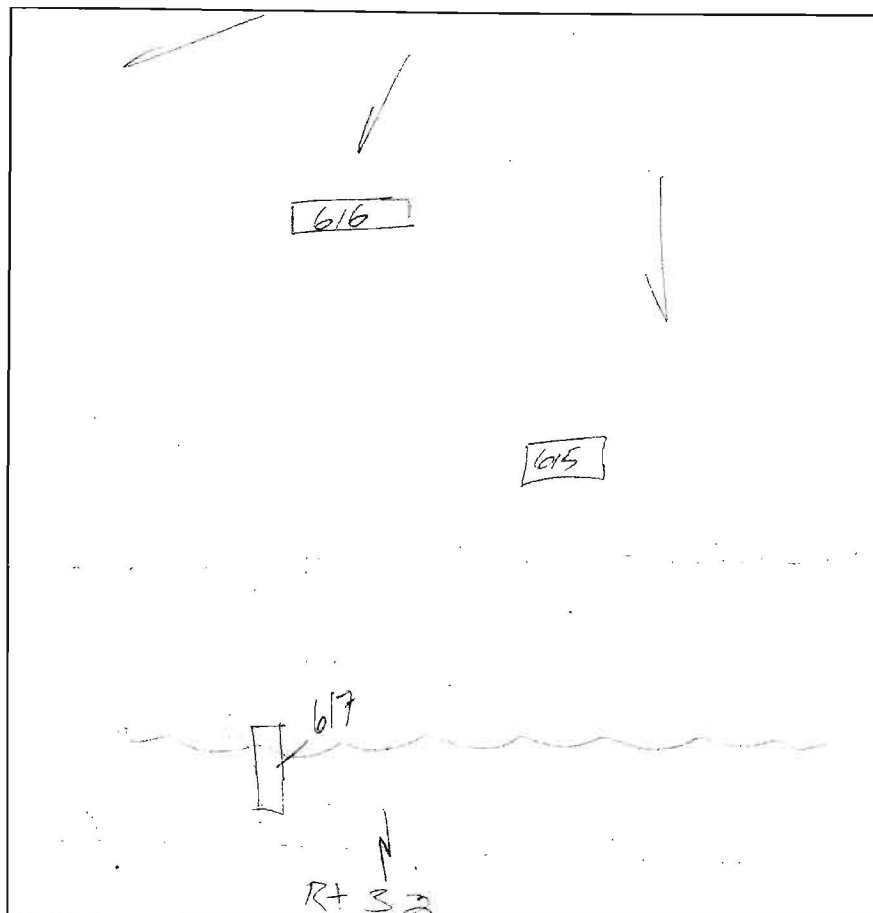

DATE	TEST #	DEPTH	START	BREAK 1" DROP	STOP 2" DROP	TIME OF 2ND INCH	P/F/H
7/16/04	617	5 1/2' / 10'	12:06	Polled	12:45	Slow	F
	615	11'	Visual			OK	P
	616	5' / 11'	1:23	1:28	1:36	8min	P
Re-test	617	6 1/2' / 10'	12:54	1:07	1:24	17min	P

REMARKS # 615 + 616 - Almost identical

SANITARIAN KJB BACKHOE Justin OTHERS Zach

TEST HOLES USED IN SDA _____ AVG. PERC TIME _____ SQ. FT/BR _____

TRENCH WIDTH _____ INLET DEPTH _____ MAX. BOT DEPTH _____ EFFECTIVE SW _____

